




REV	DATE	BY
0 - REVISED SINCE BID	03-04-09	SPT
1 - RECORD DRAWING	04-16-10	

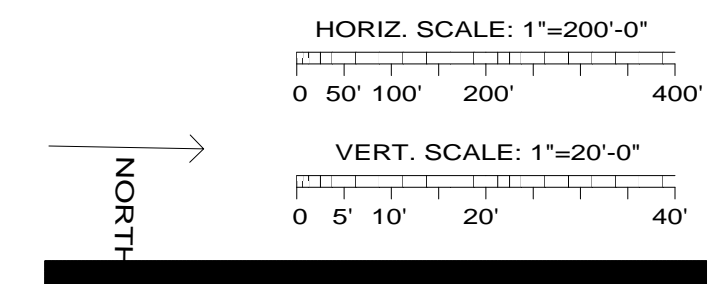


STATION	DESCRIPTION
STA=0+00.00	WF-HLK-SUB
1	STA=0+90.84 2-60/H3 WF-DCDE-XARM-2 10%+5' EMBED WF-GND WF-EMBD TM-16
2	STA=2+75.54 1-65/H1 WF-DCTAN 10%+5' EMBED WF-GND WF-EMBD, CULVERT TM-16
3	STA=4+39.70 1-60/H2 WF-DCTAN 10%+4' EMBED WF-GND WF-EMBD TM-16
4	STA=6+11.87 1-60/H3 WF-DCTAN 10%+4' EMBED WF-GND WF-EMBD TM-16
5	STA=8+58.67 1-60/H2 WF-DCTAN 10%+4' EMBED WF-GND WF-EMBD TM-16
6	STA=10+73.35 2-45/H3 WF-DCTAN-XARM 10%+5' EMBED WF-GND WF-EMBD, CULVERT TM-16
7	STA=12+15.43 2-40/H1 WF-DCANG-XARM 10%+5' EMBED WF-GND WF-EMBD TM-16
8	STA=13+08.35 WF-DCTAN-XARM 10%+6' EMBED WF-GND WF-EMBD, CULVERT TM-16
9	STA=14+37.24 2-40/H1 WF-DCANG-XARM WF-GND WF-EMBD TM-16
10	STA=15+46.60 2-40/H3 WF-DCTAN-XARM 10%+5' EMBED WF-GND WF-EMBD TM-16
11	STA=16+54.34 2-40/H1 WF-DCANG-XARM WF-GND WF-EMBD TM-16
12	STA=18+04.36 2-40/H3 WF-DCANG-XARM 10%+5' EMBED WF-GND WF-EMBD TM-16
13	STA=19+79.83 1-55/H2 WF-DCTAN 10%+4' EMBED WF-GND WF-EMBD TM-16
14	STA=22+12.92 1-60/H3 WF-DCTAN 10%+5' EMBED WF-GND WF-EMBD TM-16

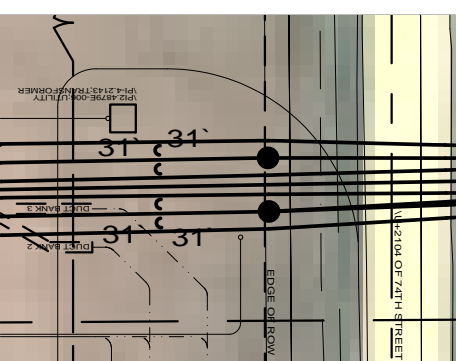


GUY DETAIL STR 1

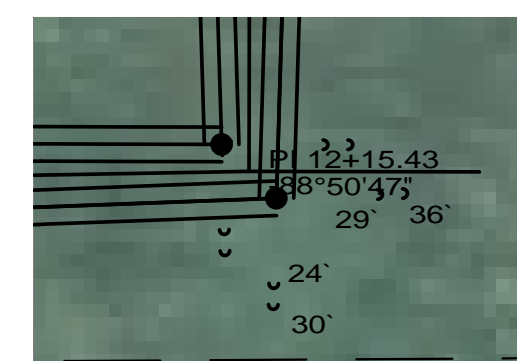


GUY DETAIL STR 7

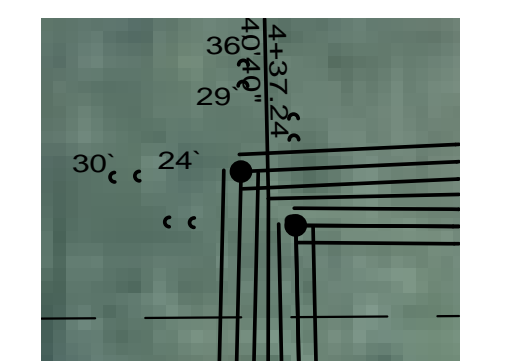

GUY DETAIL STR 9

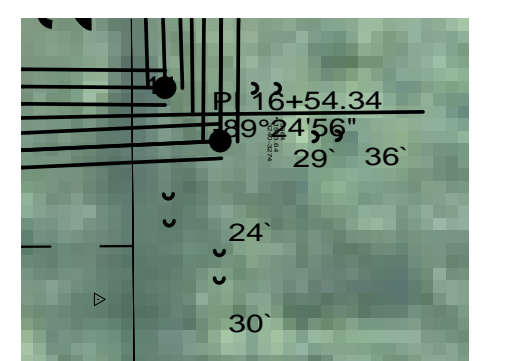

GUY DETAIL STR 11

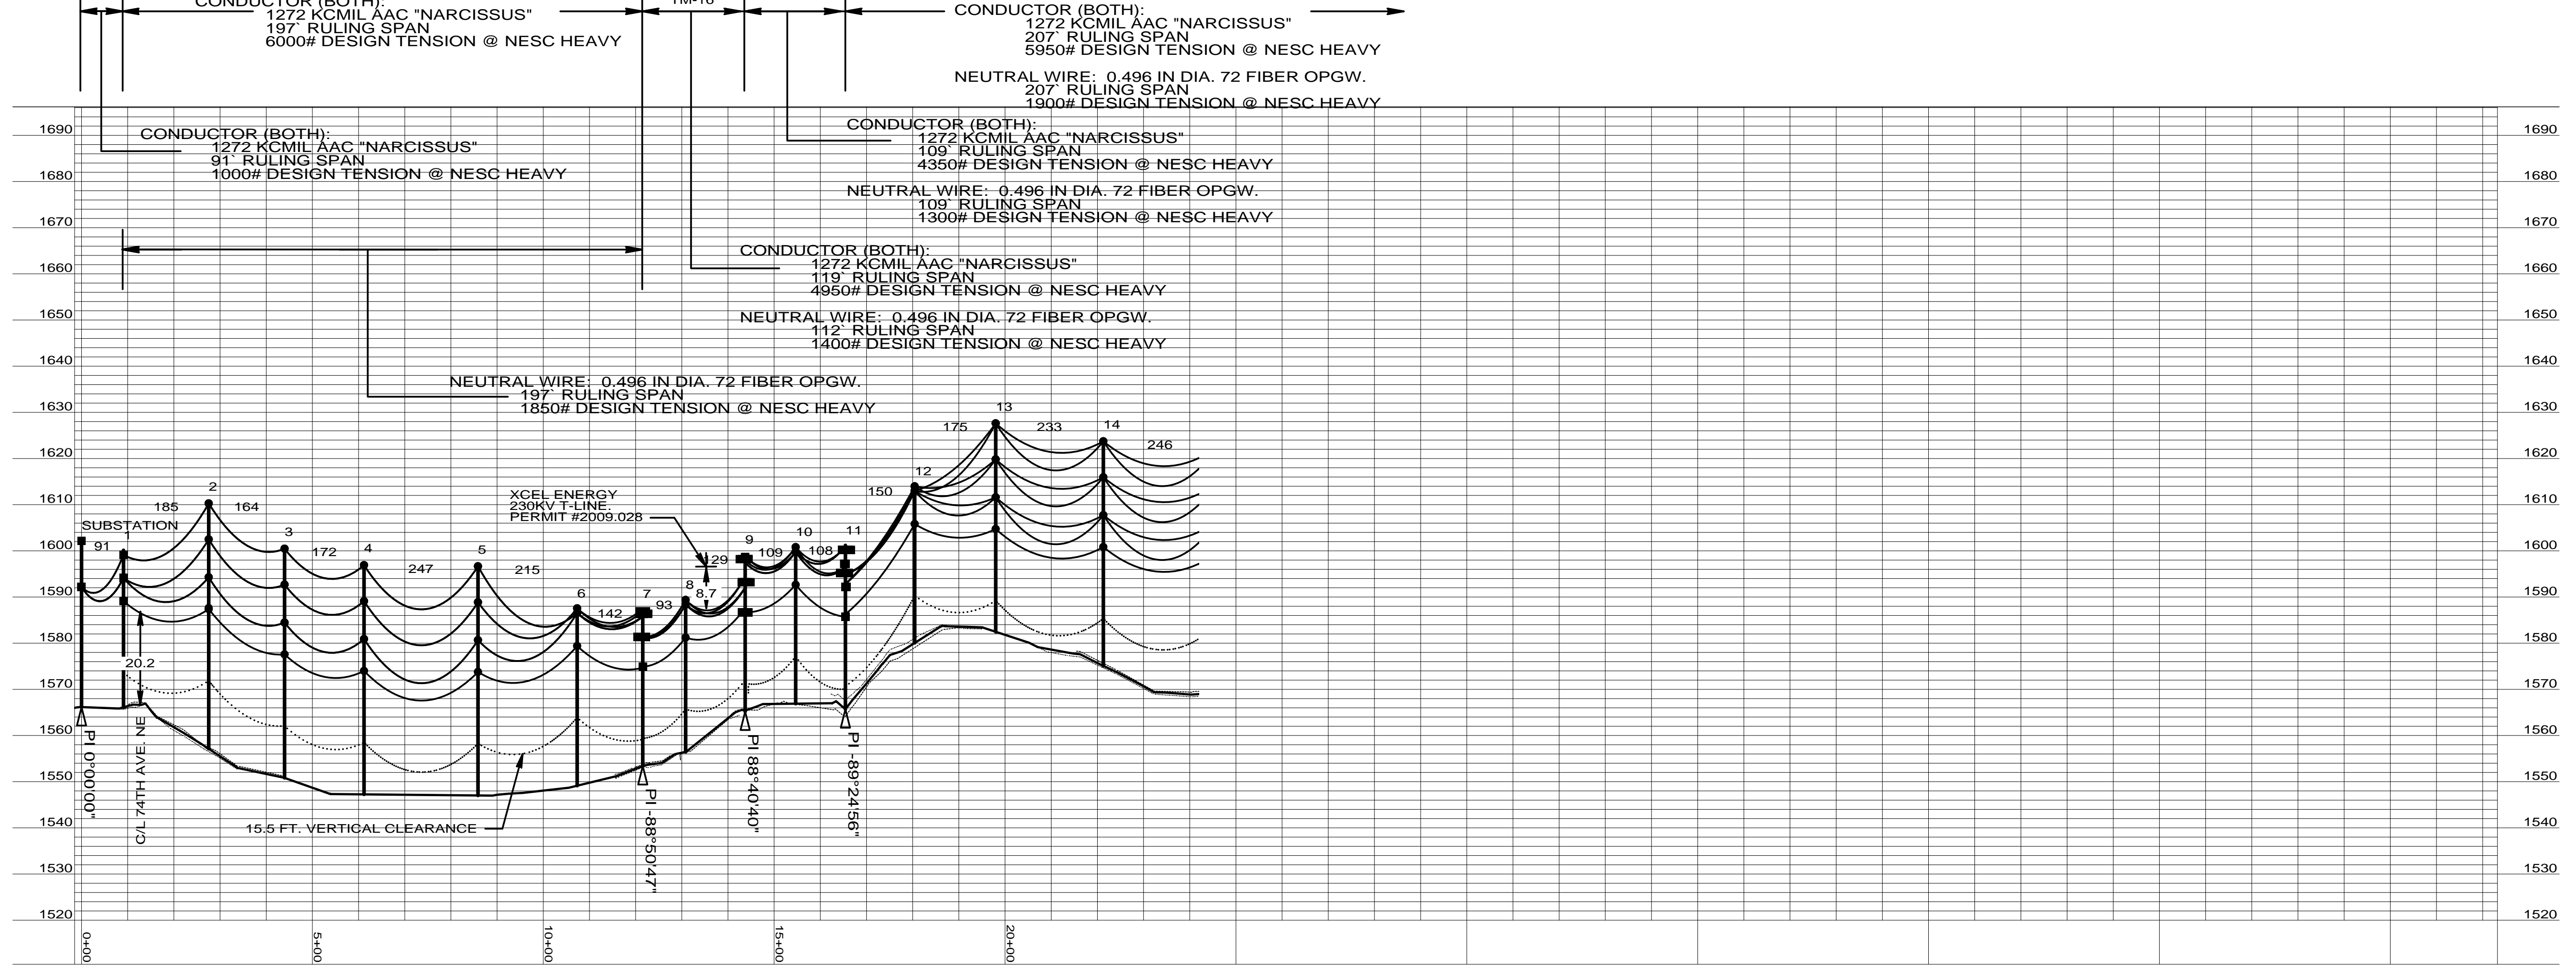

5201 EAST RIVER ROAD, SUITE 308
MINNEAPOLIS, MINNESOTA 55421
PHONE: 763.571.2500 FAX: 763.571.1168
WEB: WWW.ULTEIG.COM
DRAWN BY: NGK
CHECKED BY: MPM
APPROVED BY: SPT

**RUGBY 34.5KV
TRANSMISSION LINE
PLAN AND PROFILE**

PROJECT NUMBER: 108.0495
DATE CREATED: DECEMBER 3, 2008
DWG NO: RUG-E-511-01