


Rev	Date	By
0 - REVISED SINCE BID	03-04-09	SPT
1 - STR #82 & 83 MOVE	05-15-09	SPT
2 - RECORD DRAWING	04-16-10	



41 Sta=250+74.64 2-85/2 HF-TAN GND DETAILS EMBED TM-16	42 Sta=258+43.94 2-85/2 HF-TAN GND DETAILS EMBED TM-16	43 Sta=265+34.55 2-80/2 HF-TAN GND DETAILS EMBED TM-16	44 Sta=272+23.42 2-80/2 HF-TAN GND DETAILS EMBED TM-16	45 Sta=278+84.76 2-80/2 HF-TAN GND DETAILS EMBED TM-16	46 Sta=284+40.18 3-70/H1 3P-DE GND DETAILS EMBED TM-16 DAMPER (11)GUYING A,B,C	47 Sta=290+57.02 2-80/2 HF-TAN GND DETAILS EMBED TM-16
--	--	--	--	--	--	--

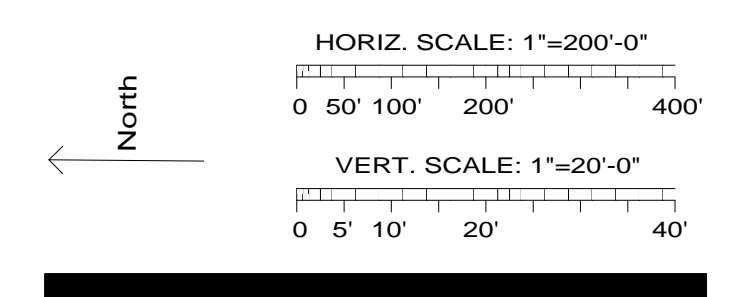

Bismarck-Denver-Detroit Lakes-Fargo-Minneapolis-Sioux Falls
 5201 East River Road, Suite 308
 Minneapolis, Minnesota 55421
 Phone: 763.571.2500 Fax: 763.571.1168
 Web: www.ultieg.com
 Drawn By: NGK
 Checked By: MPM
 Approved By: SPT

**RUGBY 230kV
 TRANSMISSION LINE
 PLAN AND PROFILE**

Project Number: 108_0495
 Date Created: December 3, 2008
 Dwg No: **RUG-E-515-06**