


LEGEND	
	WIND TURBINE
	OH CIRCUIT #1
	OH CIRCUIT #2
	UG CIRCUIT #1
	OH COLLECTION
	MET/SODAR POWER
	MET/SODAR
	J-BOX
	ACCESS ROADS
	NO-GO AREAS
	JURIS(FWS) WETLANDS
	JURIS(USACE) WETLANDS
	NONJURIS WETLANDS



Rev	Date	By
B	75% REVIEW	12/04/08 GLZ
C	99% REVIEW	01/07/09 GLZ
0	ISSUED FOR CONSTRUCTION	01/22/09 KWM
1	RECORD DRAWING	04/16/10 KWM
2	RECORD DRAWING	05/25/10 KWM

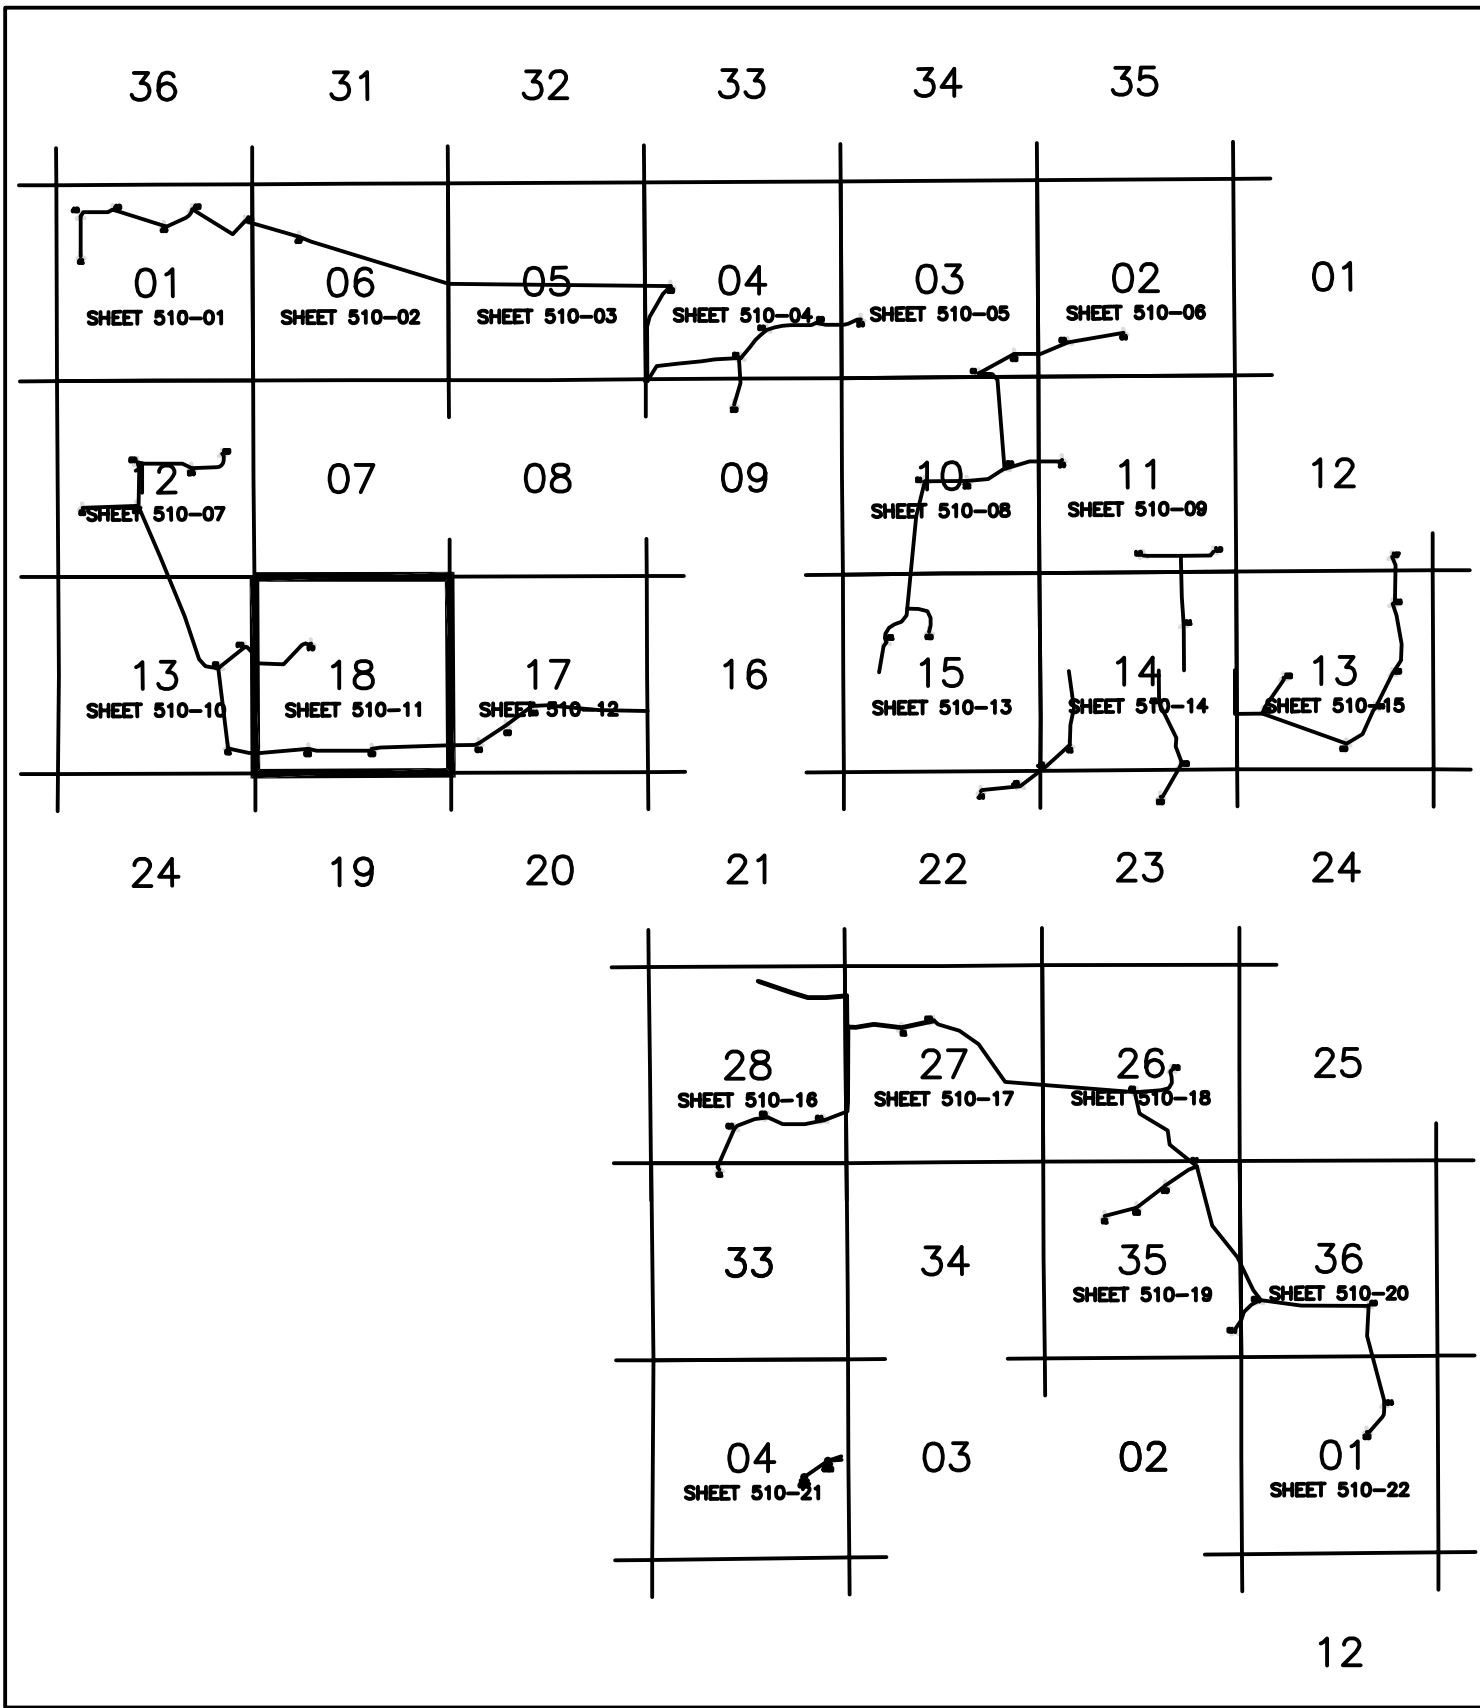

Bismarck - Denver - Detroit Lakes - Fargo - Minneapolis - Sioux Falls
4776 28th Avenue South
Fargo, ND 58104
Phone: 701.451.8300 Fax: 701.451.8301
Web: www.ultei.com
Drawn By:
Checked By:
Approved By:

RUGBY WIND PROJECT
SECTION 18, T158N, R72W

Project Number: 108.0495
Date Created: October 29, 2009
Dwg No: RUG-E-510-11.DWG