


LEGEND	
	WIND TURBINE
	OH CIRCUIT #1
	OH CIRCUIT #2
	UG CIRCUIT #1
	OH COLLECTION
	MET/SODAR POWER
	MET/SODAR
	J-BOX
	ACCESS ROADS
	NO-GO AREAS
	JURIS(FWS) WETLANDS
	JURIS(USACE) WETLANDS
	NONJURIS WETLANDS



Rev	Date	By
A	ISSUED FOR REVIEW	10/27/08 GLZ
B	75% REVIEW	12/04/08 GLZ
C	99% REVIEW	01/07/09 GLZ
0	ISSUED FOR CONSTRUCTION	01/22/09 KWM
1	RECORD DRAWING	04/16/10 KWM

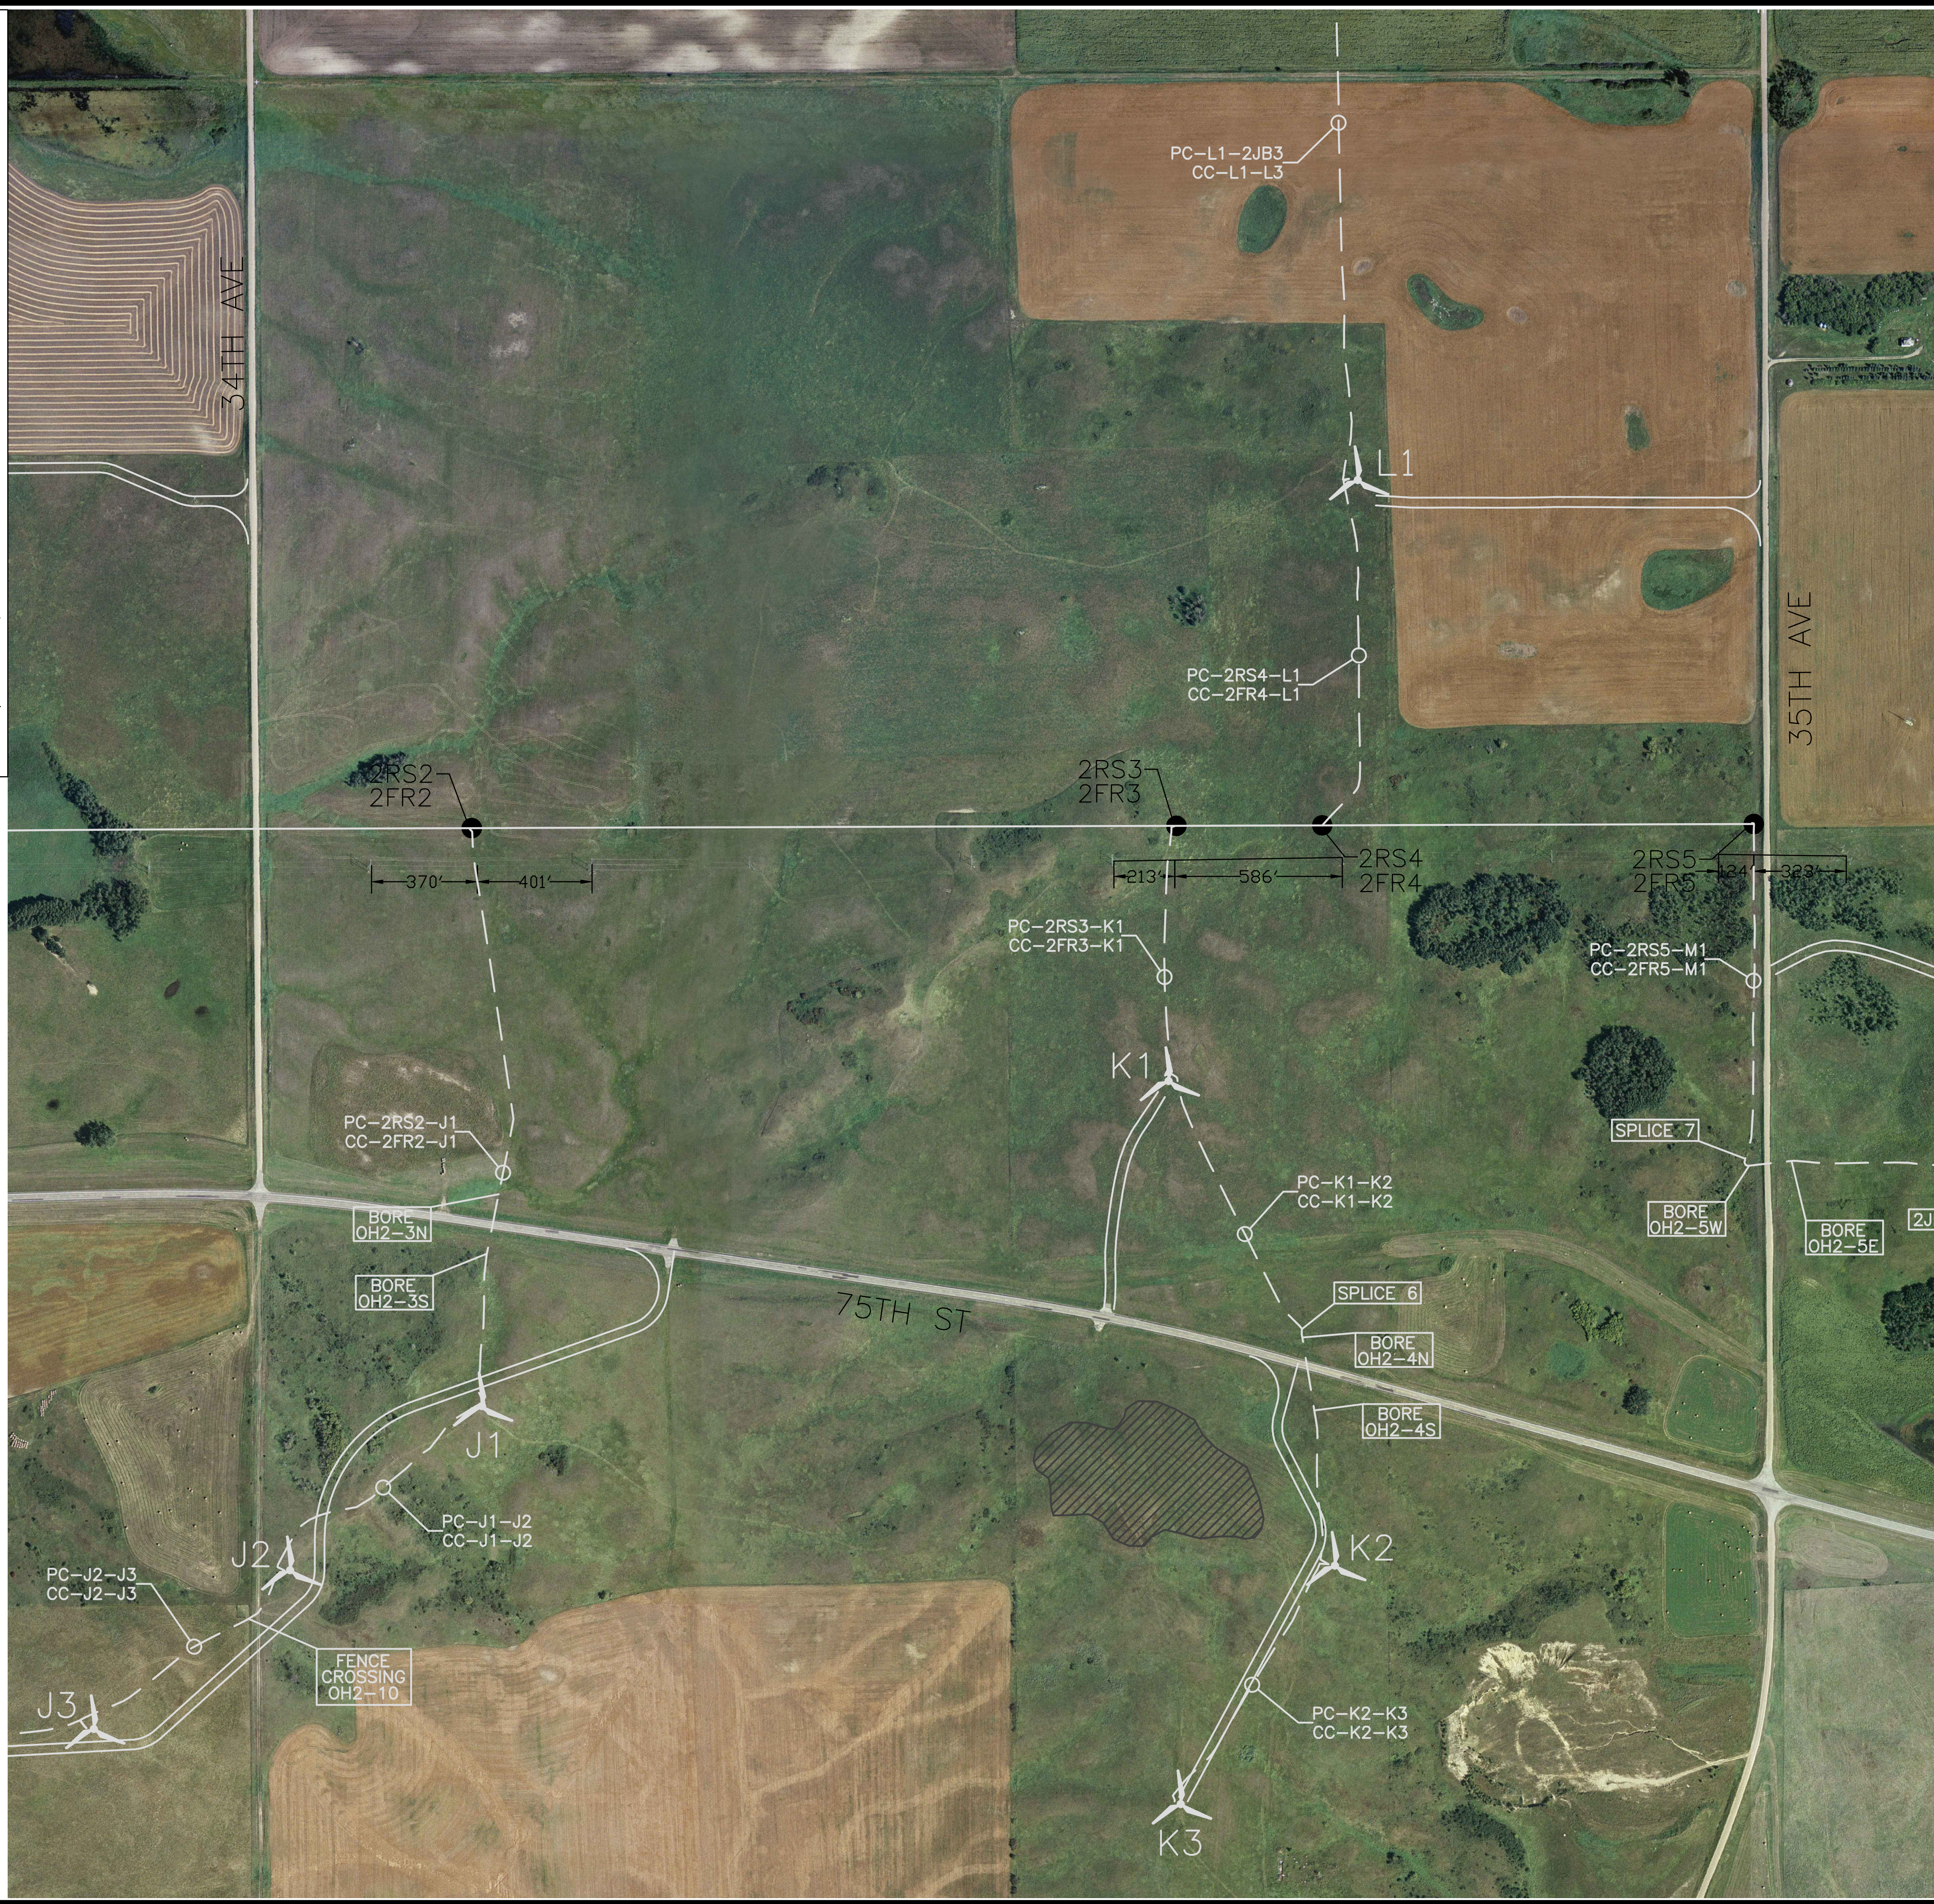

Bismarck - Denver - Detroit Lakes - Fargo - Minneapolis - Sioux Falls
 4776 29th Avenue South
 Fargo, ND 58104
 Phone: 701.451.8300 Fax: 701.451.8301
 Web: www.ulteig.com
 Drawn By:
 Checked By:
 Approved By:

RUGBY WIND PROJECT
SECTION 14, T158N, R72W

Project Number: 108.0495
 Date Created: October 29, 2009
 Dwg No: **RUG-E-510-14.DWG**