


| LEGEND |                       |
|--------|-----------------------|
|        | WIND TURBINE          |
|        | OH CIRCUIT #1         |
|        | OH CIRCUIT #2         |
|        | UG CIRCUIT #1         |
|        | OH COLLECTION         |
|        | MET/SODAR POWER       |
|        | MET/SODAR             |
|        | J-BOX                 |
|        | ACCESS ROADS          |
|        | NO-GO AREAS           |
|        | JURIS(FWS) WETLANDS   |
|        | JURIS(USACE) WETLANDS |
|        | NONJURIS WETLANDS     |



| Rev | Date                    | By           |
|-----|-------------------------|--------------|
| A   | ISSUED FOR REVIEW       | 10/27/08 GLZ |
| B   | 75% REVIEW              | 12/04/08 GLZ |
| C   | 99% REVIEW              | 01/07/09 GLZ |
| O   | ISSUED FOR CONSTRUCTION | 01/22/09 KWM |
| 1   | RECORD DRAWING          | 04/16/10 KWM |

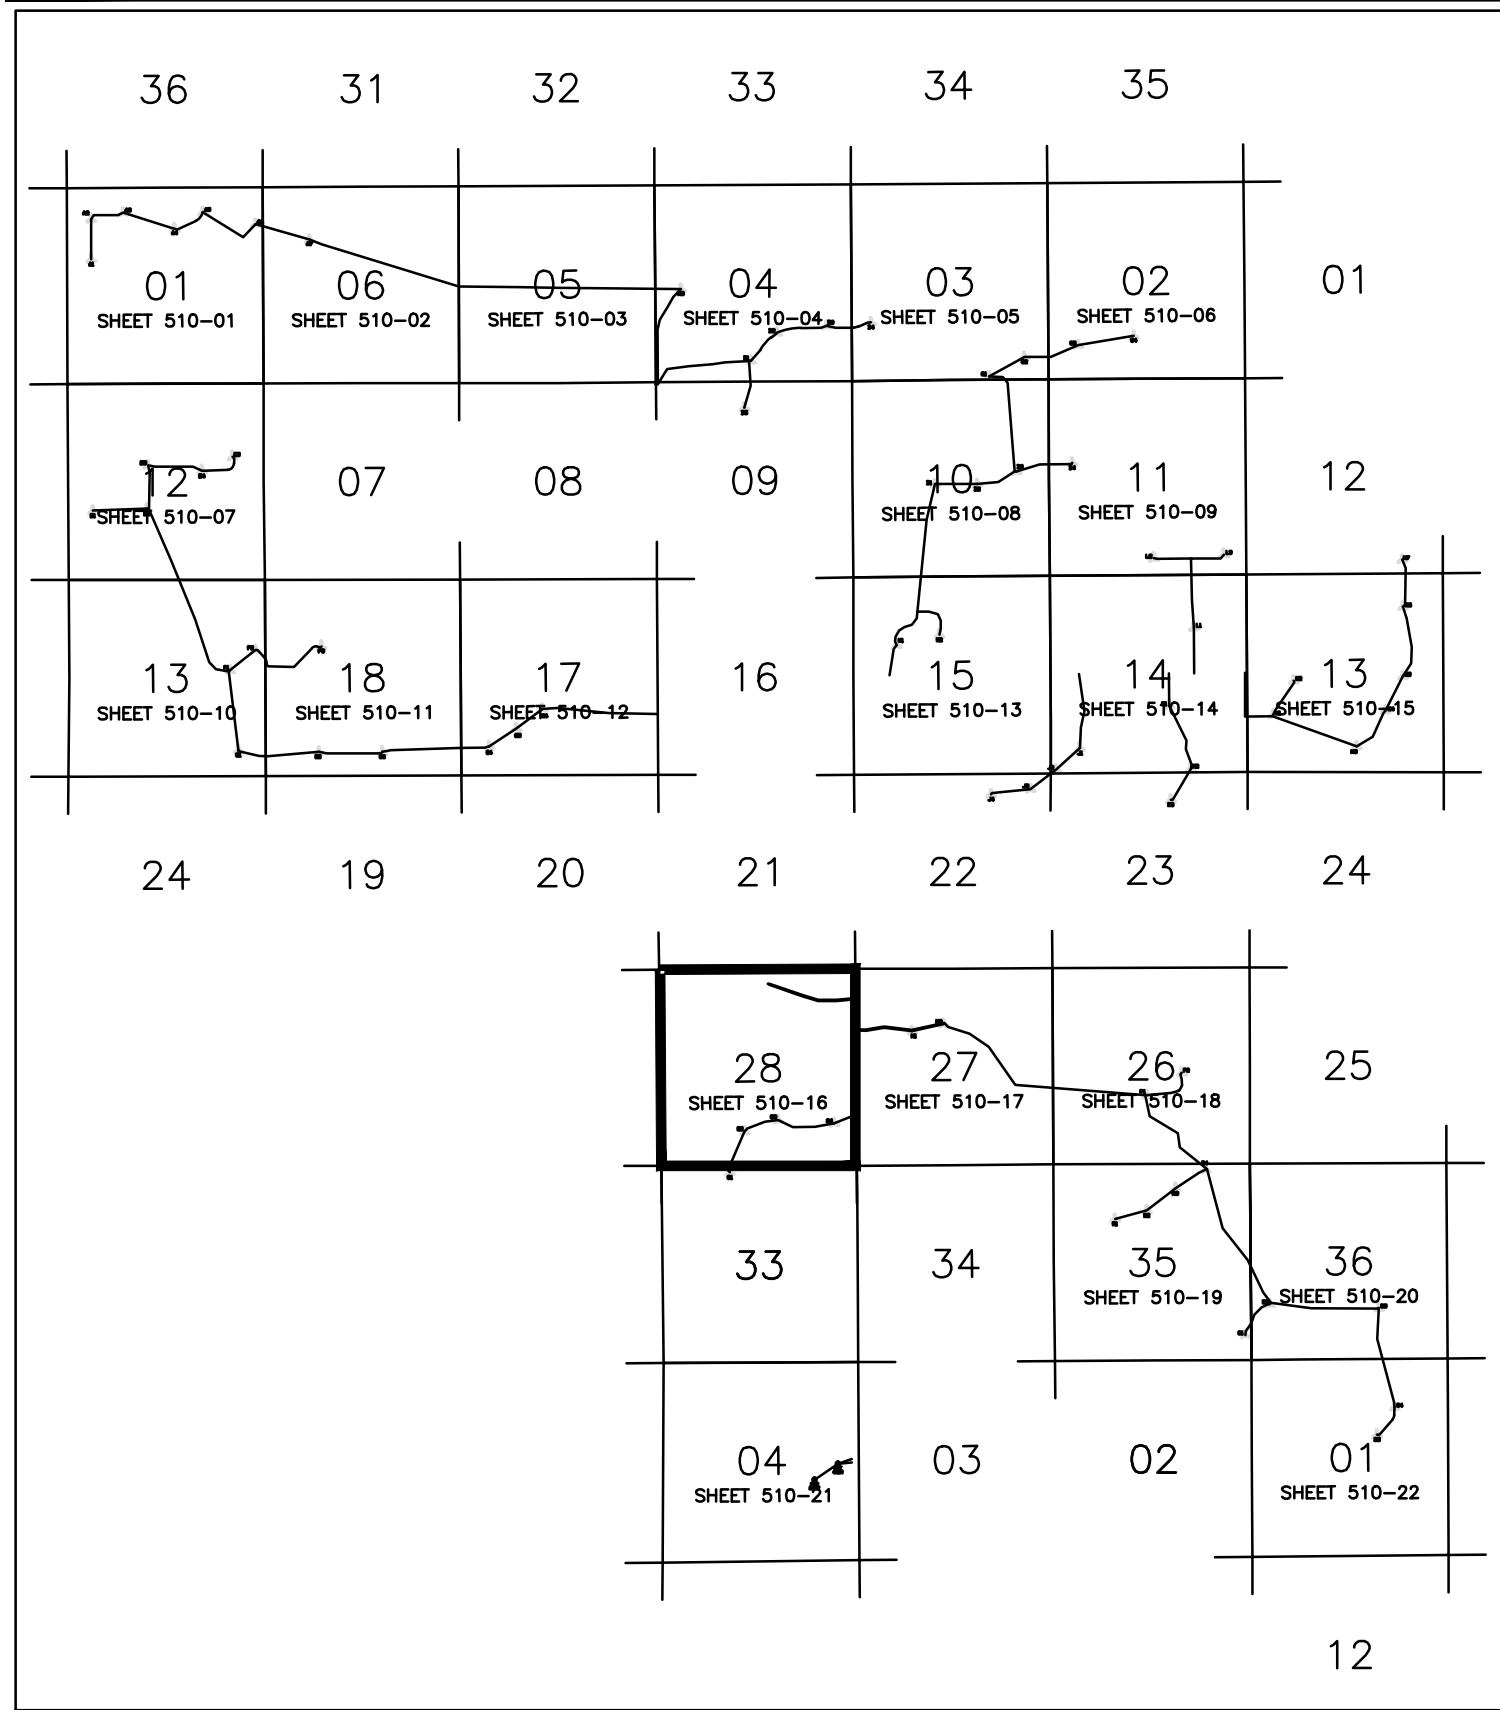

Bismarck - Denver - Detroit Lakes - Fargo - Minneapolis - Sioux Falls  
4776 28th Avenue South  
Fargo, ND 58104  
Phone: 701.451.8300 Fax: 701.451.8301  
Web: [www.ulteig.com](http://www.ulteig.com)  
Drawn By:  
Checked By:  
Approved By:

RUGBY WIND PROJECT  
SECTION 28, T158N, R72W

Project Number: 108.0495  
Date Created: October 29, 2009  
Dwg No: RUG-E-510-16.DWG