

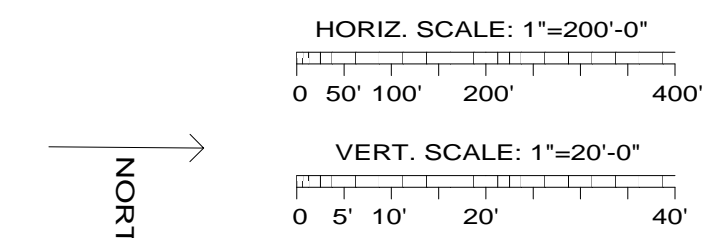


REV	DATE	BY
0 - REVISED SINCE BID	03-04-09	SPT
1 - RECORD DRAWING	04-16-10	

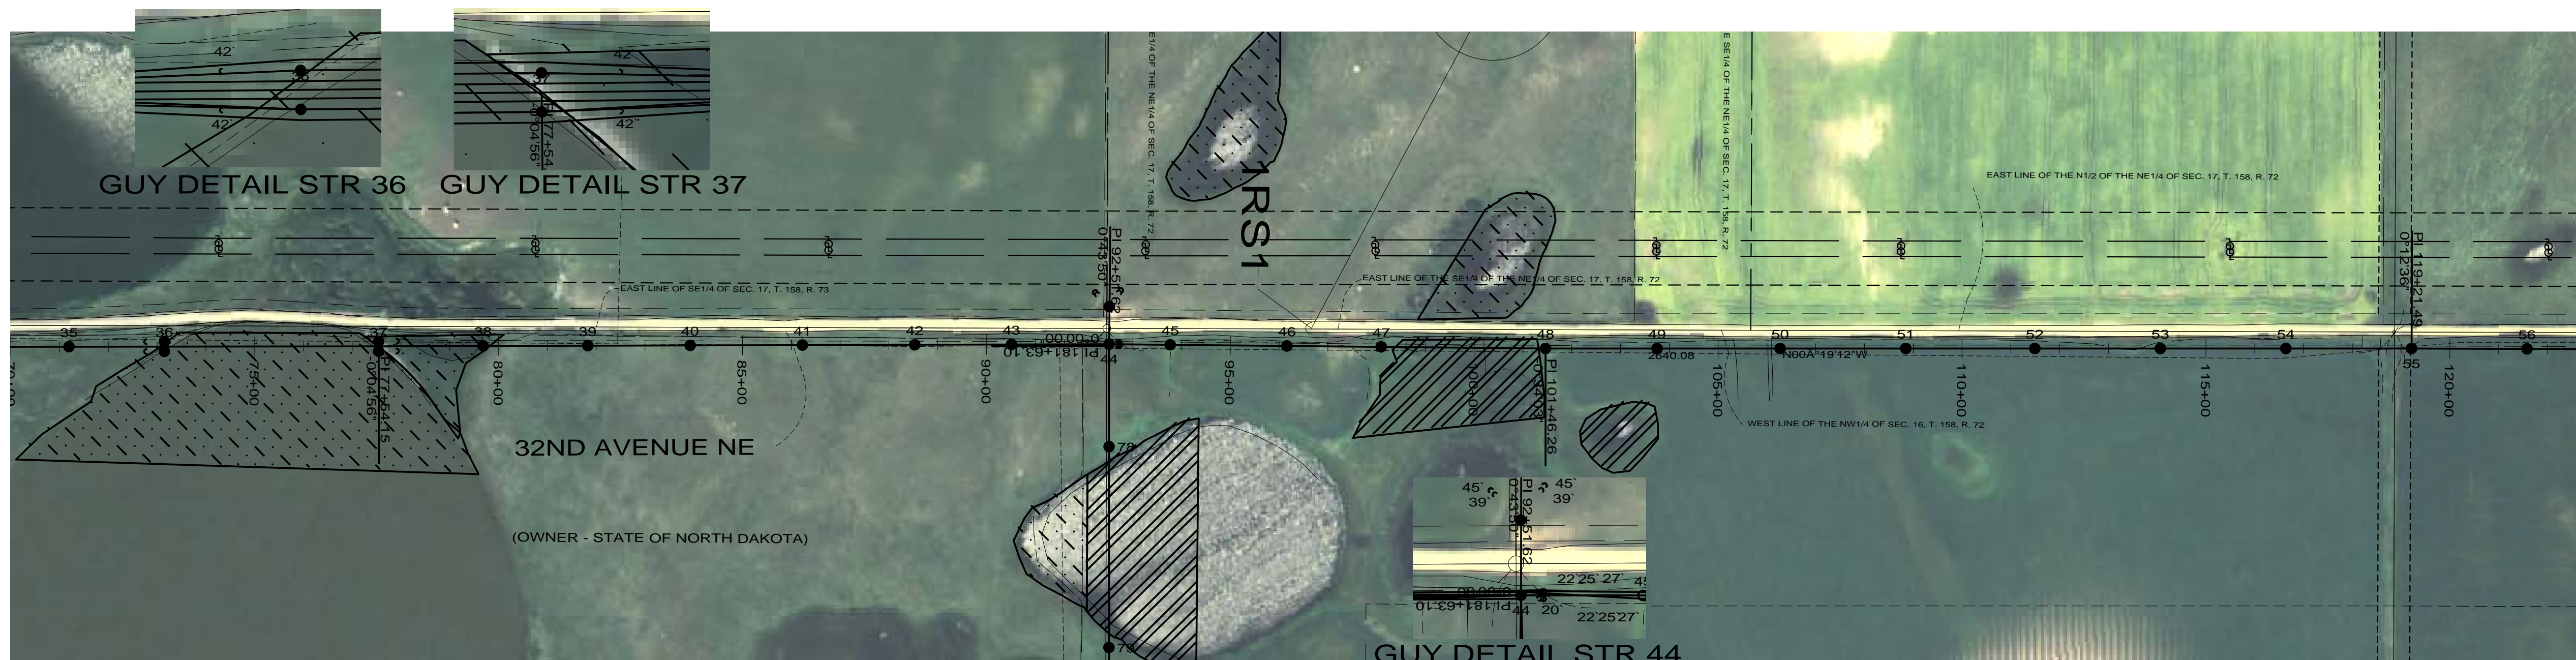

36 STA=73+14.93 2-65/H4 WF-DCDE-XARM 10%+6' EMBD WF-GND WF-EMBD, CULVERT TM-16 (2)WF-GUY-1,(2)WF-GUY-4 (2)WF-GUY-5 WF-DAMPER	37 STA=77+54.15 2-65/H4 WF-DCDE-XARM-1 10%+6' EMBD WF-GND WF-EMBD, (2)CULVERTS TM-16 (2)WF-GUY-1,(2)WF-GUY-4 (2)WF-GUY-5 WF-DAMPER	38 STA=79+68.45 1-60/H2 WF-DCTAN 10%+4' EMBD WF-GND WF-EMBD, CULVERT TM-16	39 STA=81+82.97 1-60/H2 WF-DCTAN 10%+4' EMBD WF-GND WF-EMBD TM-16	40 STA=83+92.81 1-60/H2 WF-DCTAN 10%+4' EMBD WF-GND WF-EMBD TM-16	41 STA=86+22.94 1-60/H2 WF-DCTAN 10%+4' EMBD WF-GND WF-EMBD TM-16	42 STA=88+53.14 1-60/H2 WF-DCTAN 10%+4' EMBD WF-GND WF-EMBD TM-16	43 STA=90+51.53 1-70/H3 WF-DCTAN 10%+5' EMBD WF-GND WF-EMBD TM-16	44 STA=92+51.62 1-75/1-1-50/1 WF-STR44 OPGW-S WF-GND WF-EMBD TM-16 (7)WF-GUY-1,(8)WF-GUY-2, (4)WF-GUY-3,(11)WF-GUY-4 WF-DAMPER	45 STA=93+76.79 1-70/H1 WF-TAN-3 10%+3' EMBD WF-GND WF-EMBD TM-16	46 STA=96+16.15 1-65/1 WF-TAN-RISER-1 OPGW-S WF-GND WF-EMBD TM-16 WF-DAMPER	47 STA=98+09.35 1-60/H4 WF-DE-XARM-1 10%+6' EMBD WF-GND WF-EMBD TM-16 WF-DAMPER	48 STA=101+46.26 1-55/H3 WF-DE-XARM-1 10%+5' EMBD WF-GND WF-EMBD TM-16 WF-DAMPER	49 STA=103+74.89 1-45/1 WF-TAN-1 10%+6' EMBD WF-EMBD TM-16	50 STA=106+27.33 1-45/1 WF-TAN-1 WF-GND WF-EMBD TM-16	51 STA=108+84.72 1-50/1 WF-TAN-1 WF-GND WF-EMBD TM-16	52 STA=111+49.35 1-50/1 WF-TAN-1 WF-GND WF-EMBD TM-16	53 STA=114+06.61 1-45/1 WF-TAN-1 WF-GND WF-EMBD TM-16	54 STA=116+63.94 1-45/1 WF-TAN-1 WF-GND WF-EMBD TM-16	55 STA=119+21.49 1-45/1 WF-TAN-1 WF-GND WF-EMBD TM-16	56 STA=121+58.34 1-50/1 WF-TAN-1 WF-GND WF-EMBD TM-16
--	--	---	--	--	--	--	--	--	--	---	---	--	--	---	---	---	---	---	---	---

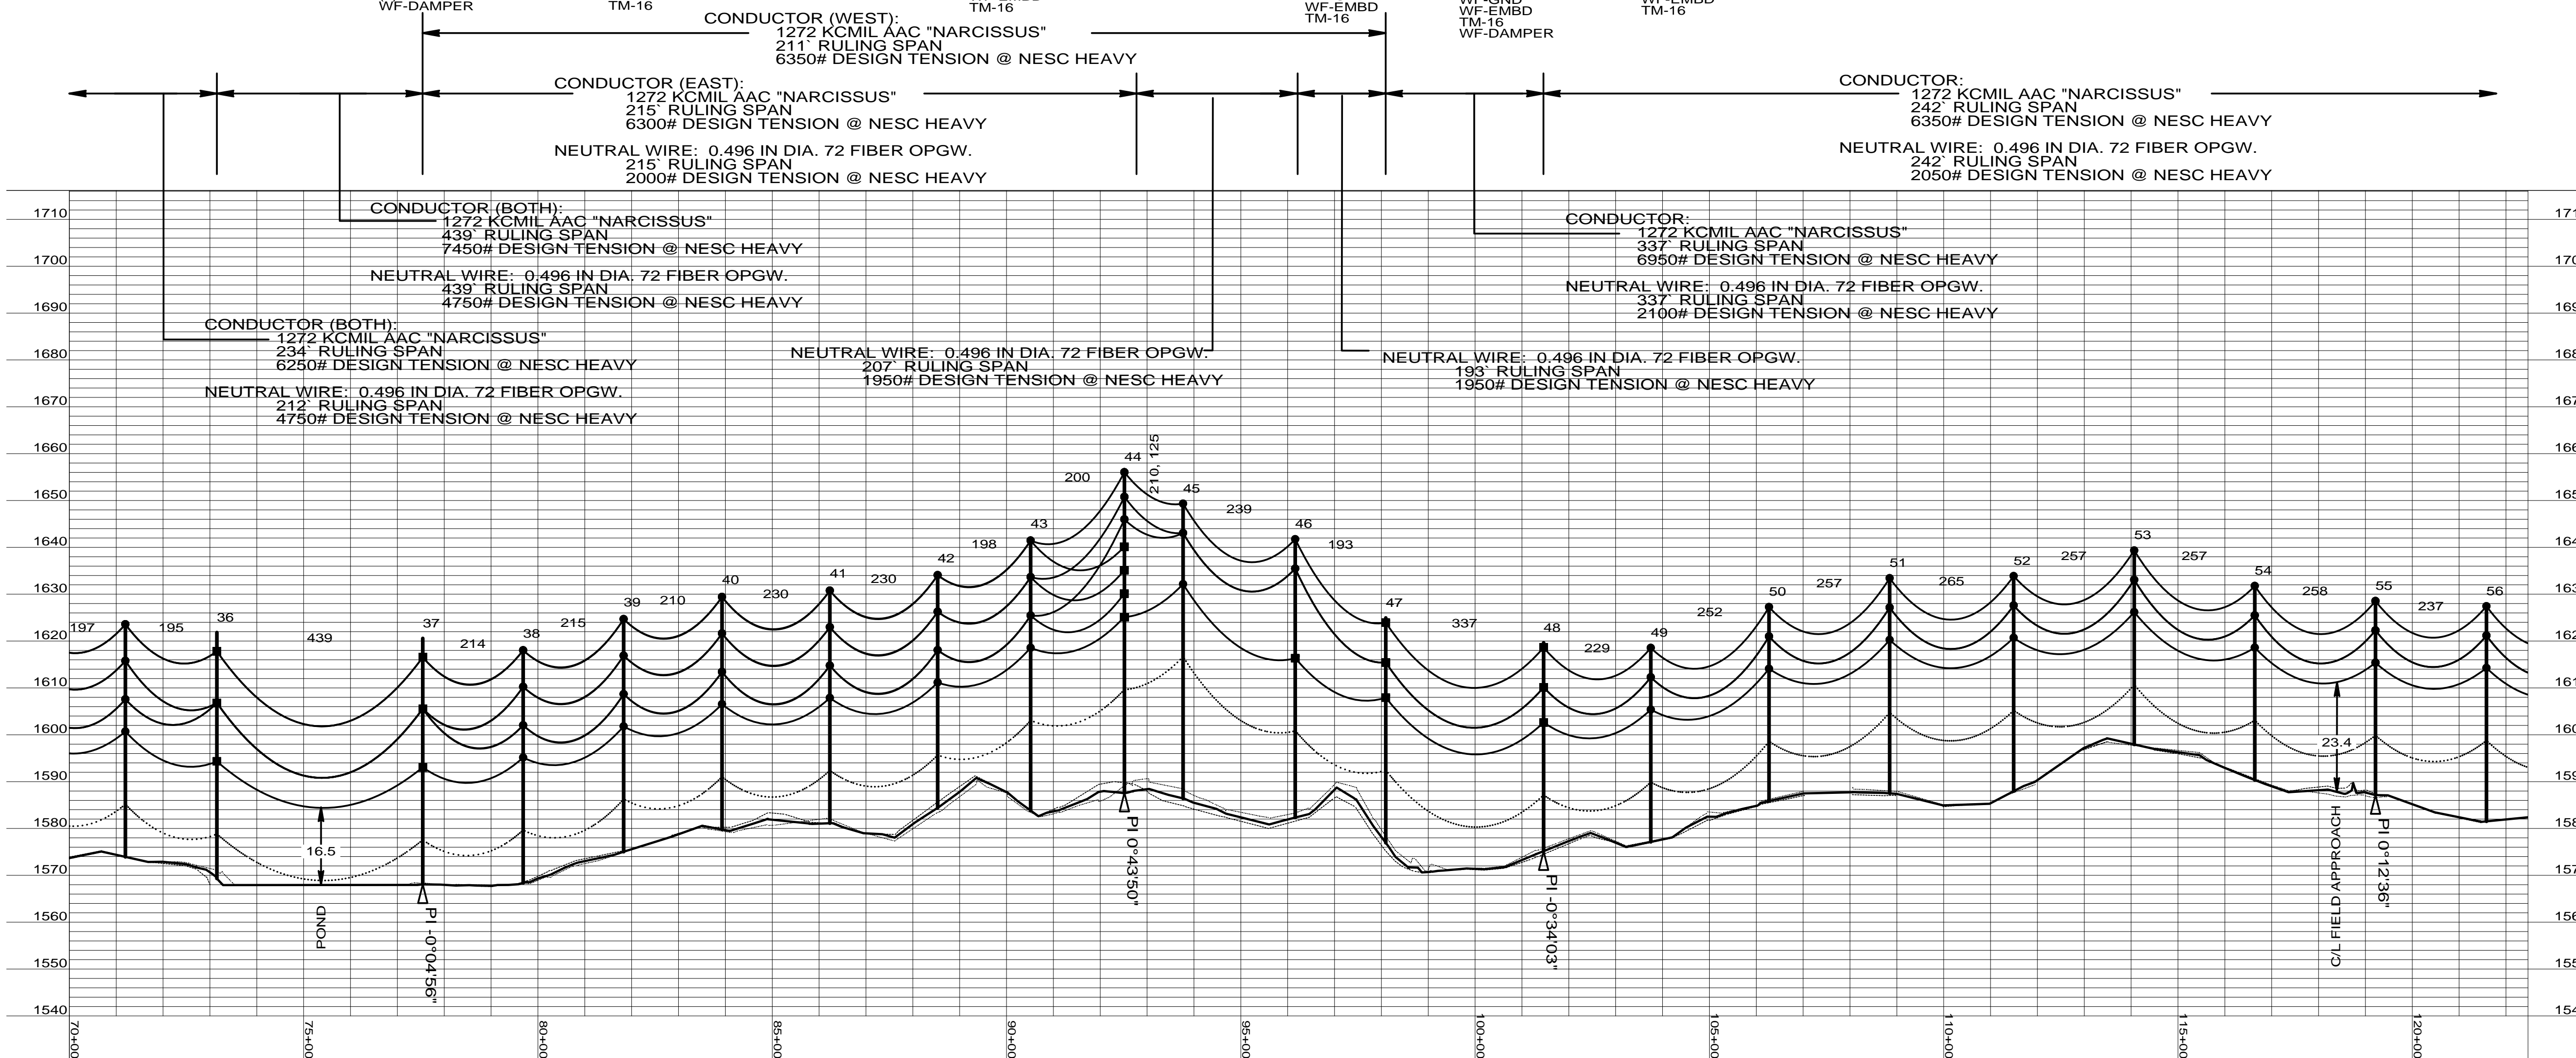

5201 EAST RIVER ROAD, SUITE 308
MINNEAPOLIS, MINNESOTA 55421
PHONE: 763.571.2500 FAX: 763.571.1168
WEB: WWW.ULTEIG.COM
DRAWN BY: NGK
CHECKED BY: MPM
APPROVED BY: SPT

**RUGBY 34.5KV
TRANSMISSION LINE
PLAN AND PROFILE**

PROJECT NUMBER: 108.0495
DATE CREATED: DECEMBER 3, 2008
DWG NO: RUG-E-511-03