

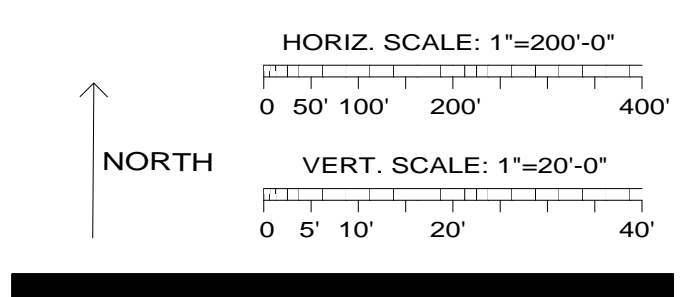


REV	DATE	BY
0 - REVISED SINCE BID	03-04-09	SPT
1 - STR 79 REVISION	05-27-09	SPT
2 - RECORD DRAWING	04-16-10	

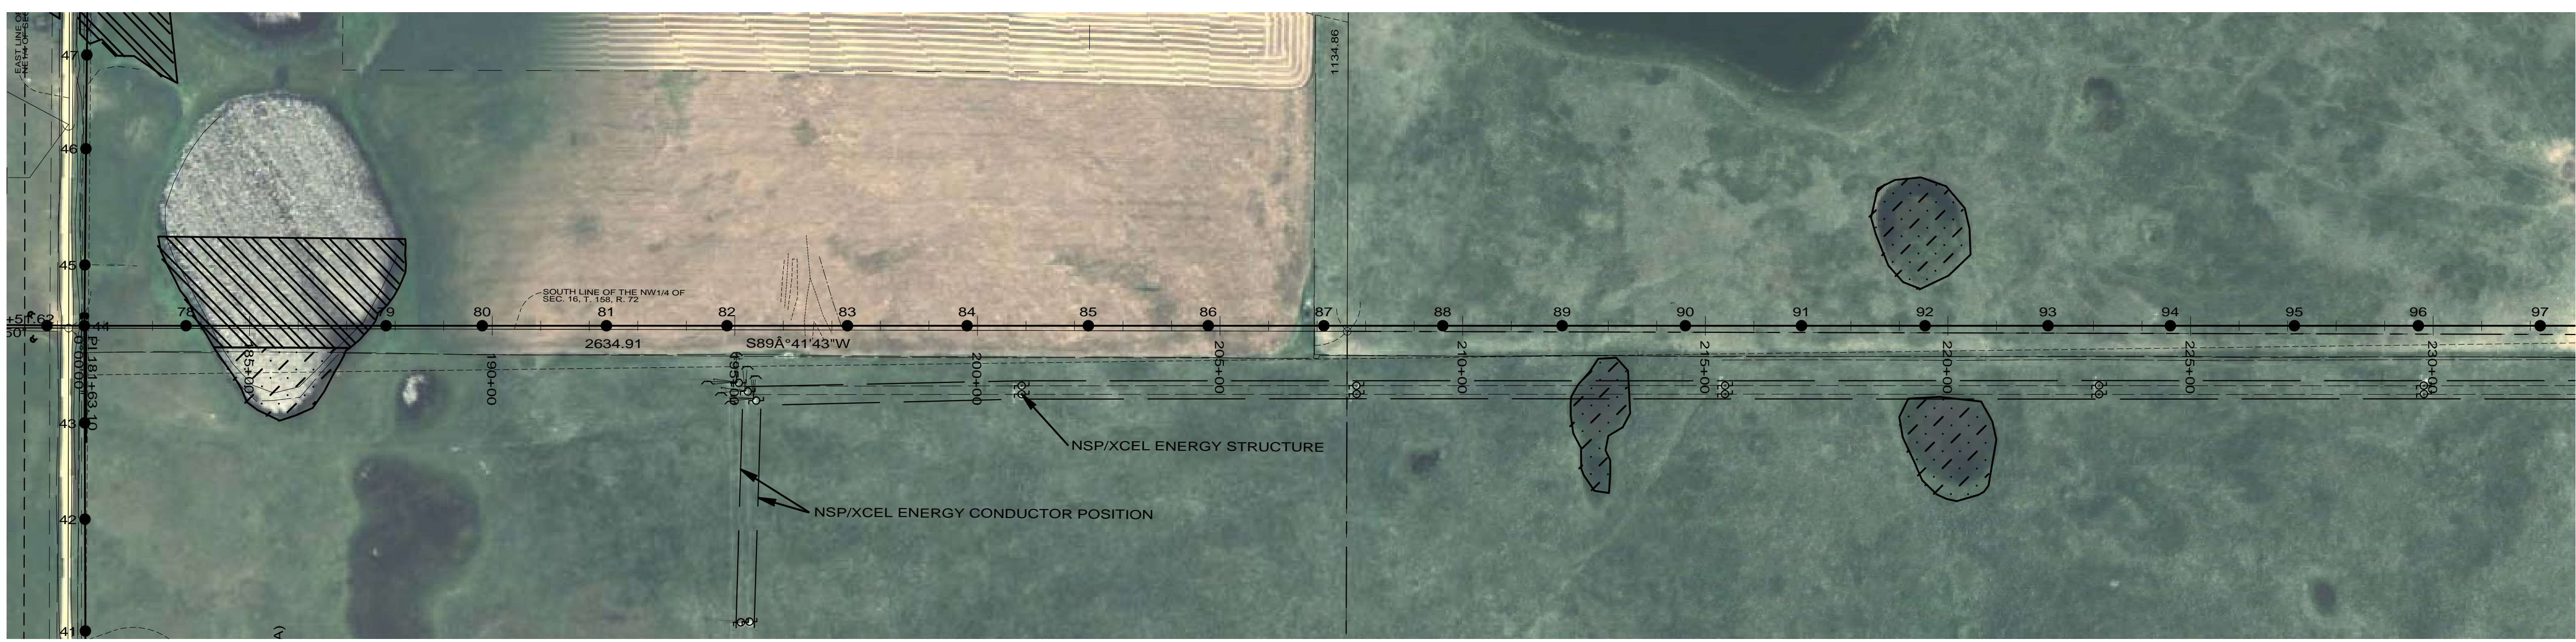

78 STA=183+69.16 1-65/H4 WF-DE-XARM-1 10%+6' EMBED WF-GND WF-EMBD, CULVERT TM-16 WF-DAMPER	79 STA=187+81.24 1-55/H3 WF-DE-XARM-1 10%+5' EMBED WF-GND WF-EMBD, CULVERT TM-16 WF-DAMPER	80 STA=189+79.54 1-50/1 WF-TAN-1 WF-GND WF-EMBD TM-16	81 STA=192+35.48 1-45/1 WF-TAN-1 WF-GND WF-EMBD TM-16	82 STA=194+83.95 1-45/1 WF-TAN-1 WF-GND WF-EMBD TM-16	83 STA=197+32.28 1-45/1 WF-TAN-1 WF-GND WF-EMBD TM-16	84 STA=199+78.61 1-45/1 WF-TAN-1 WF-GND WF-EMBD TM-16	85 STA=202+28.62 1-45/1 WF-TAN-1 WF-GND WF-EMBD TM-16	86 STA=204+75.68 1-50/1 WF-TAN-1 WF-GND WF-EMBD TM-16	87 STA=207+13.85 1-45/1 WF-TAN-1 WF-GND WF-EMBD TM-16	88 STA=209+58.99 1-45/1 WF-TAN-1 WF-GND WF-EMBD TM-16	89 STA=212+05.04 1-50/1 WF-TAN-1 WF-GND WF-EMBD TM-16	90 STA=214+59.08 1-45/1 WF-TAN-1 WF-GND WF-EMBD TM-16	91 STA=216+98.32 1-50/1 WF-TAN-1 WF-GND WF-EMBD TM-16	92 STA=219+52.96 1-50/1 WF-TAN-1 WF-GND WF-EMBD TM-16	93 STA=222+06.39 1-50/1 WF-TAN-1 WF-GND WF-EMBD TM-16	94 STA=224+58.43 1-50/1 WF-TAN-1 WF-GND WF-EMBD TM-16	95 STA=227+14.09 1-55/1 WF-TAN-1 WF-GND WF-EMBD TM-16	96 STA=229+69.54 1-50/1 WF-TAN-1 WF-GND WF-EMBD TM-16	97 STA=232+20.65 1-55/1 WF-TAN-1 WF-GND WF-EMBD TM-16
--	--	---	---	---	---	---	---	---	---	---	---	---	---	---	---	---	---	---	---

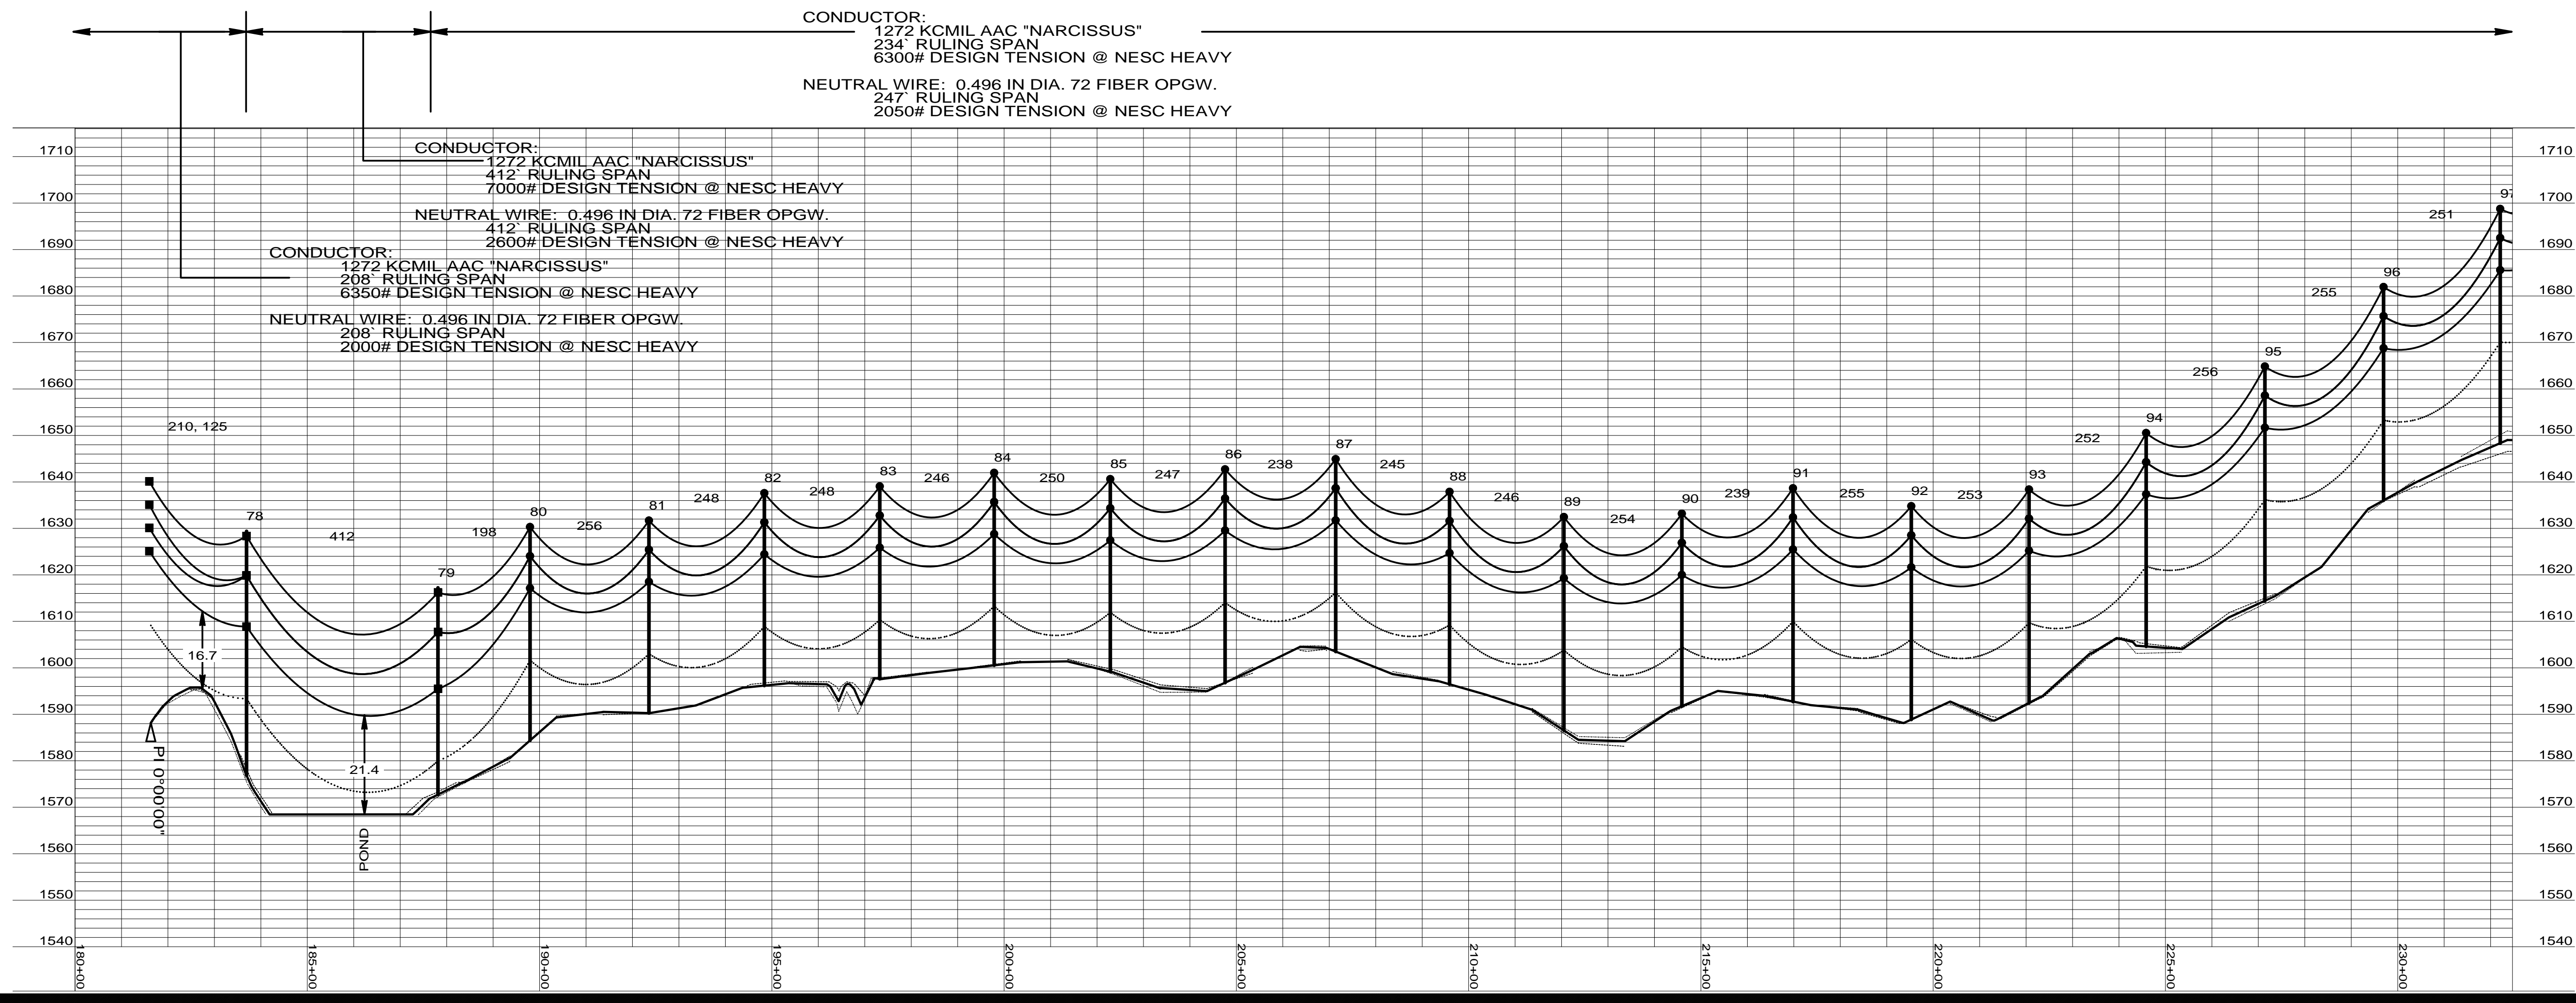

5201 EAST RIVER ROAD, SUITE 308
MINNEAPOLIS, MINNESOTA 55421
PHONE: 763.571.2500 FAX: 763.571.1168
WEB: WWW.ULTEIG.COM
DRAWN BY: NGK
CHECKED BY: MPM
APPROVED BY: SPT

**RUGBY 34.5KV
TRANSMISSION LINE
PLAN AND PROFILE**

PROJECT NUMBER: 108.0495
DATE CREATED: DECEMBER 3, 2008
DWG NO: RUG-E-511-05