

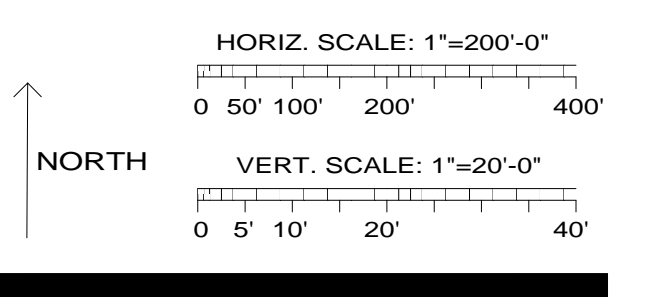


REV	DATE	BY
0 - REVISED SINCE BID	03-04-09	SPT
1 - RECORD DRAWING	04-16-10	

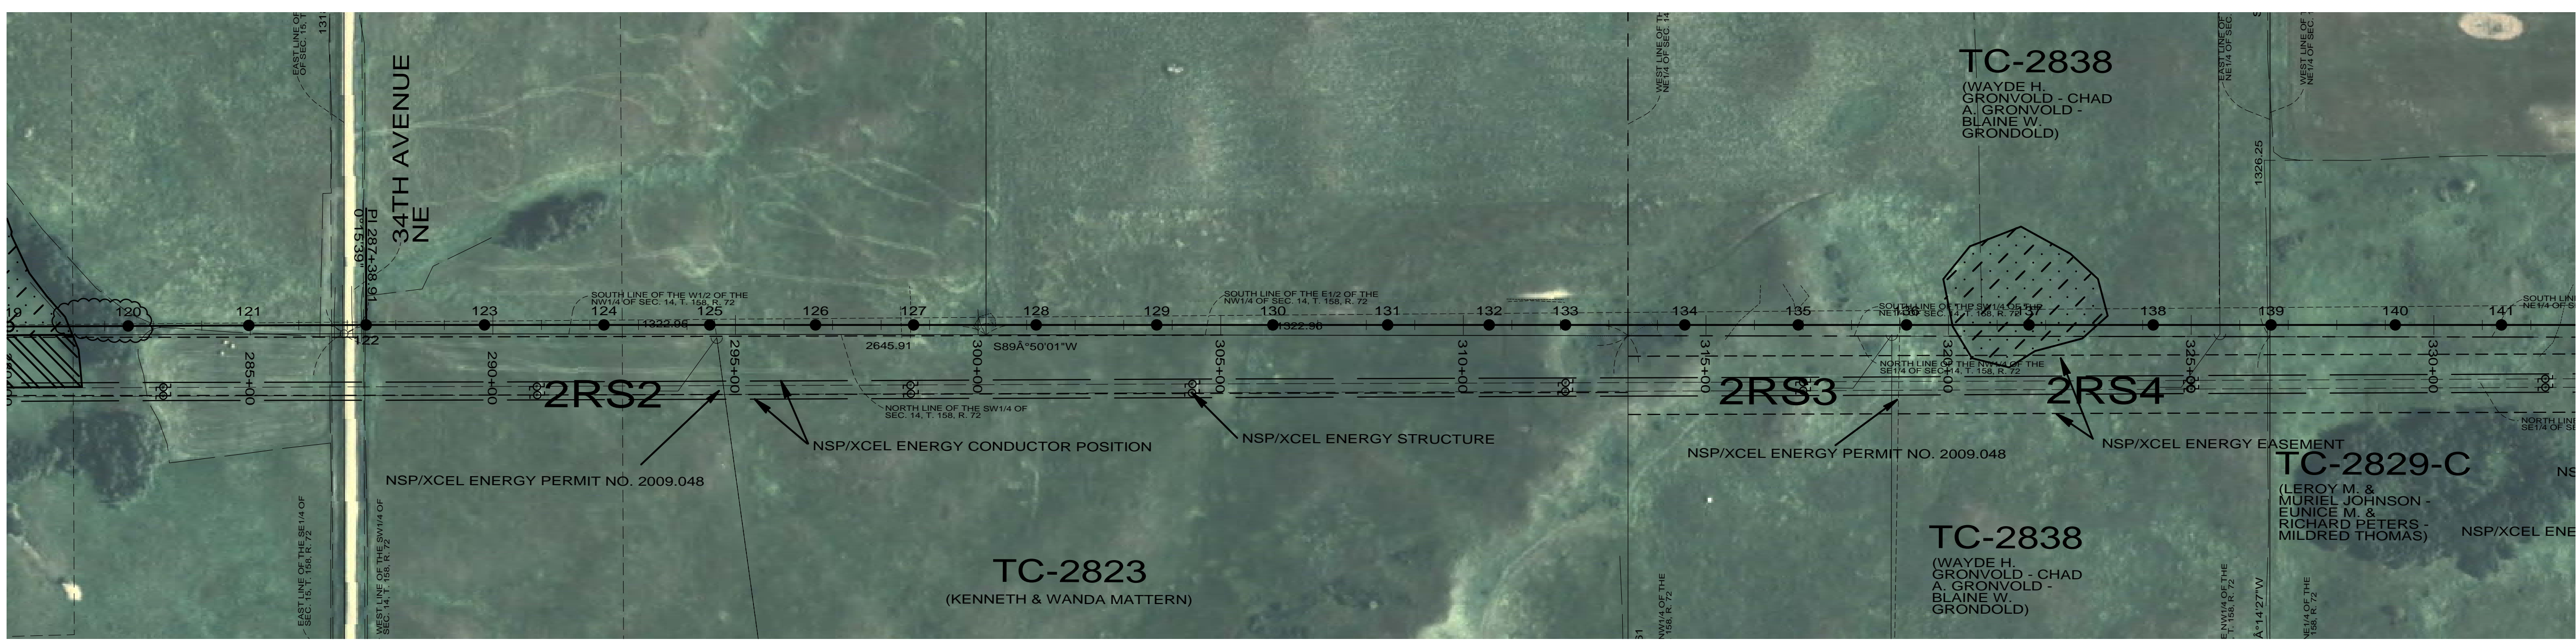

120 STA=282+48.58 1-50/1 WF-TAN-1 WF-GND WF-EMBD TM-16	121 STA=284+97.10 1-50/1 WF-TAN-1 WF-GND WF-EMBD TM-16	122 STA=287+38.91 1-50/1 WF-TAN-1 WF-GND WF-EMBD TM-16	123 STA=289+82.89 1-50/1 WF-TAN-1 WF-GND WF-EMBD TM-16	124 STA=292+29.04 1-50/1 WF-TAN-1 WF-GND WF-EMBD TM-16	125 STA=294+47.05 1-55/1 WF-TAN-RISER-1 OPGW-S WF-GND WF-EMBD TM-16 WF-DAMPER	126 STA=296+64.99 1-50/1 WF-TAN-2 WF-GND WF-EMBD TM-16	127 STA=298+67.05 1-45/1 WF-TAN-1 WF-GND WF-EMBD TM-16	128 STA=301+19.76 1-45/1 WF-TAN-1 WF-GND WF-EMBD TM-16	129 STA=303+68.16 1-50/1 WF-TAN-1 WF-GND WF-EMBD TM-16	130 STA=306+07.63 1-60/1 WF-TAN-1 WF-GND WF-EMBD TM-16	131 STA=308+44.13 1-55/1 WF-TAN-1 WF-GND WF-EMBD TM-16	132 STA=310+53.34 1-50/1 WF-TAN-1 WF-GND WF-EMBD TM-16	133 STA=312+10.63 1-50/1 WF-TAN-1 WF-GND WF-EMBD TM-16	134 STA=314+56.42 1-60/1 WF-TAN-1 WF-GND WF-EMBD TM-16	135 STA=316+90.26 1-45/1 WF-TAN-1 10%+4' EMBED WF-GND WF-EMBD TM-16	136 STA=319+13.37 1-80/H1 WF-TAN-RISER-1 OPGW-S 10%+3' WF-GND WF-EMBD TM-16 WF-DAMPER	137 STA=321+65.82 1-80/H1 WF-TAN-1 10%+3' EMBED WF-GND WF-EMBD TM-16	138 STA=324+21.77 1-65/H1 WF-TAN-RISER-1 10%+3' EMBED OPGW-S WF-GND WF-EMBD TM-16 WF-DAMPER	139 STA=326+64.51 1-55/1 WF-TAN-1 WF-GND WF-EMBD TM-16	140 STA=329+20.62 1-50/1 WF-TAN-1 WF-GND WF-EMBD TM-16	141 STA=331+39.42 1-45/1 WF-TAN-1 WF-GND WF-EMBD TM-16
--	--	--	--	--	---	--	--	--	--	--	--	--	--	--	--	--	---	--	--	--	--

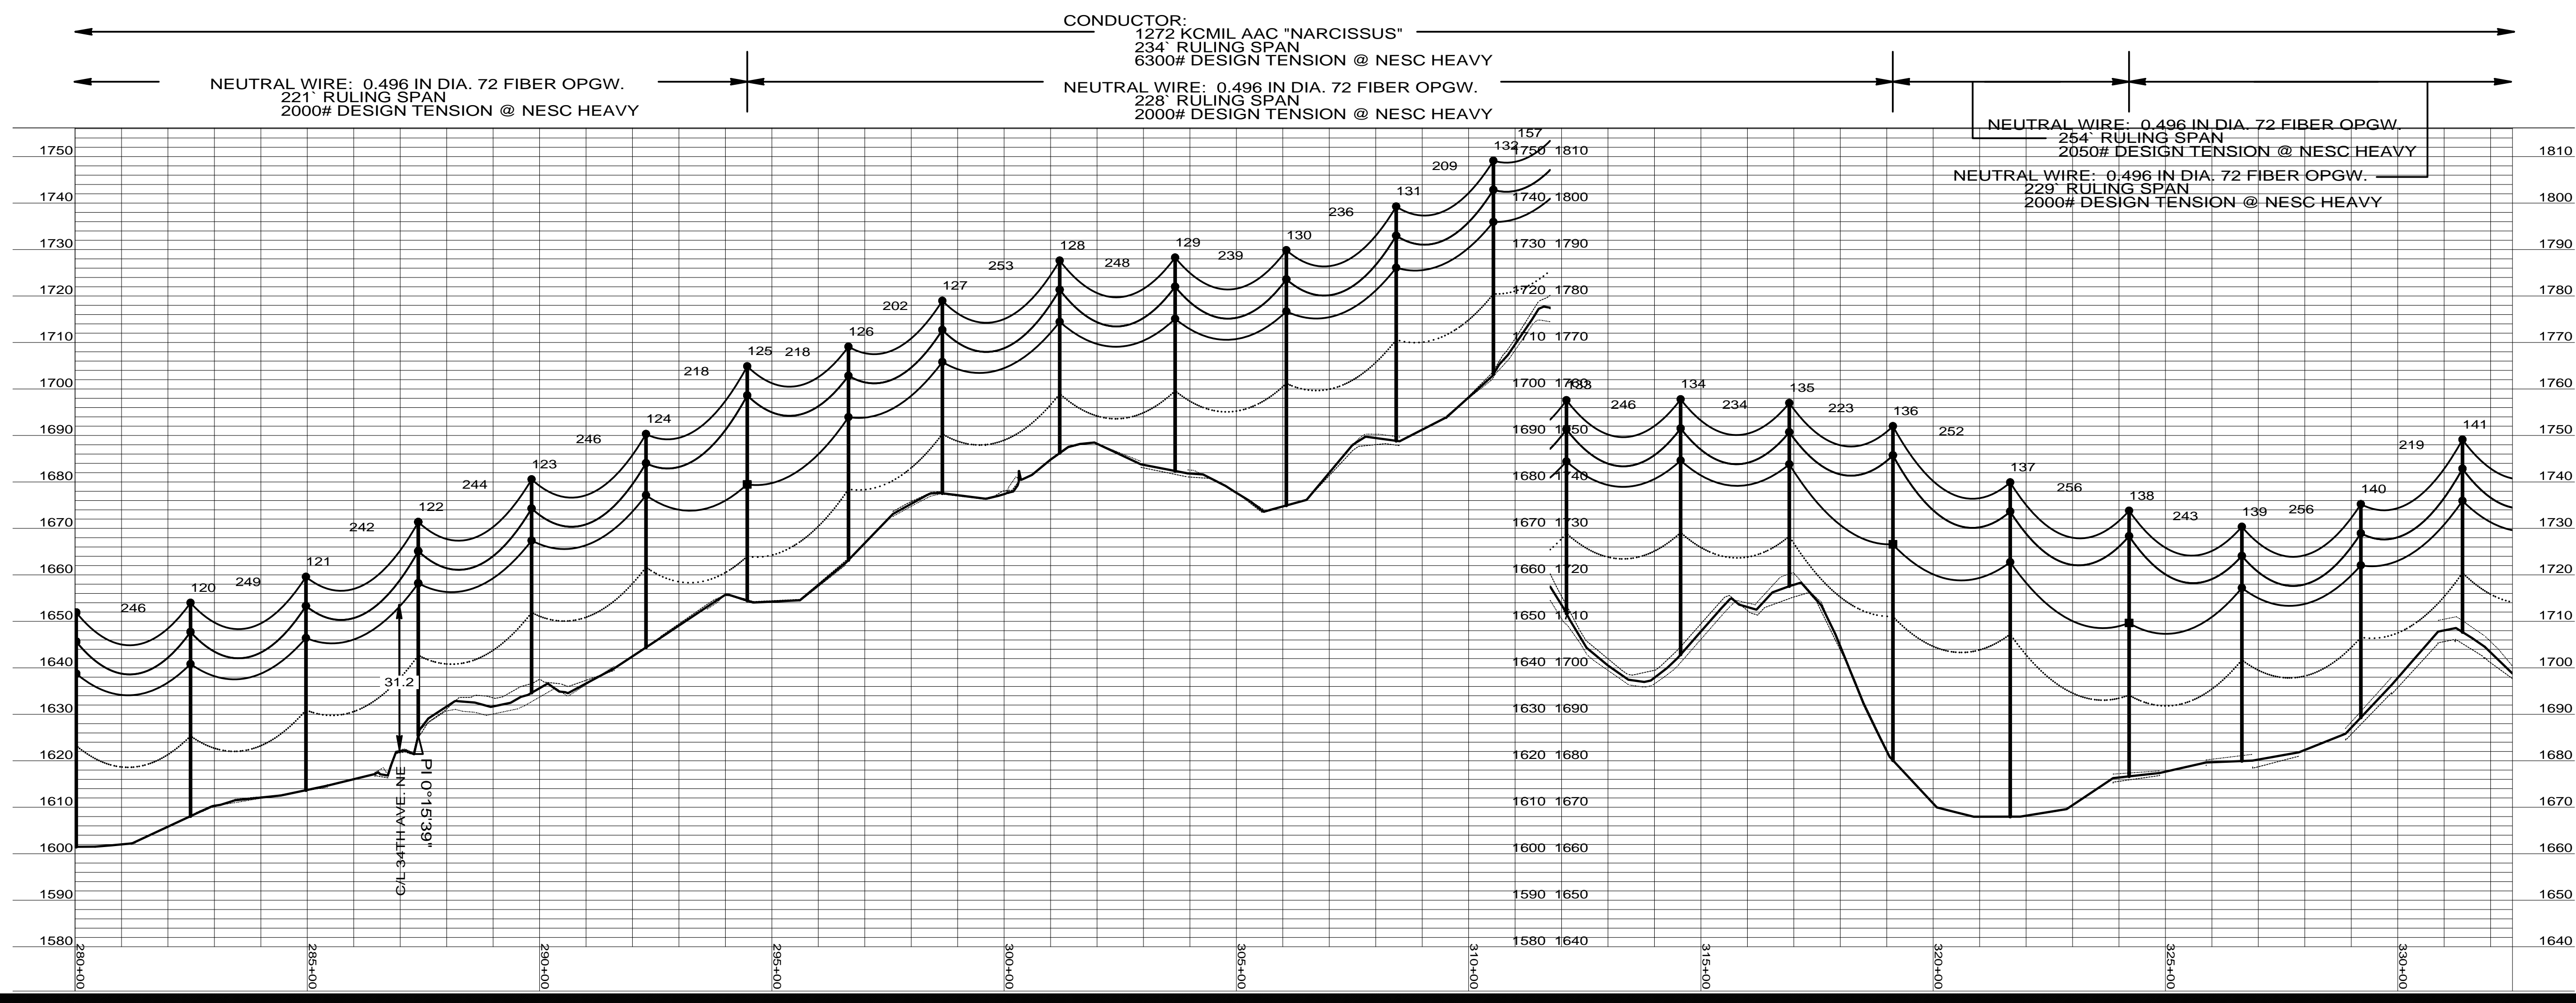

5201 EAST RIVER ROAD, SUITE 308  
MINNEAPOLIS, MINNESOTA 55421  
PHONE: 763.571.2500 FAX: 763.571.1168  
WEB: WWW.ULTEIG.COM  
DRAWN BY: NGK  
CHECKED BY: MPM  
APPROVED BY: SPT

**RUGBY 34.5KV  
TRANSMISSION LINE  
PLAN AND PROFILE**

PROJECT NUMBER: 108.0495  
DATE CREATED: DECEMBER 3, 2008  
DWG NO: RUG-E-511-07