


SEE DRAWING  
2447-P-006  
FOR PIPING DETAILS  
(TANK A-9700 CONN.)

SEE DRAWING  
2447-P-008  
FOR PIPING DETAILS  
(BELOW GRADE PIPING)

SEE DRAWING  
2447-P-007  
FOR PIPING DETAILS  
(NEW TANK CONN.)

SEE DRAWING  
2447-P-002  
FOR PIPING DETAILS  
(MAINLINE PUMP)


SEE DRAWING  
2447-P-005  
FOR PIPING DETAILS  
(BOOSTER PUMPS)

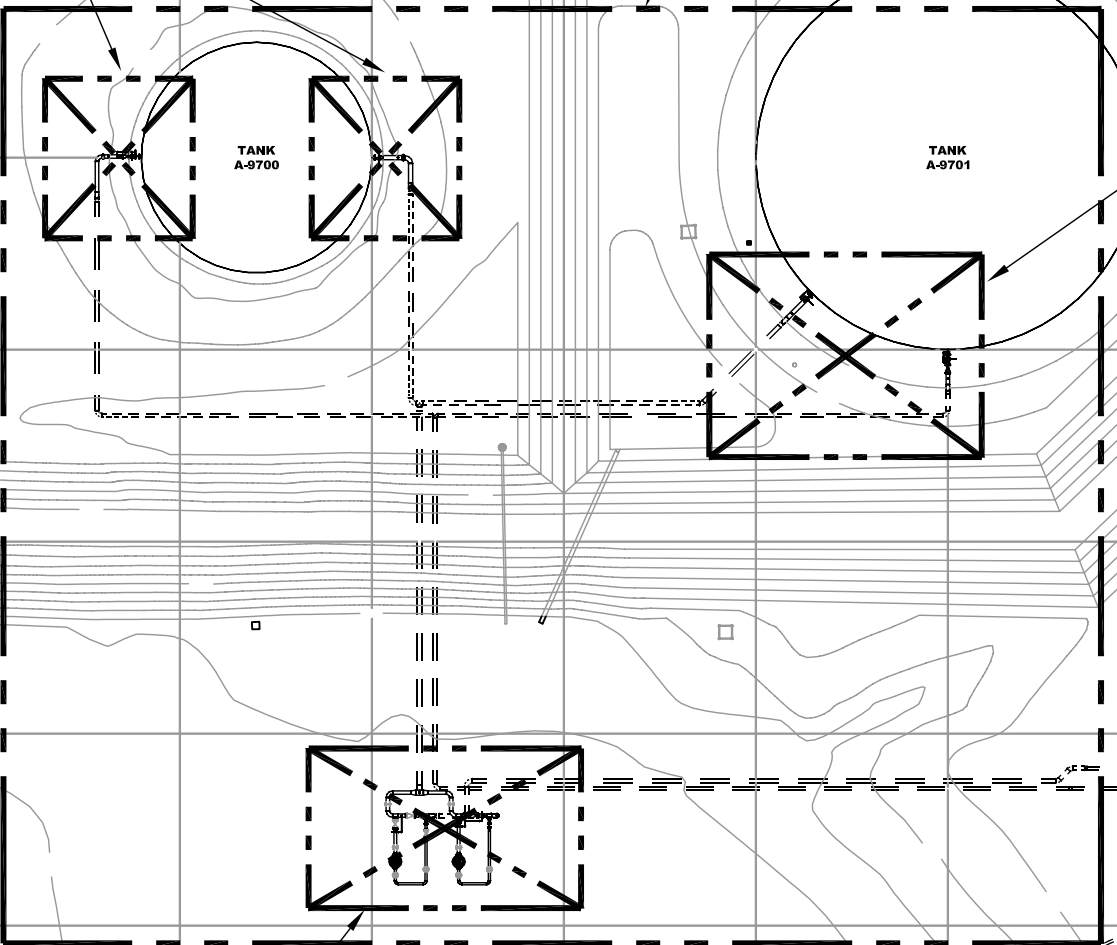

CONTROL  
BUILDING

NO	REVISION	DATE	APPR	BY
1	AS-BUILT	2/14/08		ADJ
0	ISSUED FOR CONSTRUCTION	2/23/07		ADJ

**ENBRIDGE PIPELINES (ND)**  
**ALEXANDER (ND) STATION**  
PIPING INDEX SHEET  
NEW 55M TANK & BOOSTER PUMP

  
**Rooney Engineering, Inc.**  
12201 E. Arapahoe Rd.  
Centennial, CO 80112  
(303) 792-5911

PROJECT:	SCALE: 3/32"=1'-0"	DATE: 12/6/06	DRAWN: ADJ
CHECK:	APPR:	DATE:	

DWG. NO. 2447-P-000