





**DETAIL 1**  
SCALE N.T.S.  
(SEE NOTE 1)

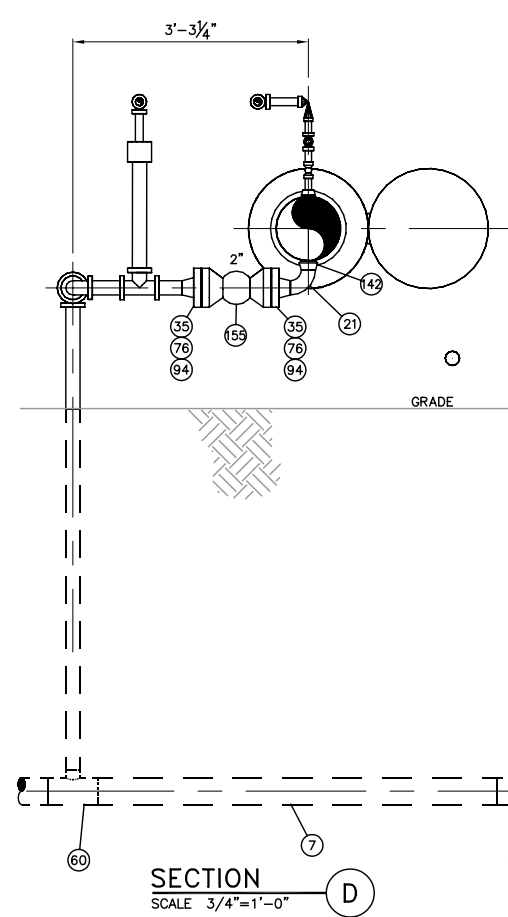


**SECTION D**  
SCALE 3/4"=1'-0"

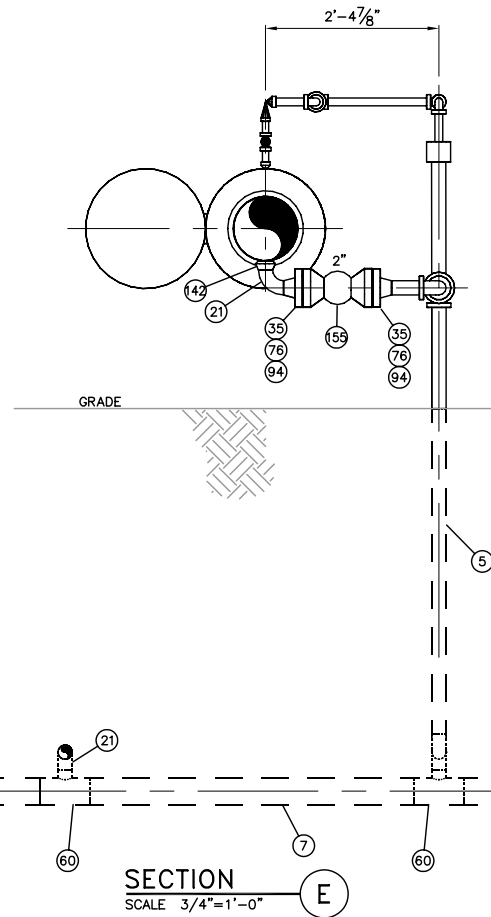


**SECTION E**  
SCALE 3/4"=1'-0"

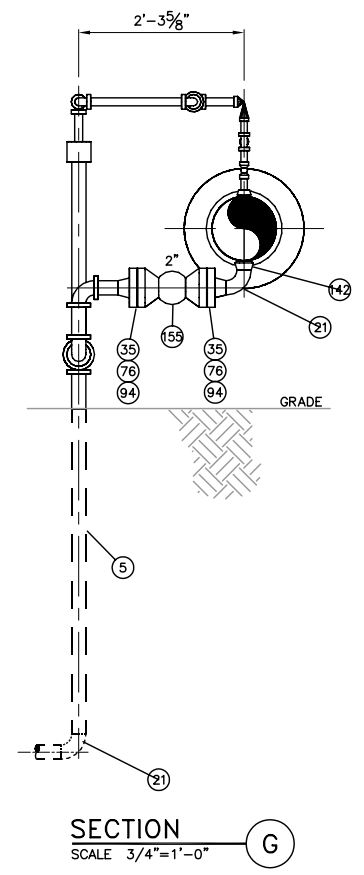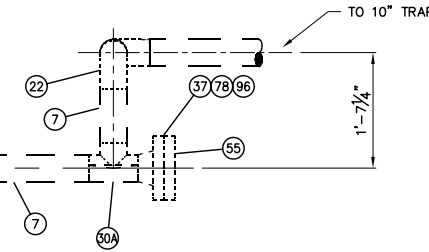


**SECTION G**  
SCALE 3/4"=1'-0"

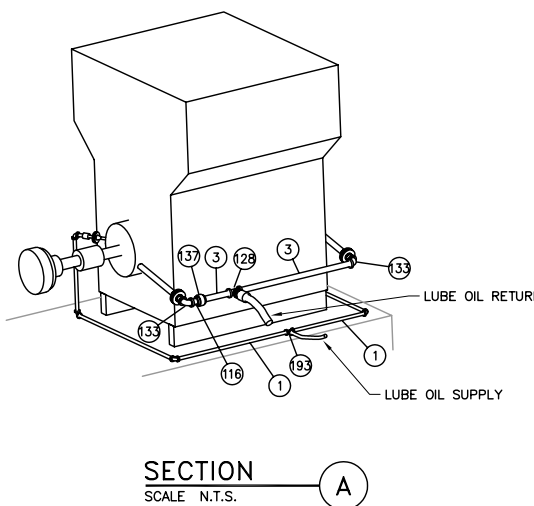


**SECTION A**  
SCALE N.T.S.

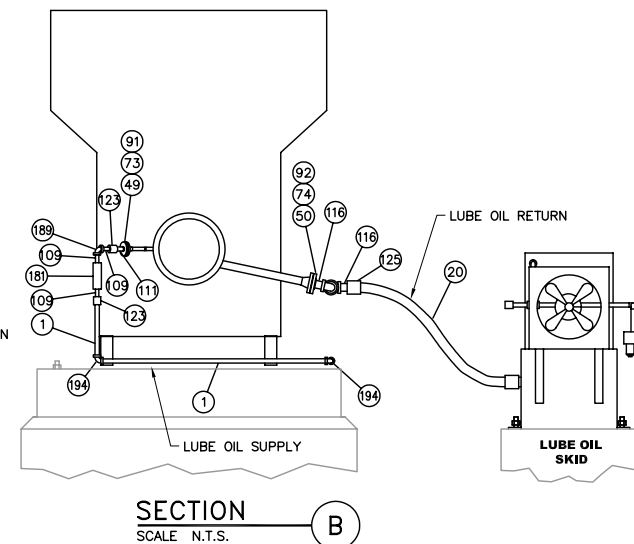


**SECTION B**  
SCALE N.T.S.

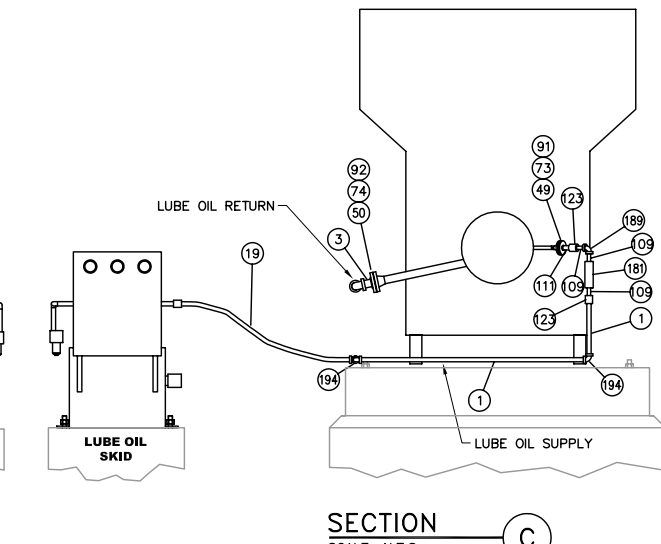


**SECTION C**  
SCALE N.T.S.  
(SEE NOTE 1)

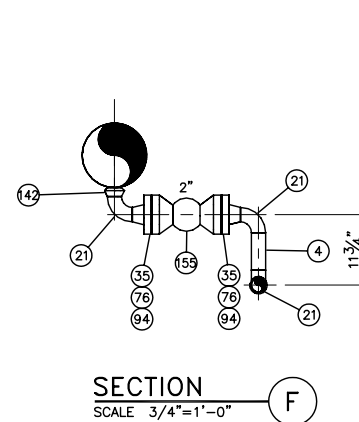

**SECTION F**  
SCALE 3/4"=1'-0"

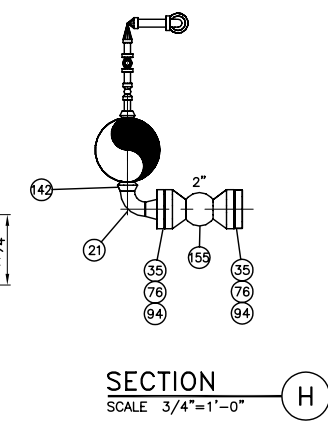

**SECTION H**  
SCALE 3/4"=1'-0"

  
**Rooney Engineering, Inc.**  
12201 E. Arapahoe Rd.  
Centennial, CO 80112  
(303) 792-5911

NO	REVISION	DATE	APPR	BY
1	AS-BUILT	2/12/08		
0	ISSUED FOR CONSTRUCTION	4/20/07		

**ENBRIDGE PIPELINES (ND)**

**TRENTON (ND) STATION**  
PIPING SECTIONS AND DETAILS

PROJECT:	SCALE: AS NOTED	DATE: 1/16/07	DRAWN: ADJ
CHECK:	APPR:	DATE:	

DWG. NO. 2446-P-008