


TERRAIN	AGRICULTURE
VEGETATION	CULTIVATED CROPS
OWNERSHIP	TANK FAMILY REVOCABLE TRUST
R.O.W. No.	W-19
RODDAGE	236.8
ROW WIDTH	75'
	750+00
	710+92
	686+69
	633+92
	625+00

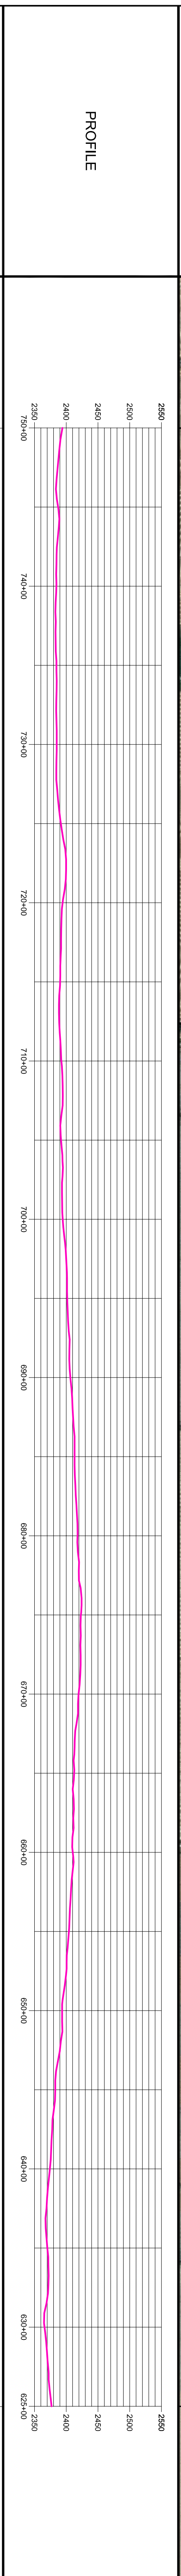

PIPELINE STATIONING	PI 0' LT	PI 0' RT
CROSSING LENGTH	STA. 730+58	STA. 677+16
PIPE SPECIFICATION	A	B
	60'	125'
	STA. 710+95	STA. 660+30
	STA. 710+19	STA. 659+97
	A	A
	60'	125'
	STA. 677+16	STA. 630+34

PIPE DETAIL AND APPURTENANCES	CL-117TH AVE NW OVERHEAD POWER	CL-116TH AVE NW (BORE)	DRAINAGE
-------------------------------	--------------------------------	------------------------	----------

ITEM	DESCRIPTION	QUANTITY	REFERENCE DRAWINGS	NO.	REVISION	DATE
PIPE A	10.75" X 2.19 WT. API 5L X-52 W/ FBE	12,315'				
PIPE B	10.75" X 3.07 WT. API 5L X-52 W/ FBE W/ ARO	187'				
CP2	CP TEST LEAD	1				

GENERAL NOTES

1. PIPELINE MINIMUM DEPTH OF COVER IS 4' CROSSING COUNTY AND TOWNSHIP ROADS MINIMUM DEPTH OF COVER IS 2'. MINIMUM HYDROSTATIC TEST PRESSURE IS 1900 PSIG.
2. MINIMUM HYDROSTATIC TEST PRESSURE IS 1900 PSIG.

LEGEND

- EX - EXISTING PIPELINE (UNDERGROUND)
- CP - EXISTING PIPELINE (UNDERGROUND)
- G - EXISTING NATURAL GAS PIPELINE (UNDERGROUND)
- T - EXISTING TELEPHONE
- EO - EXISTING ELECTRICAL (OVERHEAD)
- E - EXISTING ELECTRICAL (UNDERGROUND)
- FO - EXISTING FIBER OPTICS
- X - EXISTING FENCE

AS CONSTRUCTED ALIGNMENT SHEET
TRENTON TO BEAVER LODGE
NORTH DAKOTA

ENBRIDGE PIPELINES (ND)

Rooney Engineering, Inc.
12201 E. Arapahoe Rd.
Centennial, CO 80112
(303) 792-5911

WILLIAMS
SCALE: DRAWN: DATE: DRAWING NO:
AS SHN CL/FIGU 1/29/08 24224M0106