


Ⓔ	ELECTRICAL CROSSING
Ⓐ	UNIMPROVED ROAD CROSSING (SEE STD-0031)
Ⓑ	GRAVEL ROAD CROSSING (SEE STD-0030)
Ⓒ	IMPROVED (ASPHALT) ROAD CROSSING (SEE STD-0032)
Ⓓ	HIGHWAY CROSSING (SEE STD-0032)
Ⓜ	RAILROAD CROSSING (SEE DWG 2424M001)
Ⓝ	PIPELINE CROSSING
Ⓖ	CABLE CROSSING
Ⓦ	WATER CROSSING
Ⓢ	AERIAL MARKER
Ⓟ	BLOCK VALVE
ⒸⓅ	CP TEST LEAD (FOREIGN) (SEE DWG 2424M001)
ⒸⓅ	CP TEST LEAD (SEE DWG 2424M001)
ⒸⓅ	HOT BEND

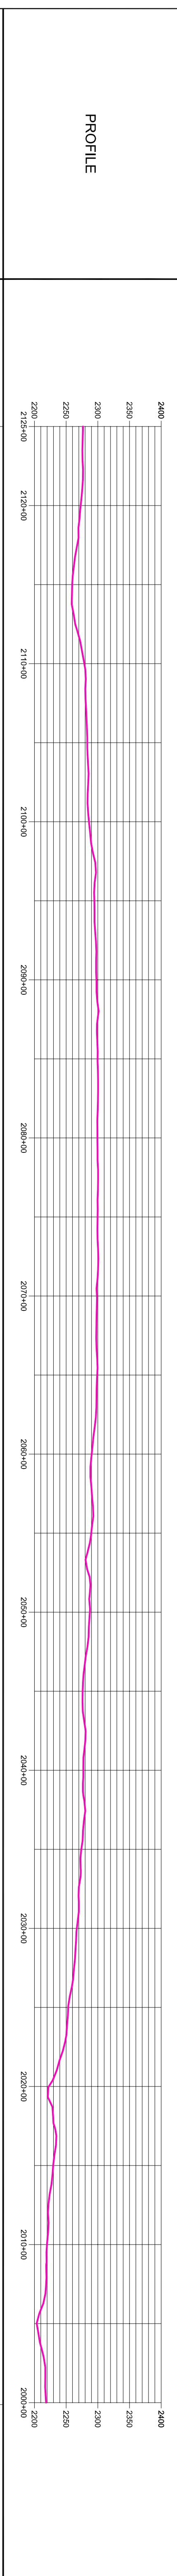

PIPELINE STATIONING	PIPE SPECIFICATION	DESCRIPTION
STA. 2118+05	A	UNDERGROUND ELECTRIC
STA. 2114+52	A	DRAINAGE
STA. 2087+27	B	UG TELEPHONE CABLE
STA. 2087+71	B	CL 142ND AVE NW FIELD ROAD
STA. 2086+72	B	
STA. 2054+37	A	ENBRIDGE P/L
STA. 2054+01	A	UG NATURAL GAS P/L
STA. 2053+06	A	BEARPAW 8"
STA. 2052+66	A	
STA. 2052+10	A	
STA. 2050+83	A	UNDERGROUND ELECTRIC
STA. 2048+22	A	
STA. 2038+77	A	CL 141ST AVE NW - LOW MAINTENANCE CR 7
STA. 2033+42	B	
STA. 2032+83	B	
STA. 2023+17	A	CL TWO TRACK FIELD ROAD
STA. 2021+70	A	DRAINAGE
STA. 2019+62	A	
STA. 2017+37	A	
STA. 2008+64	A	DRAINAGE
STA. 2005+01	A	

ITEM	DESCRIPTION	QUANTITY	REFERENCE DRAWINGS	NO.	REVISION	DATE	BY
PIPE A	10.75" X 2.19 WT API 5L X 52 W FBE	12,166'					
PIPE B	10.75" X 3.07 WT API 5L X 52 W FBE W ARO	334'					
HB	43" HOT BEND	2					
CP2	CP TEST LEAD	1					

ITEM	DESCRIPTION	QUANTITY	REFERENCE DRAWINGS	NO.	REVISION	DATE	BY
PIPE A	10.75" X 2.19 WT API 5L X 52 W FBE	12,166'					
PIPE B	10.75" X 3.07 WT API 5L X 52 W FBE W ARO	334'					
HB	43" HOT BEND	2					
CP2	CP TEST LEAD	1					

**GENERAL NOTES**

- PIPELINE MINIMUM DEPTH OF COVER IS 4' CROSSING COUNTY AND TOWNSHIP ROADS MINIMUM DEPTH OF COVER IS:
- MINIMUM HYDROSTATIC TEST PRESSURE IS 1800 PSIG.

**LEGEND**

- EXISTING PIPELINE (UNDERGROUND)
- EXISTING PIPELINE (UNDERGROUND)
- EXISTING NATURAL GAS PIPELINE (UNDERGROUND)
- EXISTING TELEPHONE
- EXISTING ELECTRICAL (OVERHEAD)
- EXISTING ELECTRICAL (UNDERGROUND)
- EXISTING FIBER OPTICS
- EXISTING FENCE

**AS CONSTRUCTED ALIGNMENT SHEET**  
TRENTON TO BEAVER LODGE  
NORTH DAKOTA

**Rooney Engineering, Inc.**  
12201 E. Arapahoe Rd.  
Centennial, CO 80112  
(303) 792-5911

**ENBRIDGE PIPELINES (ND)**

WILLIAMS  
SCALE: AS SHN  
DRAWN: CLF/IGU  
DATE: 01/29/08  
DRAWING NO: 2424M0117