



SECTION A
SCALE 3/8"=1'-0"

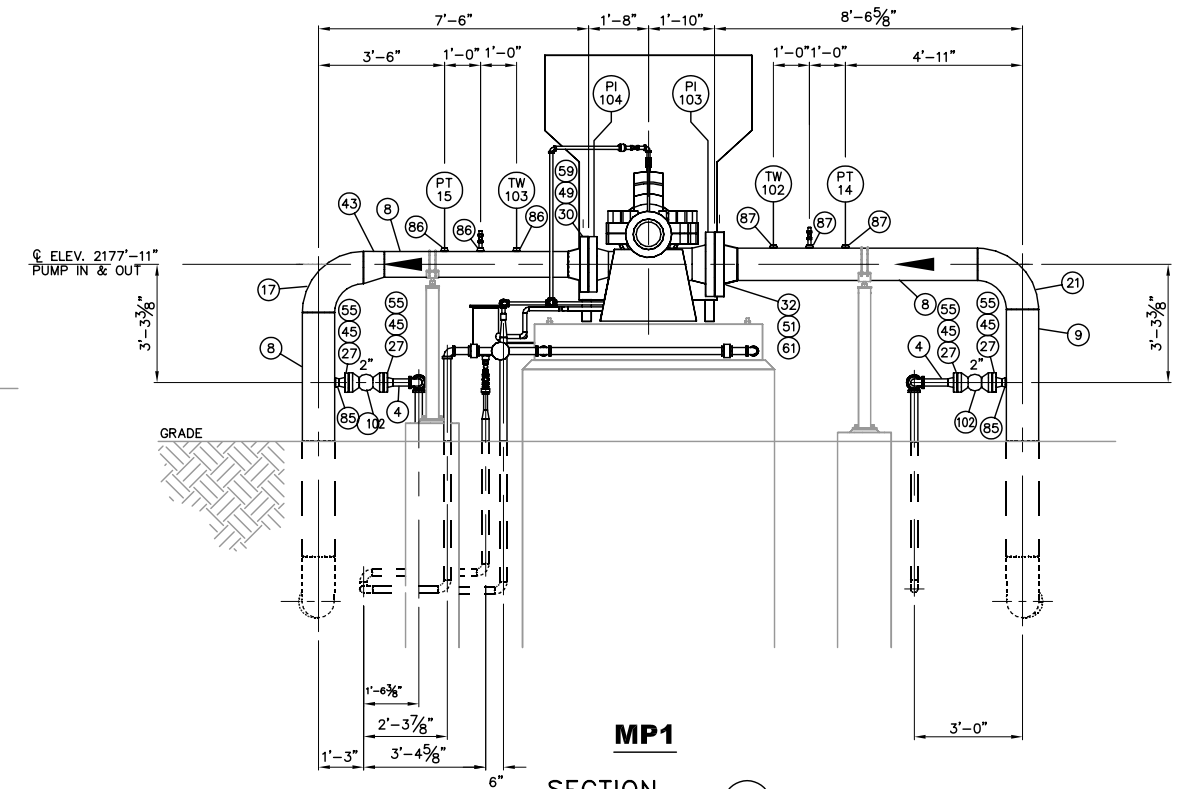

SECTION C
SCALE 3/8"=1'-0"

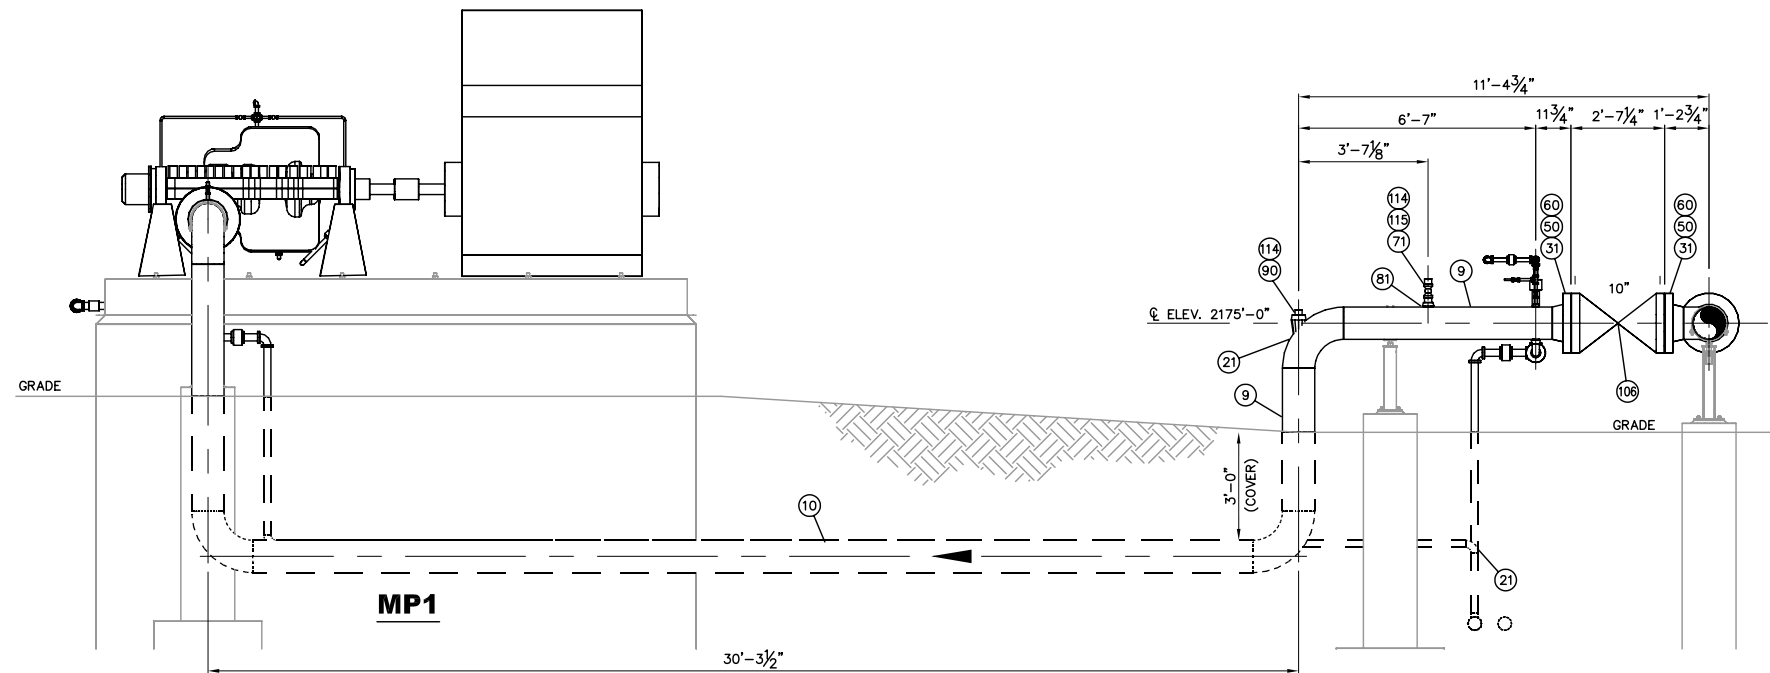

SECTION B
SCALE 3/8"=1'-0"

NO	REVISION	DATE	APPR	BY
1	AS-BUILT	2/7/08	EJK	ADJ
0	ISSUED FOR CONSTRUCTION	4/30/07	EJK	ADJ

ENBRIDGE PIPELINES (ND)

BLAISDELL STATION

PIPING
SECTIONS AND DETAILS

PROJECT: ENBRIDGE ND EXPANSION		
SCALE: AS NOTED	DATE: 12/18/06	DRAWN: ADJ
CHECK:	APPR:	DATE:

DWG. NO. 2431-P-005



Rooney Engineering, Inc.
12201 E. Arapahoe Rd.
Centennial, CO 80112
(303) 792-5911