



  
 Scale: 1" = 100'
   
 1" = 100'
   
 1" = 100'
   
 1" = 100'

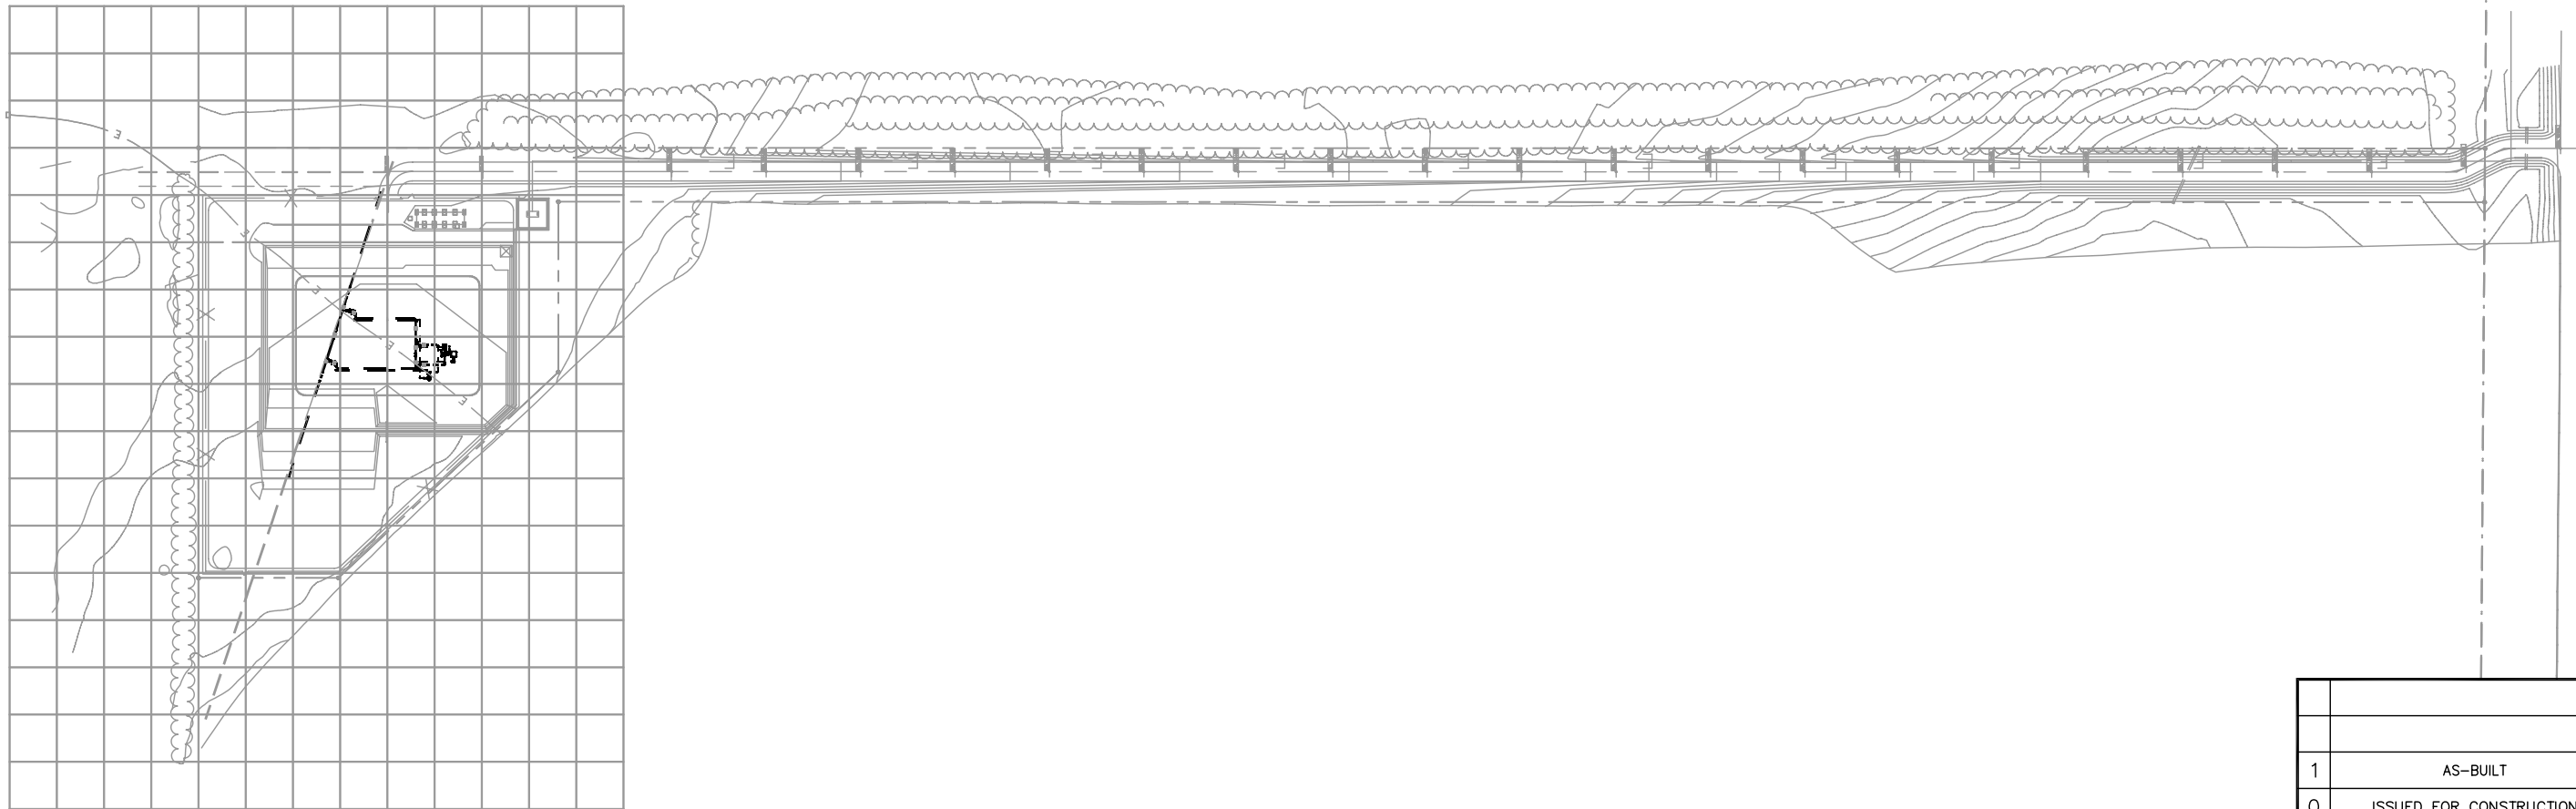

NO	REVISION	DATE	APPR	BY
1	AS-BUILT	12/18/07	EK	ADJ
0	ISSUED FOR CONSTRUCTION	3/28/07	EJK	ADJ


  
**ENBRIDGE PIPELINES (ND)**
  
**LARIMORE STATION**
  
 PLOT PLAN


  
**Rooney Engineering, Inc.**
  
 12201 E. Arapahoe Rd.  
 Centennial, CO 80112  
 (303) 792-5911

PROJECT:		
SCALE: NTS	DATE: 5/15/06	DRAWN: ADJ
CHECK:	APPR:	DATE:
<b>DWG. NO. 2406-P-001</b>		