




SECTION A  
SCALE 3/8"=1'-0" (A)

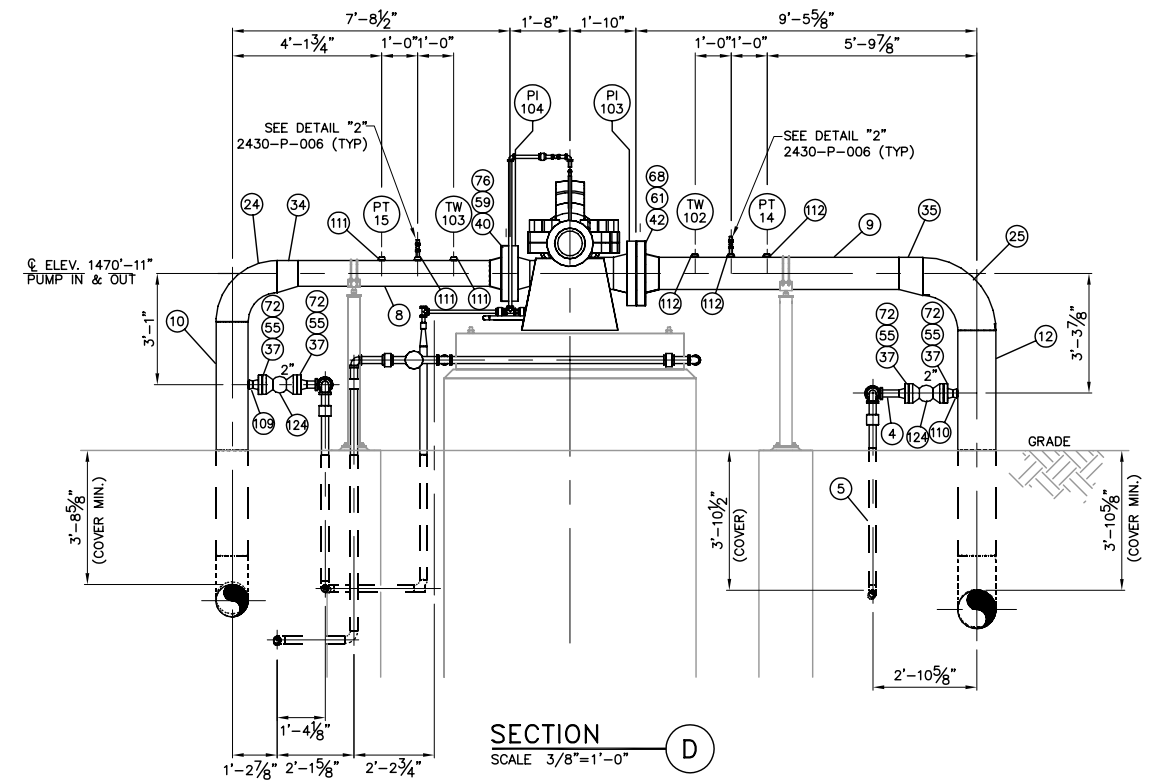

SECTION D  
SCALE 3/8"=1'-0" (D)

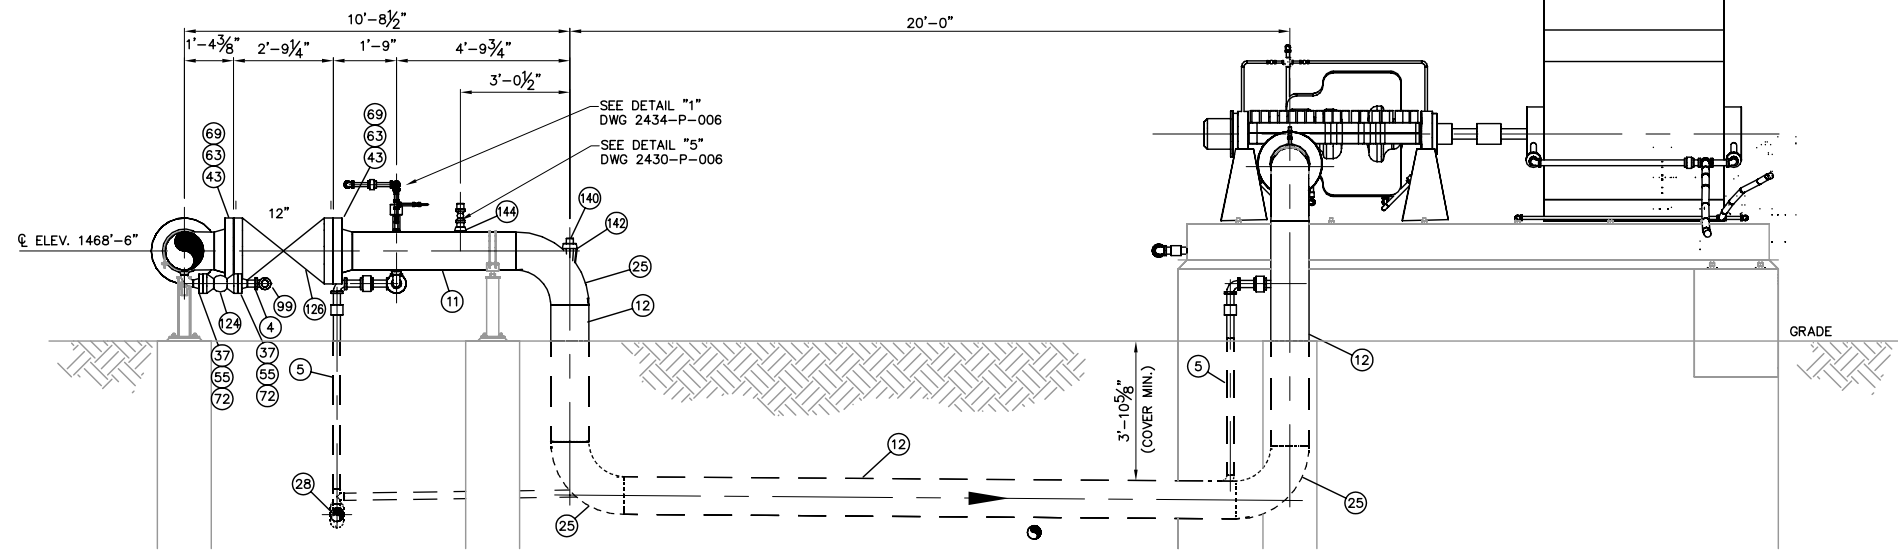

SECTION B  
SCALE 3/8"=1'-0" (B)

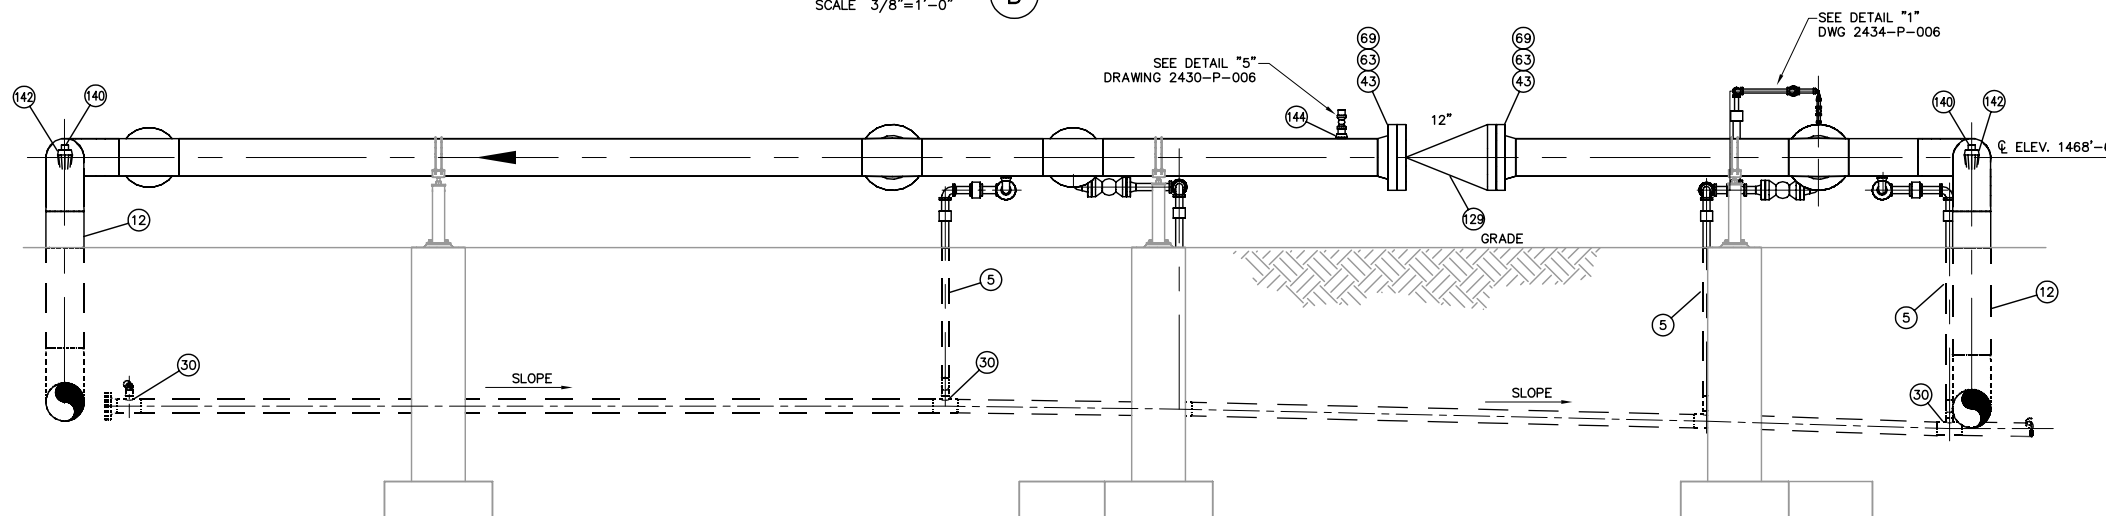

SECTION C  
SCALE 3/8"=1'-0" (C)


NO	REVISION	DATE	APPR	BY
1	AS-BUILT	01/25/08	EK	ADJ
0	ISSUED FOR CONSTRUCTION	6/25/07	EK	ADJ

**ENBRIDGE PIPELINES (ND)**

**PENN (ND) STATION**  
PIPING SECTIONS

PROJECT:	SCALE: AS NOTED	DATE: 1/18/07	DRAWN: ADJ
CHECK:	APPR:	DATE:	

DWG. NO. 2430-P-004

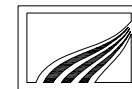

**Rooney Engineering, Inc.**  
12201 E. Arapahoe Rd.  
Centennial, CO 80112  
(303) 792-5911