

Hamre, John G.

From: Todd Kranda [kranda@kelschlaw.com]
Sent: Thursday, June 12, 2008 1:37 PM
To: -Info-Aeronautics Commission; -Info-Dept. of Agriculture; -Info-Attorney General; Dwelle, Terry L.; -Info-DHS Executive Office; -Info-Labor Dept.; -Info-Dept. of Career & Technical Education; Lucy, Paul J.; Engleson, Jeff A.; -Info-Game & Fish Dept.; Murphy, Ed C.; -Info-Governor's Office; -Info-Dept. of Transportation; Paaverud, Merl E.; Kulas, Cheryl M.; Brostrom, Darren W.; Preszler, Gary D.; -Info-Parks & Recreation; Govig, Paul T.; Stott.hochhalter@ndsu.edu; -Info-State Water Commission; Daley, Maren L.
Cc: Fahn, Patrick J.; Binek, William W.; 'Thomas D Kelsch'
Subject: RE: Notice of Deadline for Any Comment to PSC by 5:00 PM central Monday June 16, 2008
Attachments: Substitute Exhibit D ND-365-1-rev1.pdf

JUN 12 2008

PUBLIC SERVICE COMMISSION

June 12, 2008

Notice to State Agencies and Officials as Identified Pursuant to Section 69-06-01-05 ND Admin Code:

TransCanada Keystone Pipeline has filed with the North Dakota Public Service Commission (PSC) a Substitute Exhibit D relating to the previously filed Motion dated May 27, 2008 for approval of two route refinements within the approved corridor. The Substitute Exhibit D document is a map which slightly adjusted the route refinement to avoid a residence by at least 500 feet which existed along one of the two proposed route refinements that were submitted and relates to what is referred to as the Capp Route Refinement in Walsh County. The motion was partially approved by the PSC for one of the two route refinements and is pending regarding the second route refinement in order to allow either the filing of a waiver or an adjustment of the route to accommodate for the 500-foot buffer for the residential avoidance requirement.

Keystone is providing this email notice to each agency and state official with a deadline for comment on the pending Motion for the route refinement that has been filed with the PSC. This email is intended to be such notification to you that any comments on the pending motion be provided by email response or in writing to the PSC located at 600 East Boulevard - Dept 408 in Bismarck, with a copy of such written comments also sent to the undersigned, by **no later than 5:00 p.m. central time on Monday, June 16, 2008.**

A request is being made by Keystone for the PSC to complete its review and determination regarding this pending request for approval of route refinement as it relates to the so-called Capp Route Refinement now that the residence is being avoided. A hearing was previously held by the PSC and now this filing should complete the record to allow consideration of and issuance of a determination on this route refinement request. Thank you for your attention to this matter.

Sincerely,

Todd D. Kranda
Attorney for TransCanada Keystone Pipeline

c: Patrick Fahn, Staff with Public Service Commission
William W. Binek, Attorney for Public Service Commission
Thomas D. Kelsch, Attorney for TransCanada Keystone Pipeline

KELSCH KELSCH RUFF & KRANDA

517 PU-06-421 Filed: 6/12/2008 Pages: 3
Email to State Agencies and Officials re Deadline for
Comment on Motion to Route Refinement

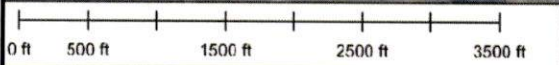
TransCanada Keystone Pipeline, LP

KelschKelschRuff&Kranda, by Todd Kranda

NOTICE: This e-mail, including attachments, is covered by the Electronic Communications Privacy Act, 18 U.S.C. 2510 et seq., is confidential, and/or



is legally privileged. The preceding message and / attachments are intended only for the use of the addressee and may contain information that is privileged and confidential. If the reader of this message is not the intended recipient or an authorized representative of the intended recipient, you are hereby notified that any dissemination of this communication is strictly prohibited. If you have received this communication in error, please 1) notify us immediately by e-mail to kranda@kelschlaw.com or by telephone at 701-663-9818 (toll free at 1-888-663-9818); 2) delete this e-mail, including deletion of all associated text files from all storage locations including individual and network storage devices; and 3) refrain from disseminating or copying this communication. Thank you.

Todd D. Kranda
Kelsch Kelsch Ruff & Kranda
103 Collins Avenue, PO Box 1266
Mandan ND 58554-7266
Phone 701-663-9818 (toll free 1-888-663-9818)
Fax 701-663-9810
kranda@kelschlaw.com



Red Line—Keystone Centerline Orange Line—Original Reroute Yellow Line—Capp Reroute

Capp Reroute Walsh County, ND

		TROW ENGINEERING CONSULTANTS INC. 1300 Metropolitan Blvd. Suite 200 Tallahassee, Florida 32308 Phone: 1-850-385-5441 Fax: 1-850-385-5523			
TROW PROJ. No.:	THES0050388S	KEYSTONE PIPELINE PROJECT ROUTE VARIATION: 363-ND-40.3-51.9-S			
DRAWN BY:	TB	DRAWING No.:	ND-365-1-rev1	REV.	1
CHECKED BY:	SS	DATE:	JUN 11 08		