

Hamre, John G.

From: Todd Kranda [kranda@kelschlaw.com]
Sent: Thursday, July 10, 2008 5:36 PM
To: Roppel, Dawn M.; rflander@utma.com; Robinson, Dorothy L.; hwalker@polarcomm.com; Kinsala, Sharon D.; lmeberg@polarcomm.com; Davidson, W. Jack; eyef@gondt.com; Leadbetter, Linda S.; tjamundson@invisimax.com; McGough, Edward R.; cindy.schwehr@smphs.org; sherry.hosford@co.sargent.nd.us; pmorn@drtel.net; connie.gilbert@co.ransom.us; kjbishop@ictc.com
Cc: Fahn, Patrick J.; 'Thomas D Kelsch'; Jeffcoat-Sacco, Illona
Subject: RE: Notice of Deadline for Any Comment to PSC by 5:00 PM central Tuesday July 10, 2008
Attachments: 6 Exhibit B - Map.pdf; Exh A - ND-388-1-rev1.pdf

July 10, 2008

Notice to County Auditors and County Commissions Pursuant to Section 69-06-01-02 ND Admin Code:

TransCanada Keystone Pipeline has filed with the North Dakota Public Service Commission (PSC) a Motion dated July 10, 2008 for approval of a route refinement in Barnes County within the approved corridor. The proposed route refinement is limited and relates to a certain adjustment along the route to accommodate landowners involved and are deemed necessary for a voluntary easement acquisition.

As additional information to assist you in identifying the specific area involved with the Motion for route refinement, attached please find a PDF copy of Exhibit A the route refinement map and Exhibit B revised route map. On Exhibit A the route refinement that is being considered for this matter is shown as the fuchsia/pink line on the map which is the easterly most route.

Keystone is providing this email notice to each agency and state official with a deadline for comment on the pending Motion for route refinement that has been filed with the PSC. This email is intended to be such notification to you that any comments on the pending motion be provided by email response or in writing to the PSC located at 600 East Boulevard - Dept 408 in Bismarck, with a copy of such written comments also sent to the undersigned, by **no later than 5:00 p.m.** central time on **Tuesday, July 15, 2008.**

A request was made by Keystone for the PSC to expedite its review and determination regarding the pending request for approval of this route refinement. Thank you for your attention to this matter.

Sincerely,

Todd D. Kranda
Attorney for TransCanada Keystone Pipeline

c: Patrick Fahn, Staff with Public Service Commission
Illona Jeffcoat Sacco, Attorney for Public Service Commission
Thomas D. Kelsch, Attorney for TransCanada Keystone Pipeline

556 PU-06-421 Filed: 7/10/2008 Pages: 4
**Notice to County Auditors and County Commissions
for Approval of Route Refinement + Maps**


TransCanada Keystone Pipeline, LP

KELSCH KELSCH RUFF & KRANDA


NOTICE: This e-mail, including attachments, is covered by the Electronic Communications Privacy Act, 18 U.S.C. 2510 et seq., is confidential, and/or is legally privileged. The preceding message and any attachments are intended only for the use of the addressee and may contain information that is privileged and confidential. If the reader of this message is not the intended recipient or an authorized representative of the intended recipient, you are hereby notified that any dissemination of this communication is strictly prohibited. If you have received this communication in error, please

1) notify us immediately by e-mail to kranda@kelschlaw.com or by telephone at 701-663-9818 (toll free at 1-888-663-9818); 2) delete this e-mail, including deletion of all associated text files from all storage locations including individual and network storage devices; and 3) refrain from disseminating or copying this communication. Thank you.


Todd D. Kranda
Kelsch Kelsch Ruff & Kranda
103 Collins Avenue, PO Box 1266
Mandan ND 58554-7266
Phone 701-663-9818 (toll free 1-888-663-9818)
Fax 701-663-9810
kranda@kelschlaw.com

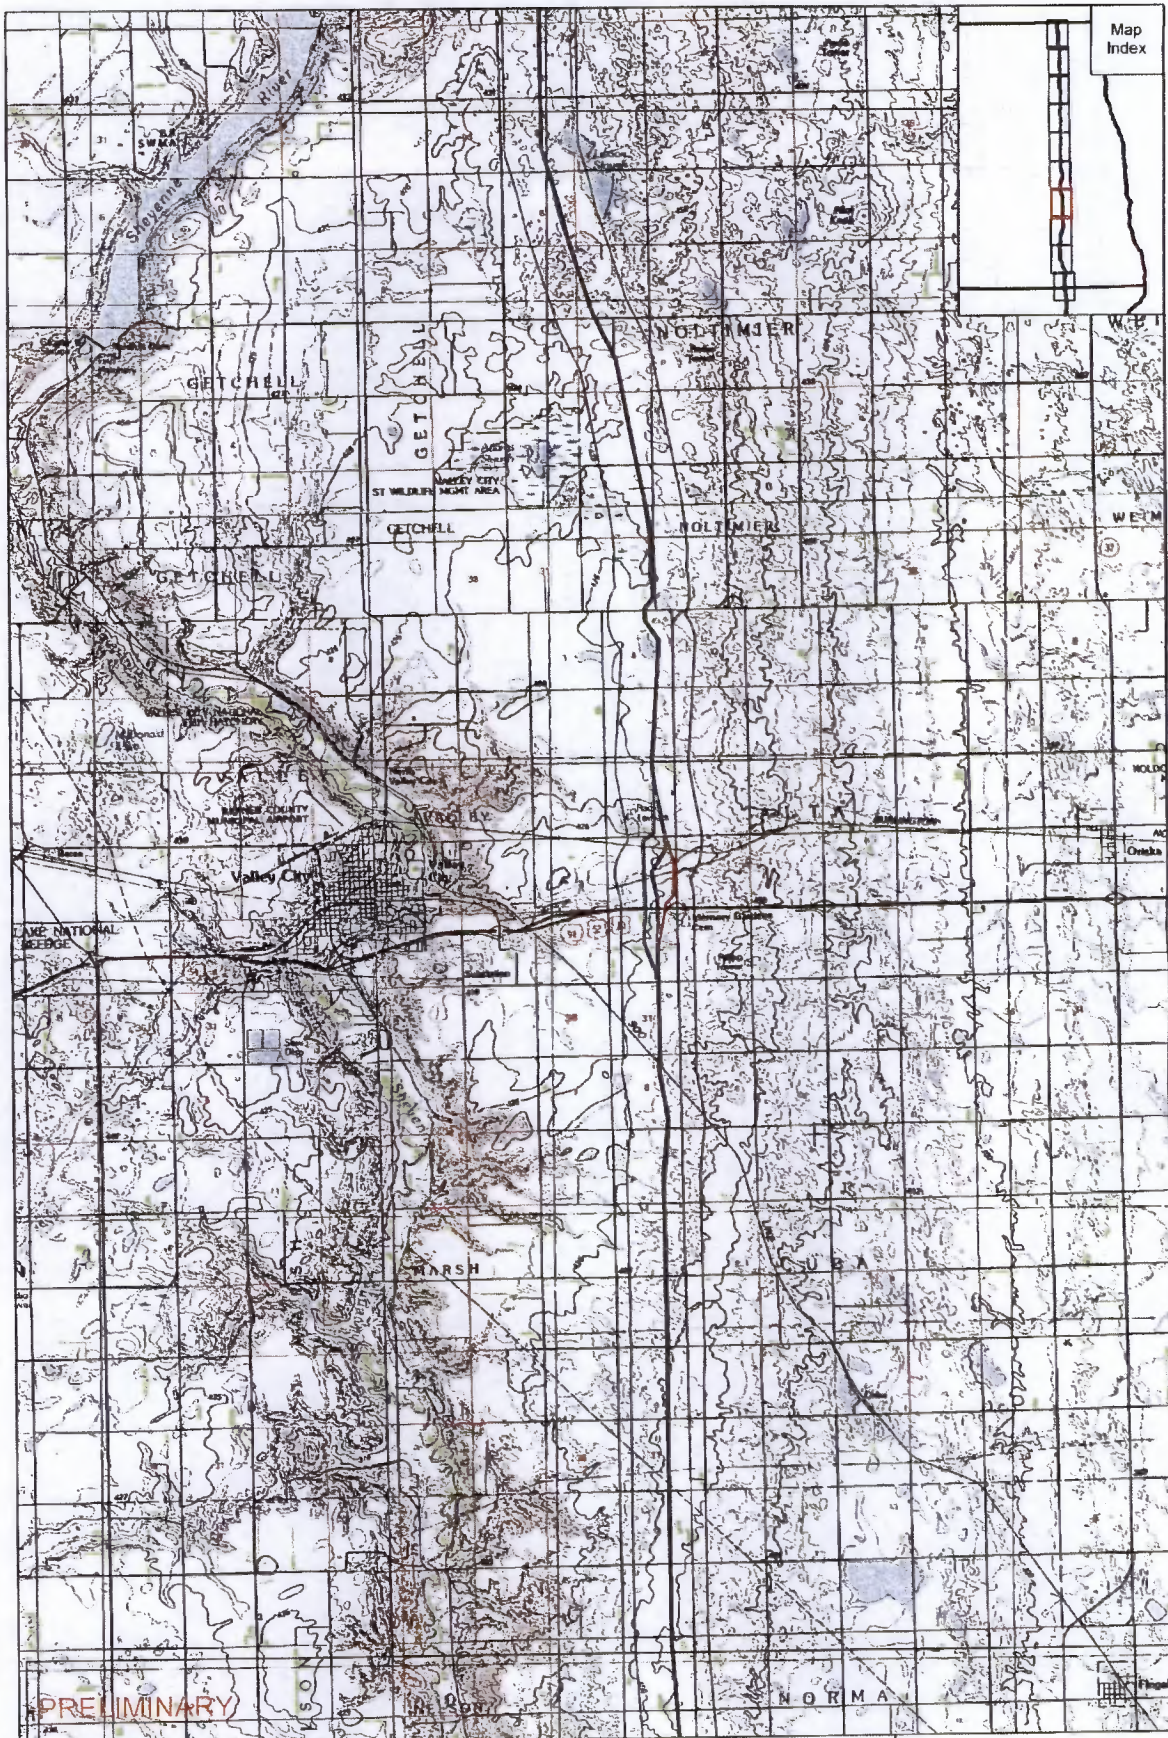

- Mispasts (March 13, 2008)
- Proposed Pipeline (March 13, 2008)
- Half-mile Buffer (March 13, 2008)
- Proposed Pipeline (March 2, 2007)
- Pipeline Reroute (April 28, 2006)
- Pipeline Reroute (May 23, 2006)
- 2nd Alternative Route (July 9, 2006)


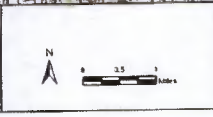


Keystone Pipeline Project



TransCanada
in business to deliver

Map 7 of 10
General Project Location
Topographic Map (1:100,000 scale)
(North Dakota)

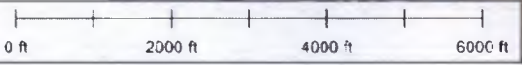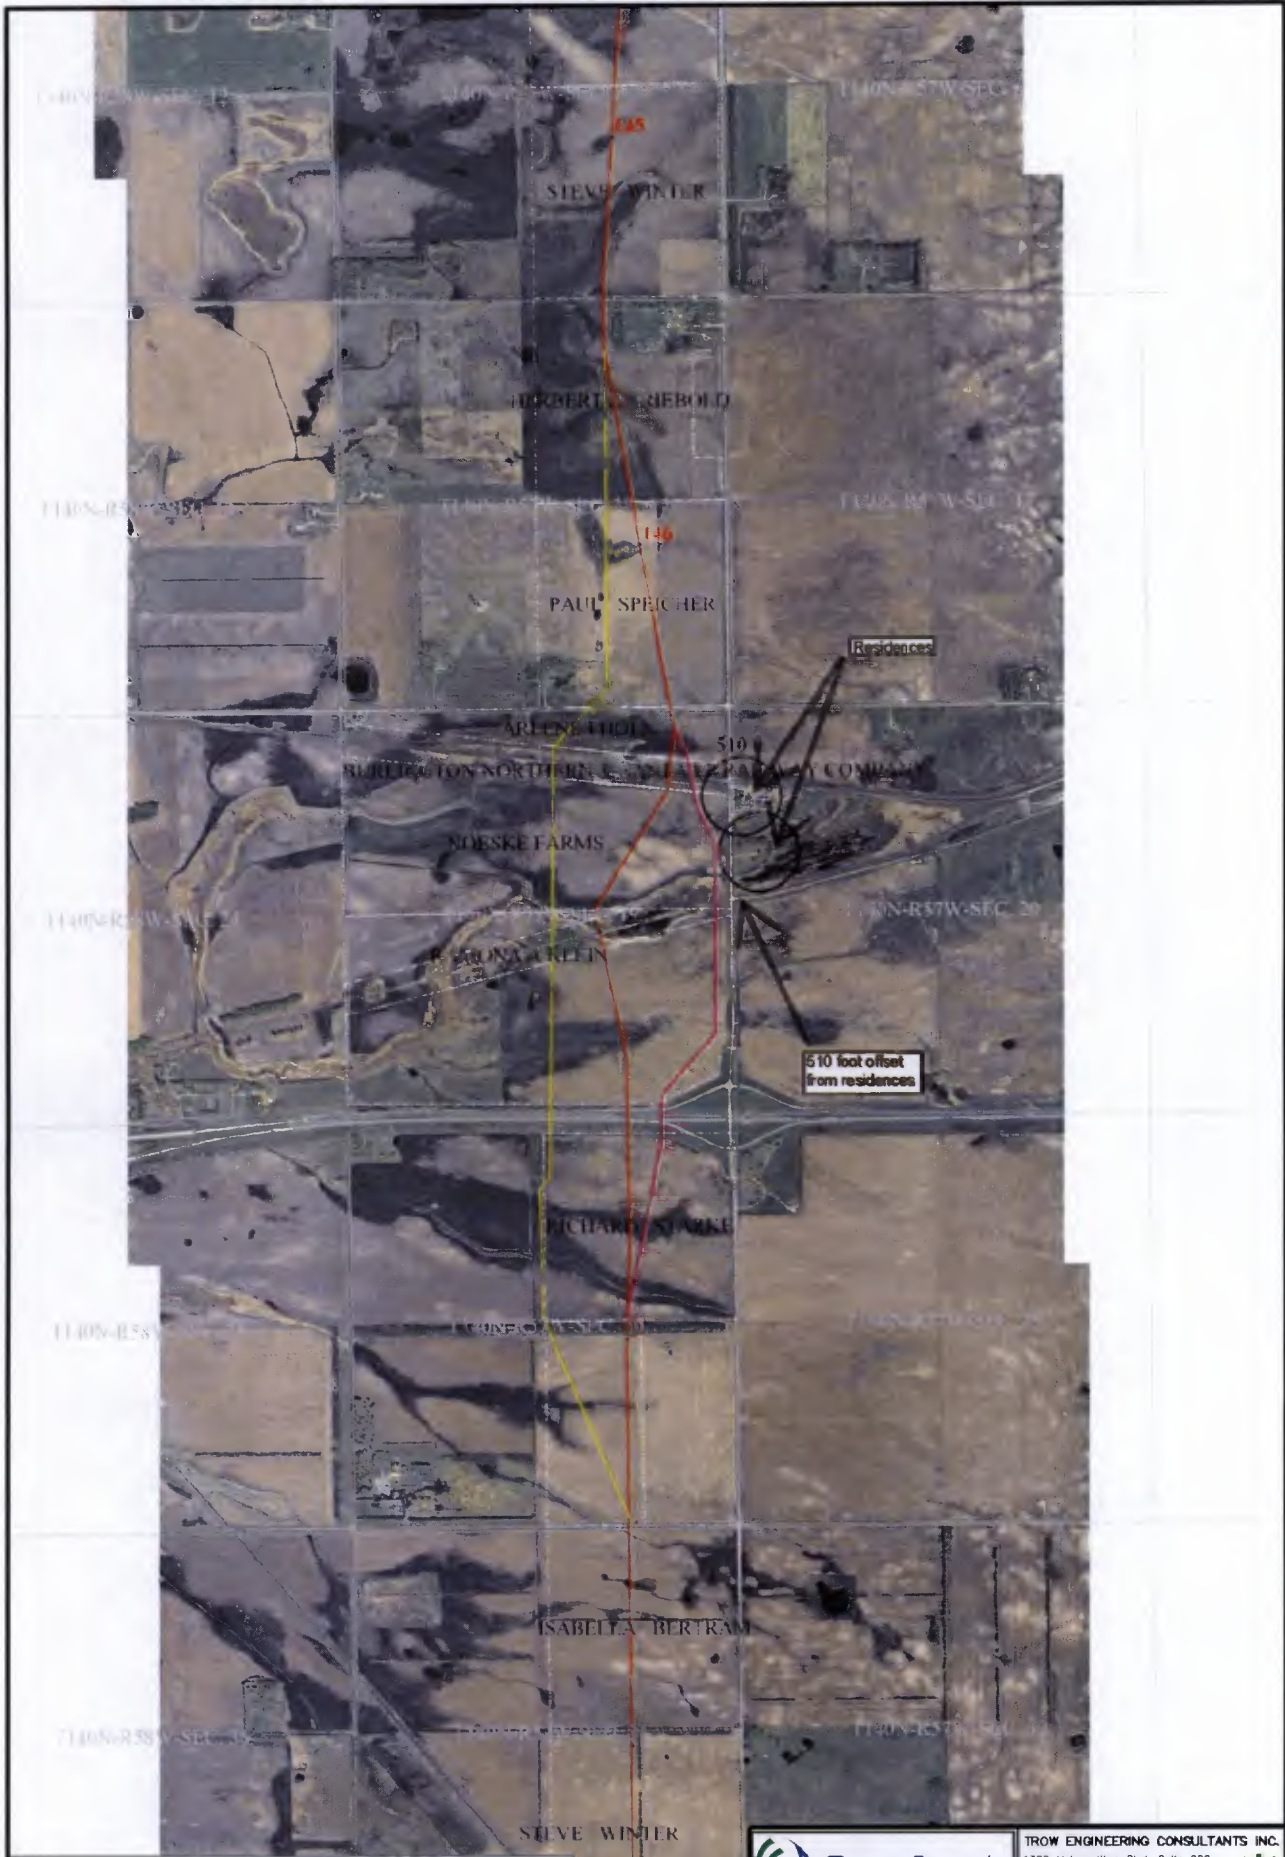

Red Line – Original Keystone Centerline
 Yellow Line – 1st Alternate Route Approved by Commission April 28, 2008
 Pink Line – 2nd Alternate Route July 9, 2008



TROW ENGINEERING CONSULTANTS INC.
 1300 Metropolitan Blvd, Suite 200
 Tallahassee, Florida 32306
 Phone: 1-850-385-5441
 Fax: 1-850-385-5523



TROW PROJ. No.:	THES0050388S
DRAWN BY:	TB
CHECKED BY:	SS
DATE:	JUL 9 08

KEYSTONE PIPELINE PROJECT	
ROUTE VARIATION: 356-ND-145.4-148.4-3	
DRAWING No.:	REV.
ND-388-1-rw1	1