


DATE OF AERIAL PHOTOGRAPHY  
DOWNLOADED ON JULY 21, 2009  
TERRASERVER

DATE OF AERIAL PHOTOGRAPHY  
NOVEMBER 08, 2007  
GEODIGITAL INTERNATIONAL

STEEL DE A-FRAME STA=0+00.00 55 FT TAKEOFF STR. OPGW DE	ST1-118 STA=5+80.00 001	SD90-095 STA=346+67.52 002 AP 1	ST-124 STA=354+70.00 003
--	-------------------------------	--	--------------------------------

PROFILE 20' LEFT  
PROFILE 20' RIGHT  
26 FT CLEARANCE 212 F (100 C)

200.0 FT. HORIZ. SCALE  
20.0 FT. VERT. SCALE

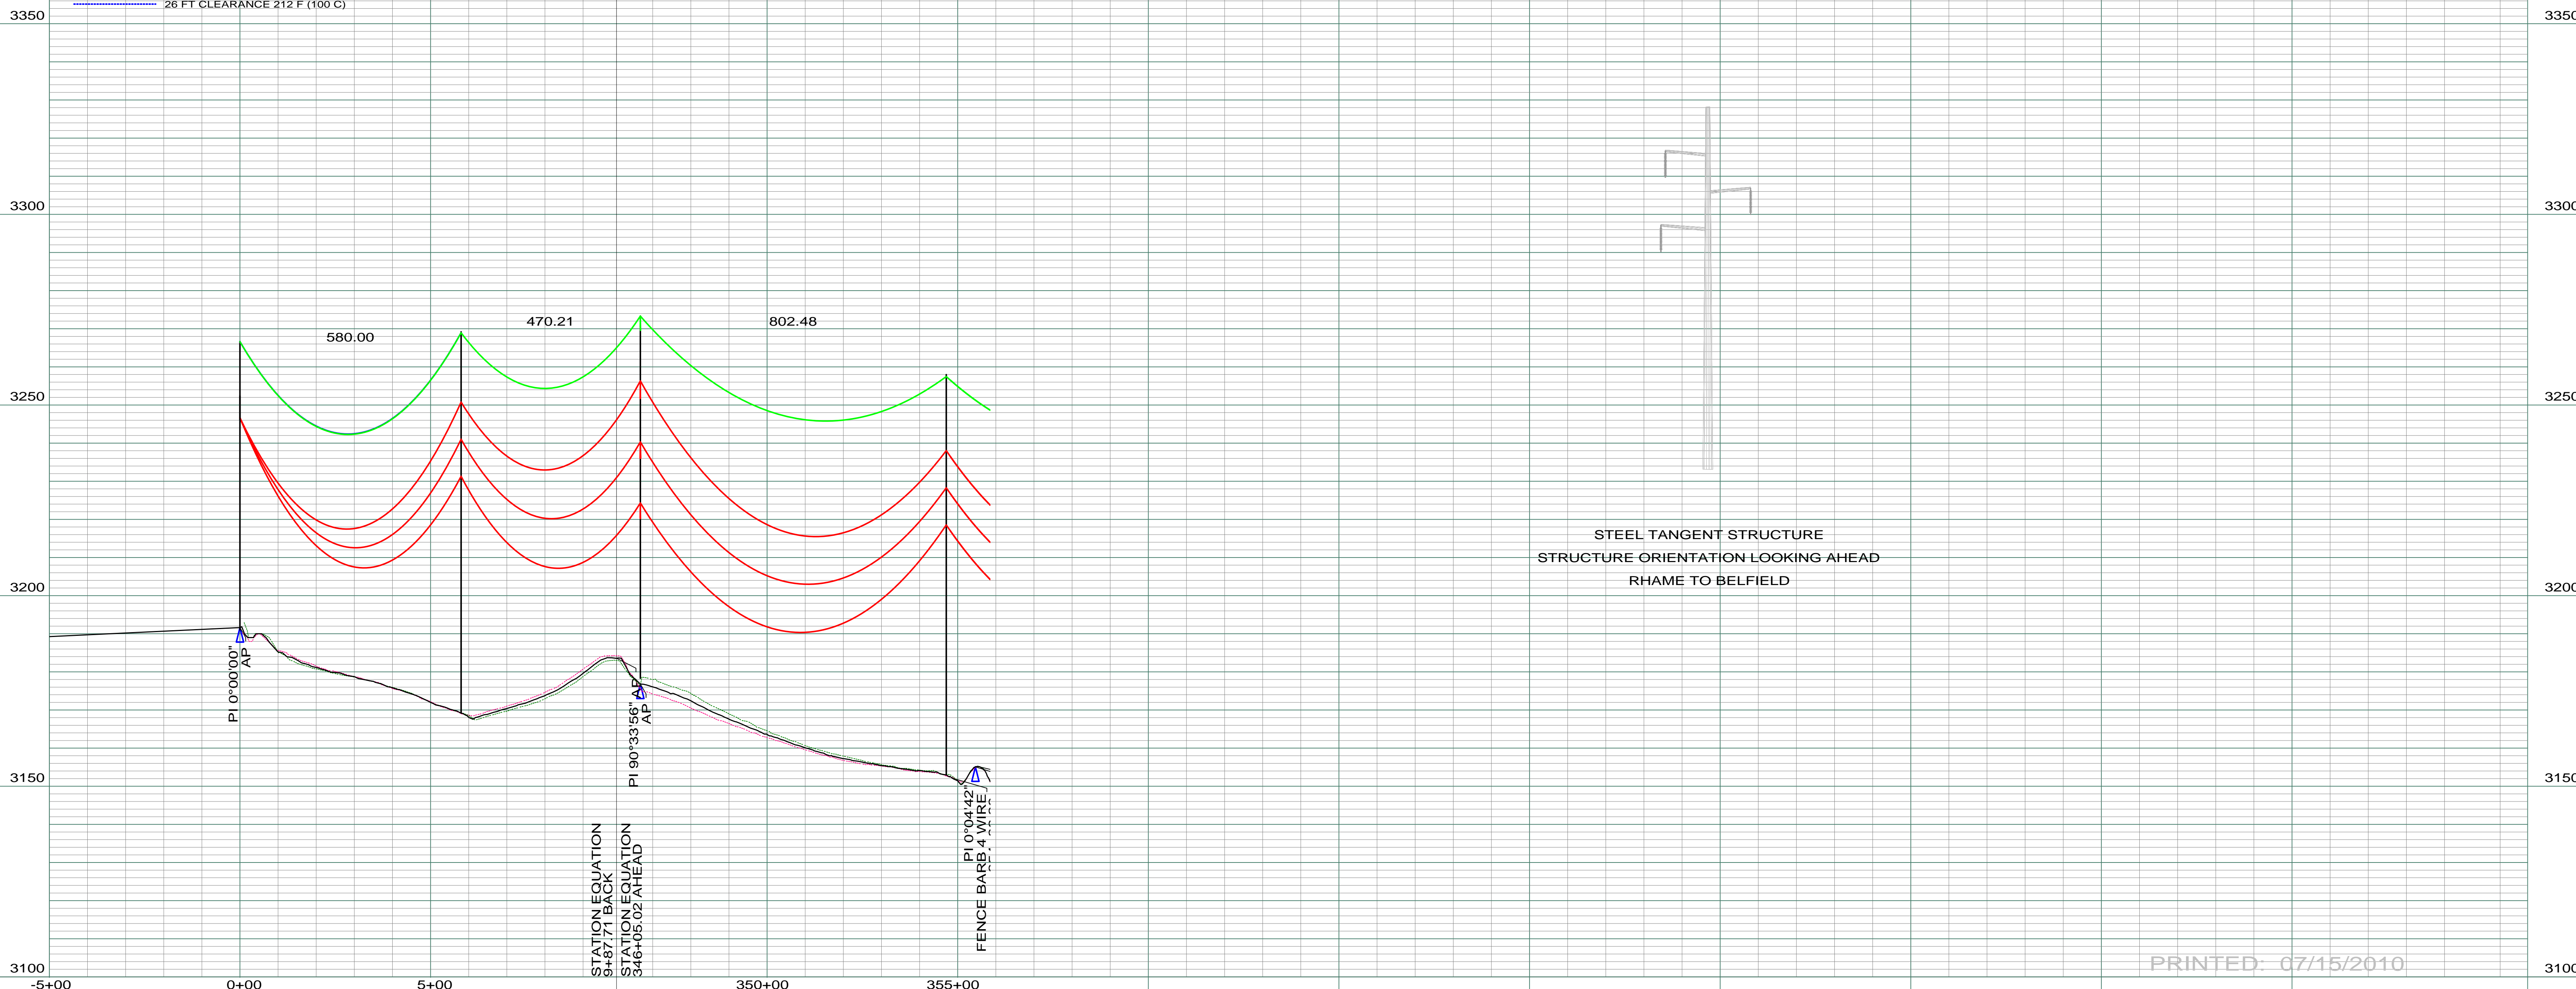

REV	DESCRIPTION	DRWN	DSGN	APPD	DATE	REV	DESCRIPTION	DRWN	DSGN	APPD	DATE
1	ISSUE TO PUBLIC SERVICE COMMISSION	CDB	CDB	DAM	09-05-08	5	AS-BUILT	CDB	CDB	DAM	07-16-10
2	RELEASED FOR BID	CDB	CDB	DAM	01-15-09						
3	MOVED TAKE-OFF STR. RE-NAMED STR 1 TO ST1, UPDATED GRADING AND SUBSTATION PLAN, ISSUED FOR CONSTRUCTION	CDB	CDB	DAM	03-17-09						
4	ADDED TERRASERVER IMAGERY, DATE OF PHOTOGRAPHY UNKNOWN	CDB	CDB	DAM	07-21-09						

DESIGN INFORMATION		DESIGN RULING SPAN	ACTUAL RULING SPAN
CONDUCTOR	1272 MCM 45/7 ACSR	800	0
OPGW	AC-71/571	0	0

DESIGN BY:	DATE
DAM/CDB	08-08-08
DRAWN BY:	DATE
CDB	08-08-08
DESIGN CHK:	DATE
SW/ULTEIG	08-08-08
DRAFT CHK:	DATE
APPROVED:	DATE
DAM	09-05-08

STATE NAME: NORTH DAKOTA  
NAD83 NDSPCS INTL FT SOUTH ZONE

FACILITY: TRANSMISSION SYSTEM MAINTENANCE  
LOCATION UNIT: 181-230KV LINE-RHAME SUBSTATION TO BELFIELD SUBSTATION

RHAME TO BELFIELD 230KV TRANSMISSION LINE  
PLAN AND PROFILE  
MILE 1 & FROM RHAME SUBSTATION

BASIN ELECTRIC POWER COOPERATIVE  
1717 EAST INTERSTATE AVENUE  
BISMARCK, NORTH DAKOTA  
PHONE 701-223-0441

SCALE: AS SHOWN  
COUNTY NAME: BOWMAN  
BASIN DRAWING NO. 181-090-T3-001  
REV. 5

PRINTED: 07/15/2010