

0050
 BRUCE & TERESA BOWMAN
 SE1/4 SEC. 2-T131N-R104W
 CENTERLINE LENGTH 2673.88'
 162.05 RODS - 7.67 ACRES

0060
 JAMES & LAVONNE LUTZ
 SW1/4 SEC. 1-T131N-R104W
 CENTERLINE LENGTH 2632.42'
 159.54 RODS - 7.55 ACRES

0070
 BRUCE T. BOWMAN
 SE1/4 SEC. 1-T131N-R104W
 CENTERLINE LENGTH 2632.44'
 159.54 RODS - 7.55 ACRES

**NE 1/4
 SEC. 11 T131N R104W
 BOWMAN CO., NORTH DAKOTA**

**NW 1/4
 SEC. 12 T131N R104W
 BOWMAN CO., NORTH DAKOTA**


DATE OF AERIAL PHOTOGRAPHY
 NOVEMBER 08, 2007
 GEODIGITAL INTERNATIONAL



ST-129 STA=468+40.00 019	ST-118 STA=476+00.00 020	ST-118 STA=484+40.00 021	ST-113 STA=491+50.00 022	ST-113 STA=498+70.00 023	ST-118 STA=506+90.00 024	ST-096 STA=512+70.00 025	ST-107 STA=517+80.00 026	ST-118 STA=526+30.00 027
--------------------------------	--------------------------------	--------------------------------	--------------------------------	--------------------------------	--------------------------------	--------------------------------	--------------------------------	--------------------------------

- PROFILE 20' LEFT
- PROFILE 20' RIGHT
- 26 FT CLEARANCE 212 F (100 C)

200.0 FT. HORIZ. SCALE
 20.0 FT. VERT. SCALE

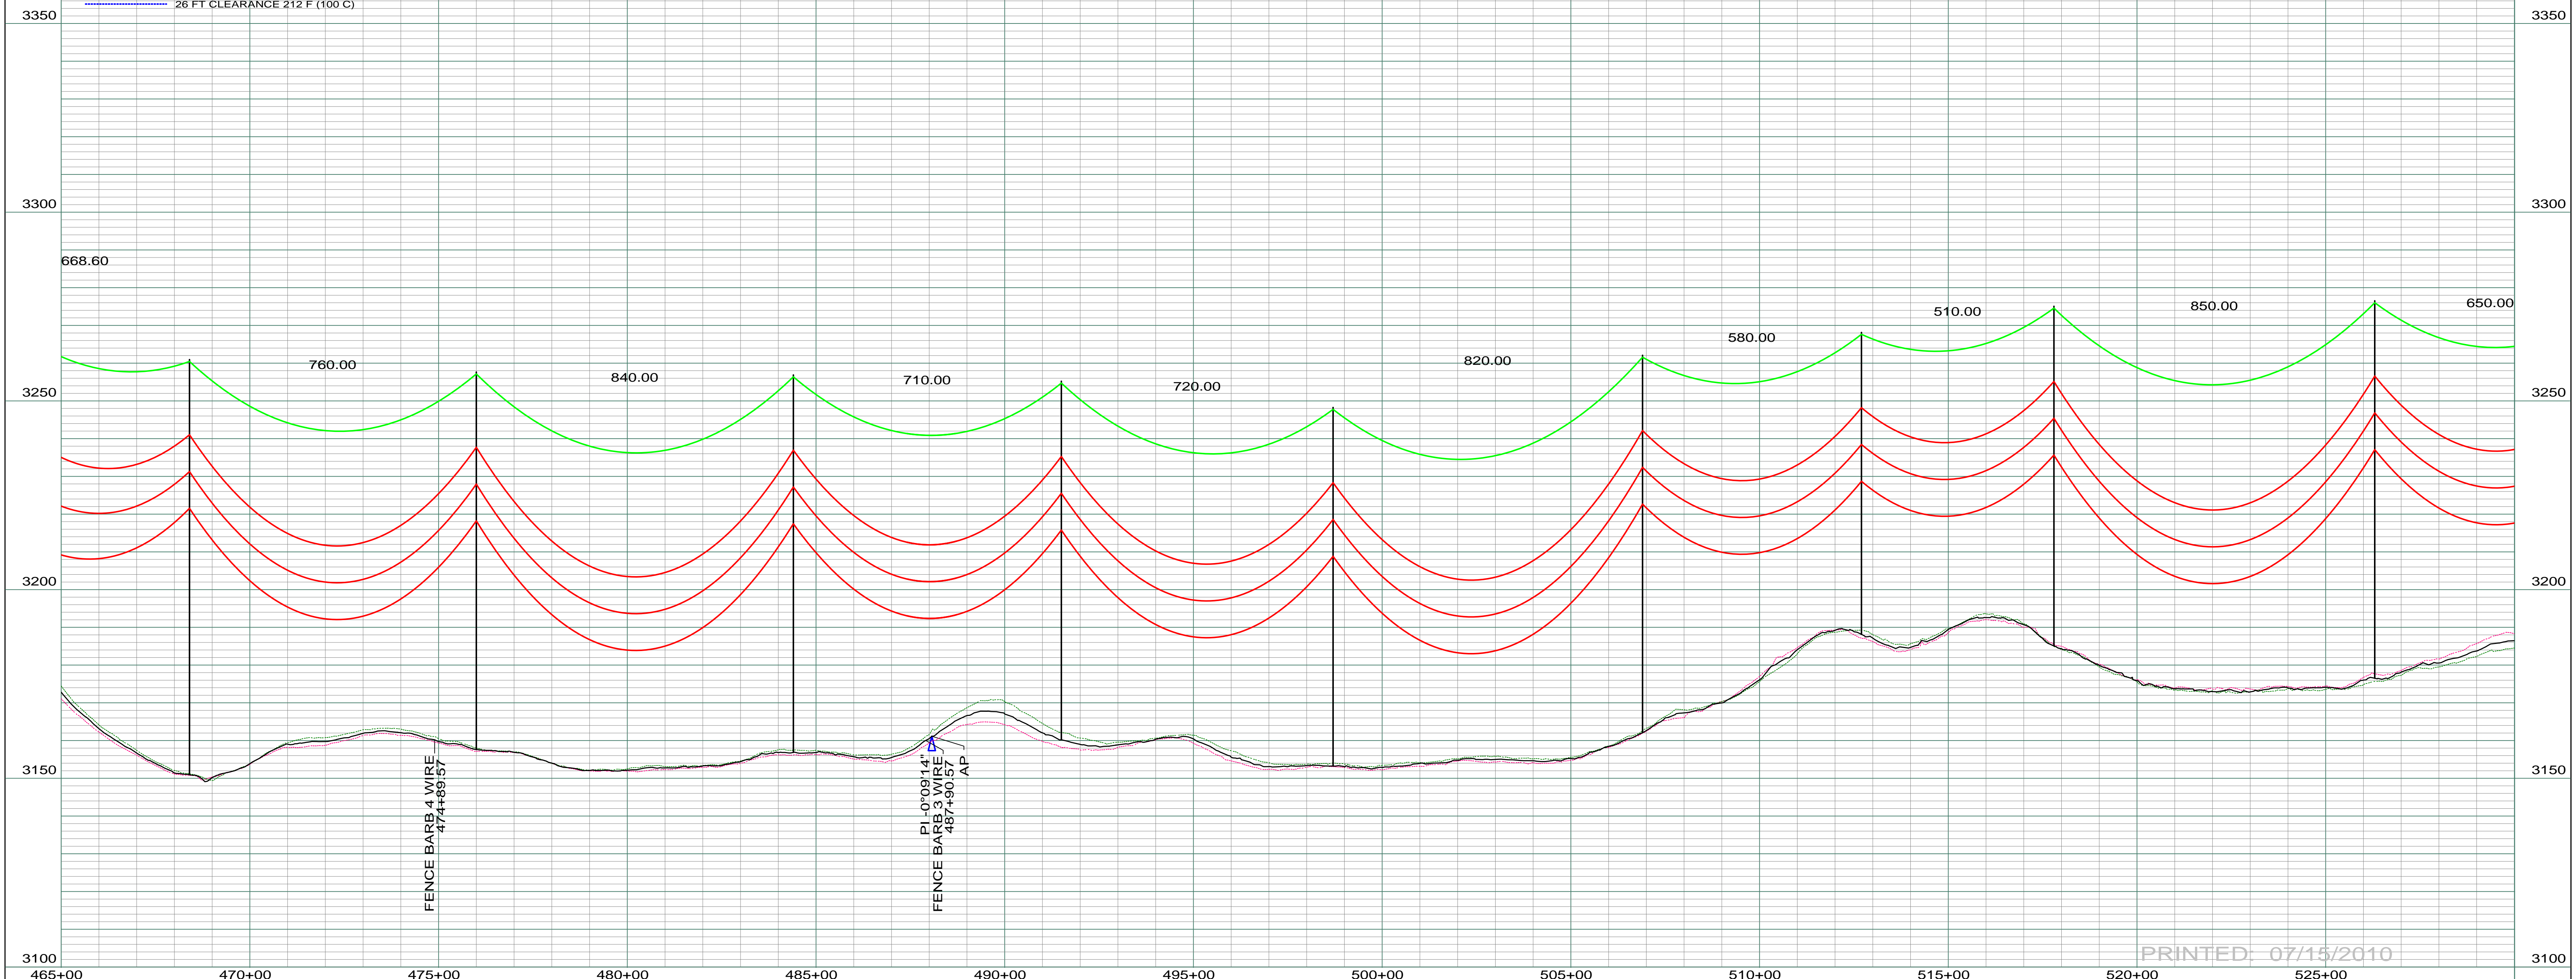

PRINTED: 07/15/2010

REV	DESCRIPTION	DRWN	DSGN	APPD	DATE	REV	DESCRIPTION	DRWN	DSGN	APPD	DATE	STATE NAME: NORTH DAKOTA	NAD83 NDSPCS INTL FT SOUTH ZONE	DESIGN BY: DAM/CDB	08-08-08	FACILITY: TRANSMISSION SYSTEM MAINTENANCE	BASIN ELECTRIC POWER COOPERATIVE 1717 EAST INTERSTATE AVENUE BISMARCK, NORTH DAKOTA PHONE 701-223-0441	COUNTY NAME: BOWMAN	
1	ISSUE TO PUBLIC SERVICE COMMISSION	CDB	CDB	DAM	09-05-08							DESIGN BY: DAM/CDB	08-08-08	LOCATION UNIT: 181-230KV LINE-RHAME SUBSTATION TO BELFIELD SUBSTATION	SCALE: AS SHOWN	REV. 4			
2	UPDATED RIGHT-OF-WAY, RELEASED FOR BID	CDB	CDB	DAM	01-15-09							DESIGN CHK: SW/ULTEIG	08-08-08	RHAME TO BELFIELD 230KV TRANSMISSION LINE PLAN AND PROFILE MILE 2 & 3					
3	ISSUED FOR CONSTRUCTION	CDB	CDB	DAM	03-30-09							DRAFT CHK:							
4	AS-BUILT	CDB	CDB	DAM	07-16-10							APPROVED: DAM	09-05-08						
												CONDUCTOR	1272 MCM 45/7 ACSR	0	800	0			
												OPGW	AC-71/571	0					