


DATE OF AERIAL PHOTOGRAPHY
NOVEMBER 09, 2007
GEODIGITAL INTERNATIONAL

ST-107 STA=1643+60.00 175	ST-107 STA=1651+20.00 176	ST-107 STA=1658+50.00 177	ST-107 STA=1665+40.00 178	ST-091 STA=1672+70.00 179	ST-096 STA=1678+10.00 180	ST-107 STA=1684+20.00 181	ST-102 STA=1692+00.00 182	ST-113 STA=1698+30.00 183
---------------------------------	---------------------------------	---------------------------------	---------------------------------	---------------------------------	---------------------------------	---------------------------------	---------------------------------	---------------------------------

PROFILE 20' LEFT
 PROFILE 20' RIGHT
 26 FT CLEARANCE 212 F (100 C)

200.0 FT. HORIZ. SCALE
 20.0 FT. VERT. SCALE

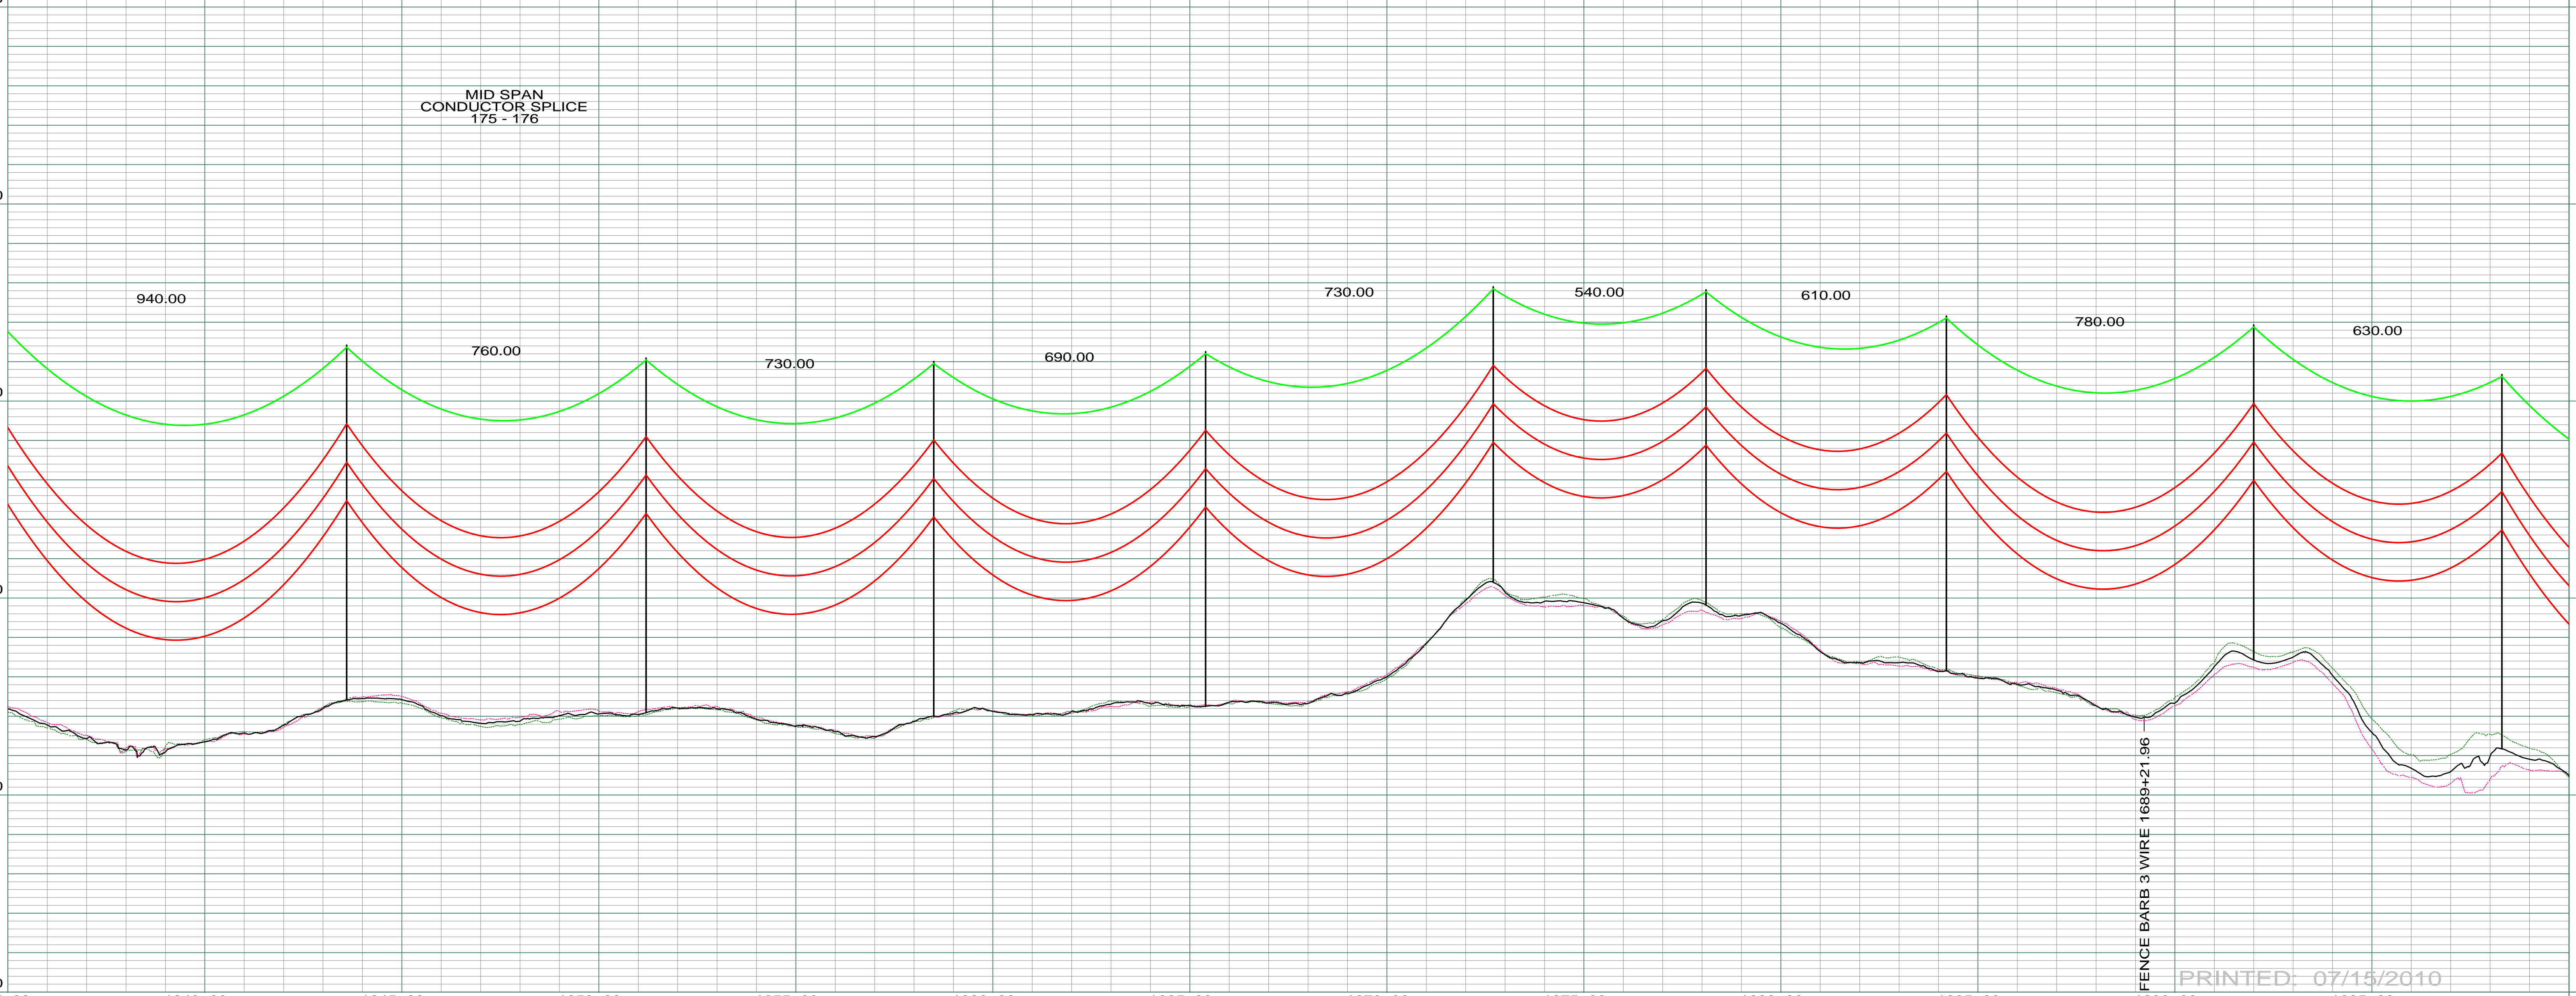

PRINTED: 07/15/2010

REV	DESCRIPTION	DRWN	DSGN	APPD	DATE	REV	DESCRIPTION	DRWN	DSGN	APPD	DATE	STATE NAME: NORTH DAKOTA	NAD83 NDSPCS INTL FT SOUTH ZONE	DESIGN BY: DAM/CDB	08-08-08	FACILITY: TRANSMISSION SYSTEM MAINTENANCE							
1	ISSUE TO PUBLIC SERVICE COMMISSION	CDB	CDB	DAM	09-05-08									DRAWN BY: CDB	08-08-08	LOCATION UNIT: 181-230KV LINE-RHAME SUBSTATION TO BELFIELD SUBSTATION							
2	RELEASED FOR BID	CDB	CDB	DAM	01-15-09									DESIGN CHK: SW/ULTEIG	08-08-08	RHAME TO BELFIELD 230KV TRANSMISSION LINE							
3	ISSUED FOR CONSTRUCTION	CDB	CDB	DAM	03-30-09									DRAFT CHK:		SCALE: AS SHOWN							
4	AS-BUILT	CDB	CDB	DAM	07-16-10									APPROVED: DAM	09-05-08	COUNTY NAME: BOWMAN							
												DESIGN INFORMATION		PLAN AND PROFILE		BASIN DRAWING NO. 181-090-T3-029		REV. 4					
												CONDUCTOR	1272 MCM 45/7 ACSR	STRINGING TENSION	0	DESIGN RULING SPAN	800	ACTUAL RULING SPAN	0	MILE 24 & 25			
												OPGW	AC-71/571	NESC TENSION	0								