


0520  
WAYNE NARUM  
E 1/2 SEC. 21-T133N-R100W  
CENTERLINE LENGTH 5272.37'  
319.54 RODS-15.13 ACRES

SW 1/4  
SEC. 22 T133N R100W  
SLOPE CO., NORTH DAKOTA

NW 1/4  
SEC. 22 T133N R100W  
SLOPE CO., NORTH DAKOTA

DATE OF AERIAL PHOTOGRAPHY  
NOVEMBER 08, 2007  
GEODIGITAL INTERNATIONAL

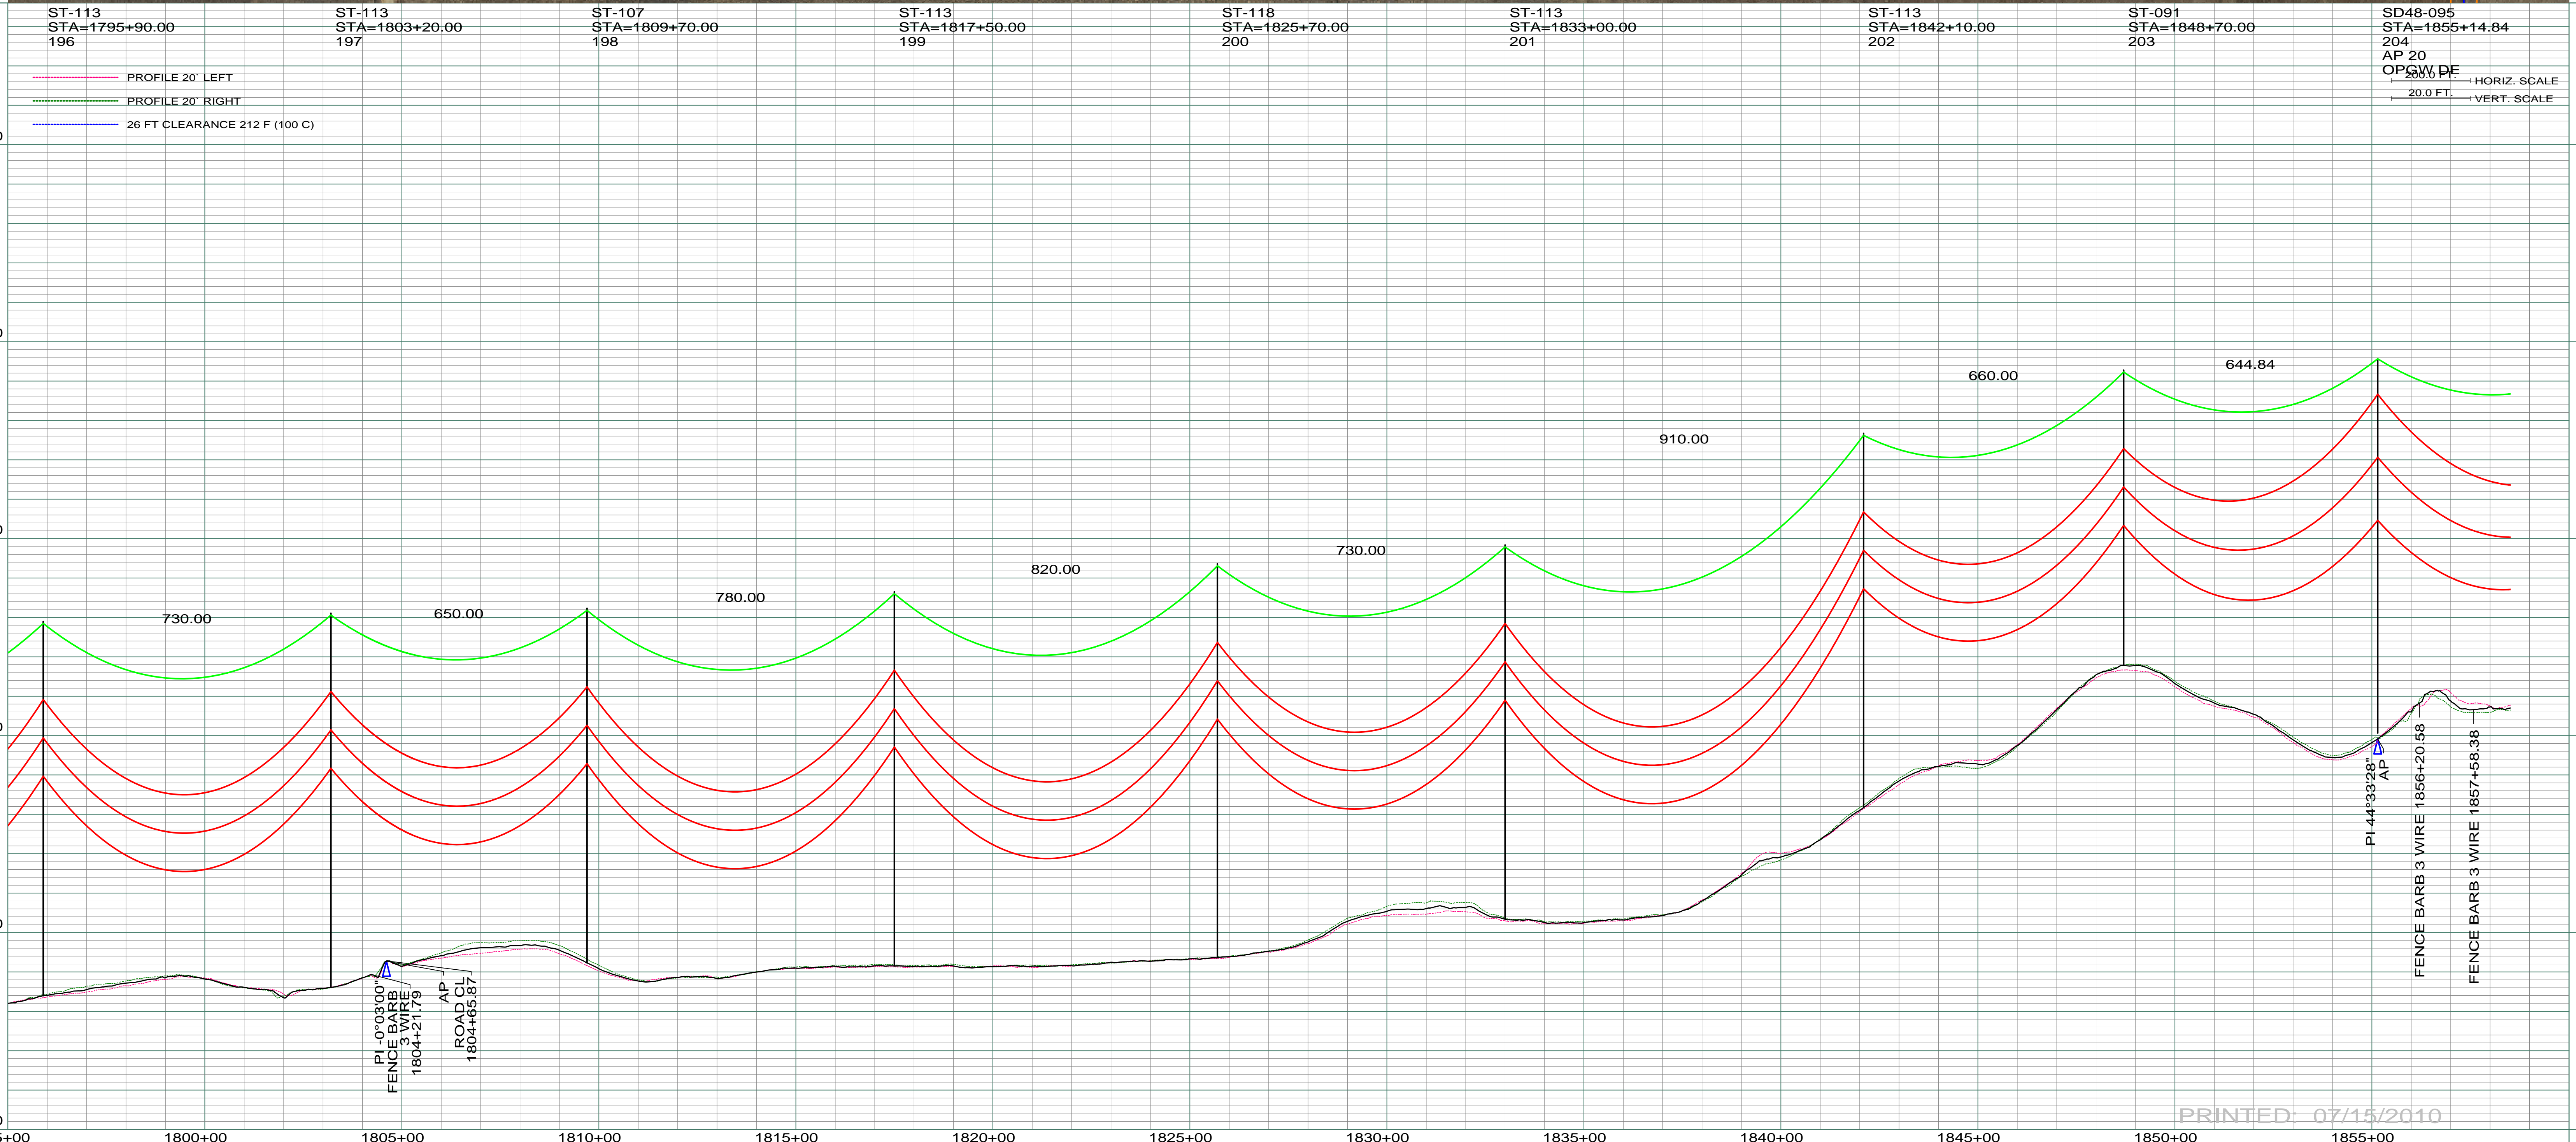

PRINTED: 07/15/2010

| REV | DESCRIPTION                        | DRWN | DSGN | APPD | DATE     | REV | DESCRIPTION | DRWN | DSGN | APPD | DATE | STATE NAME: NORTH DAKOTA |                    | NAD83 NDSPCS INTL FT SOUTH ZONE |         | DESIGN BY:                       | 08-08-08   | FACILITY: TRANSMISSION SYSTEM MAINTENANCE |  |
|-----|------------------------------------|------|------|------|----------|-----|-------------|------|------|------|------|--------------------------|--------------------|---------------------------------|---------|----------------------------------|--|---|--|
| 1   | ISSUE TO PUBLIC SERVICE COMMISSION | CDB  | CDB  | DAM  | 09-05-08 |     |             |      |      |      |      | DESIGN INFORMATION       |                    | DESIGN BY:                      | DAM/CDB | 08-08-08                         | LOCATION UNIT: TRANSMISSION SYSTEM MAINTENANCE         |   |  |
| 2   | RELEASED FOR BID                   | CDB  | CDB  | DAM  | 01-15-09 |     |             |      |      |      |      | CONDUCTOR                | 1272 MCM 45/7 ACSR | 0                               | 800     | 0                                | 181-230KV LINE-RHAME SUBSTATION TO BELFIELD SUBSTATION |   |  |
| 3   | ISSUED FOR CONSTRUCTION            | CDB  | CDB  | DAM  | 03-30-09 |     |             |      |      |      |      | OPGW                     | AC-71/571          | 0                               |         |                                  | RHAME TO BELFIELD 230KV TRANSMISSION LINE              |   |  |
| 4   | AS-BUILT                           | CDB  | CDB  | DAM  | 07-16-10 |     |             |      |      |      |      |                          |                    |                                 |         |                                  | SCALE: AS SHOWN  |   |  |
|     |                                    |      |      |      |          |     |             |      |      |      |      |                          |                    |                                 |         | COUNTY NAME: SLOPE               |  |   |  |
|     |                                    |      |      |      |          |     |             |      |      |      |      |                          |                    |                                 |         | BASIN DRAWING NO. 181-090-T3-032 |  |   |  |
|     |                                    |      |      |      |          |     |             |      |      |      |      |                          |                    |                                 |         | REV. 4                           |  |   |  |