


DATE OF AERIAL PHOTOGRAPHY  
NOVEMBER 08, 2007  
GEODIGITAL INTERNATIONAL

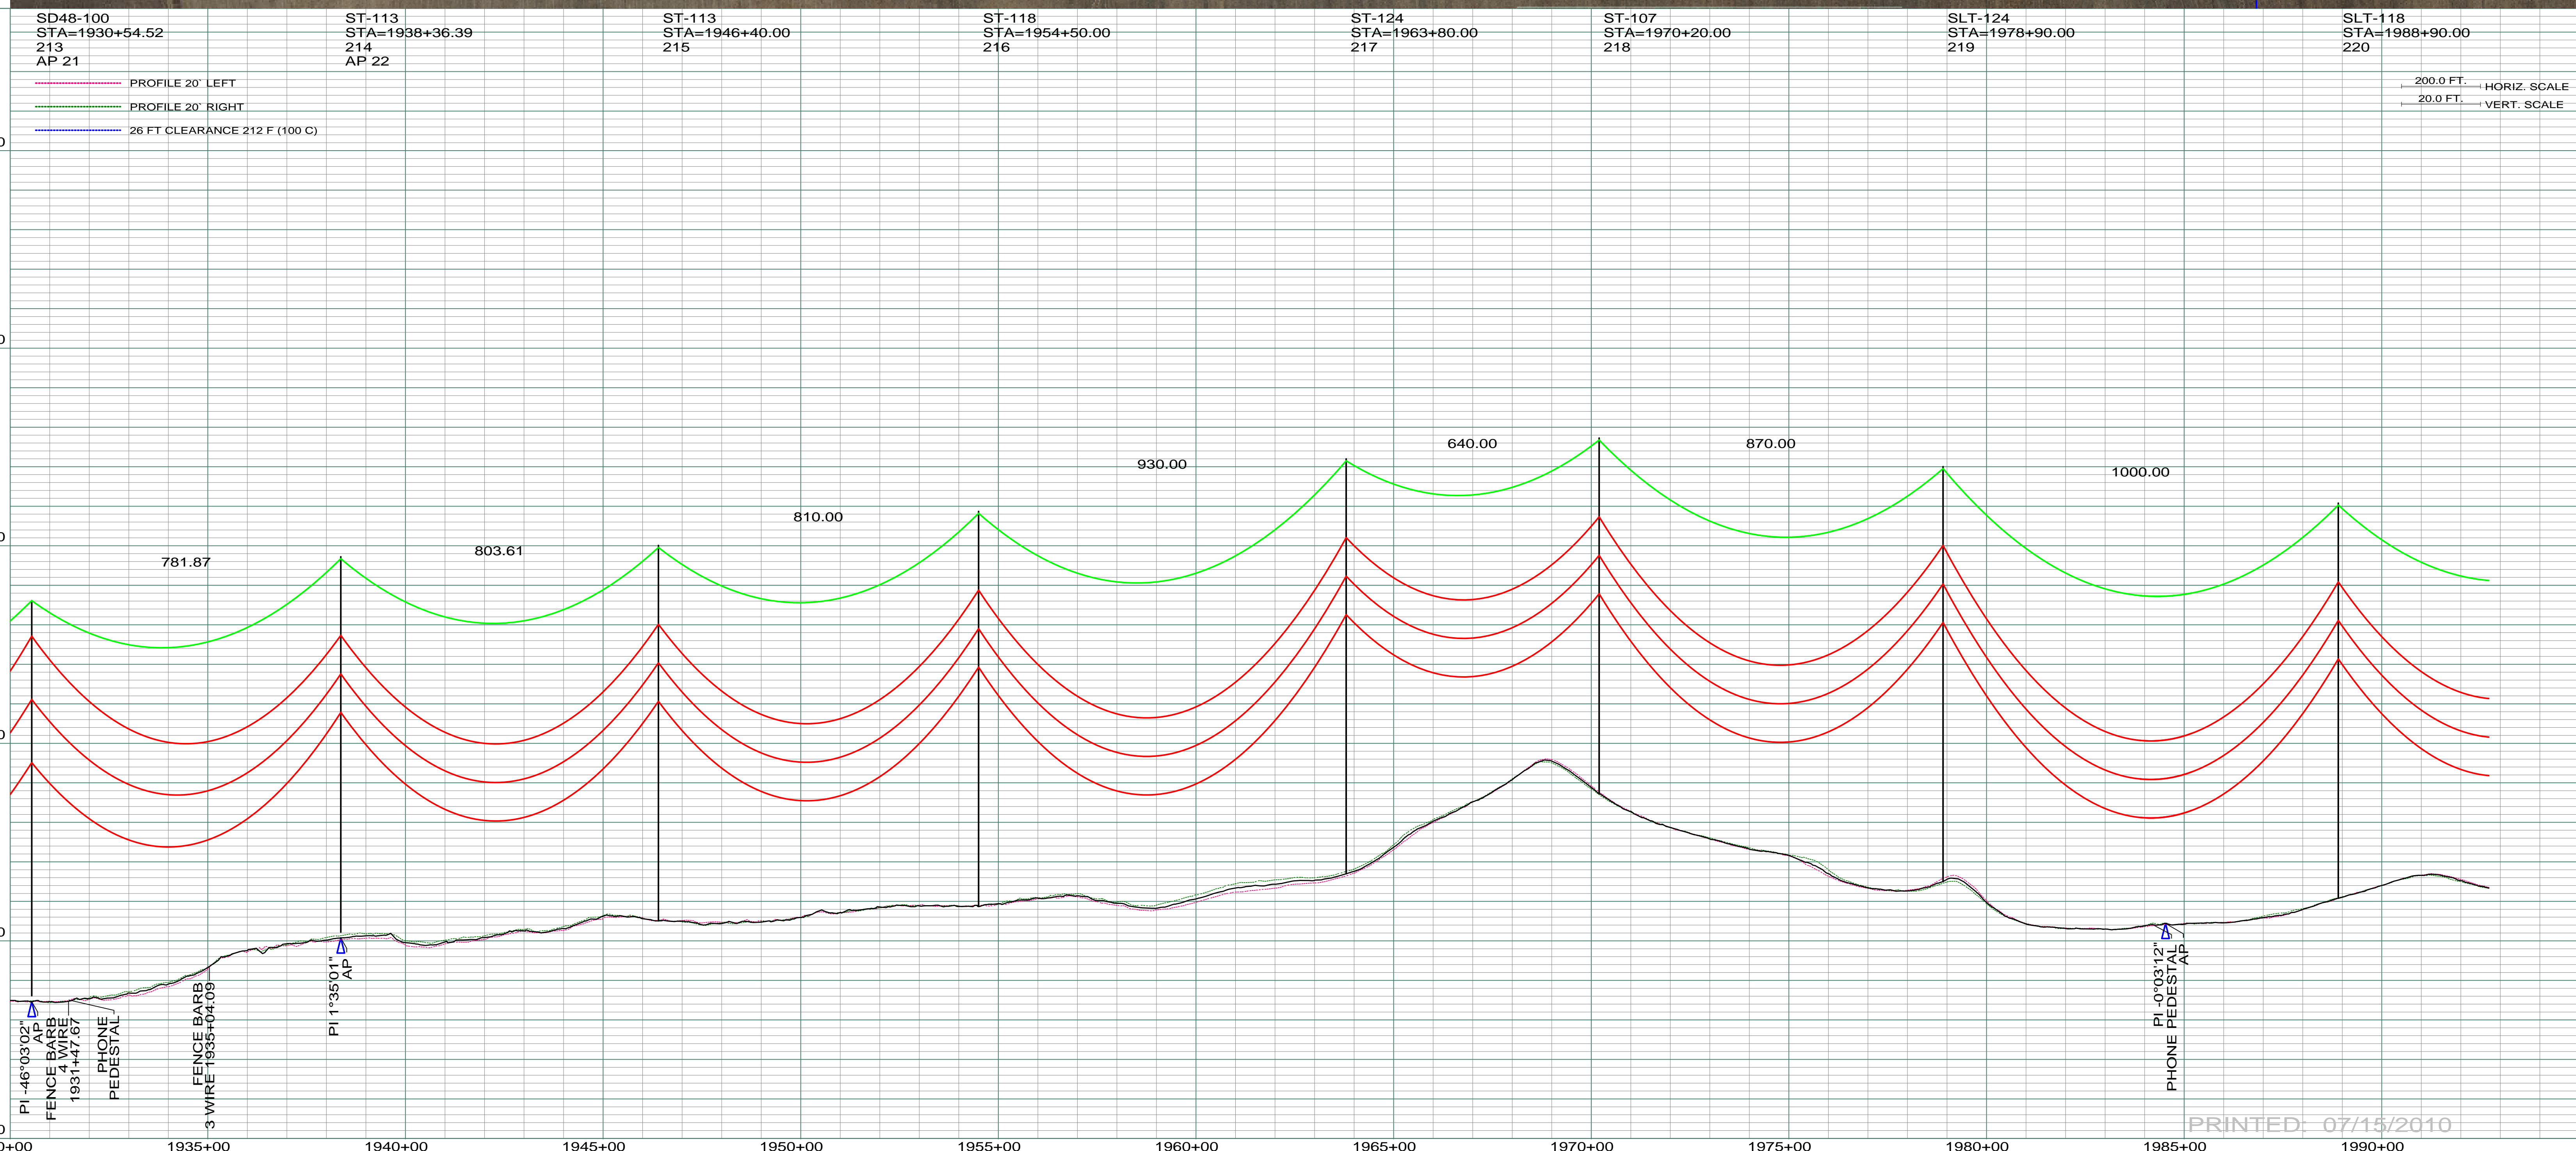

PRINTED: 07/15/2010

REV	DESCRIPTION	DRWN	DSGN	APPD	DATE	REV	DESCRIPTION	DRWN	DSGN	APPD	DATE
1	ISSUE TO PUBLIC SERVICE COMMISSION	CDB	CDB	DAM	09-05-08						
2	RELEASED FOR BID	CDB	CDB	DAM	01-15-09						
3	ISSUED FOR CONSTRUCTION	CDB	CDB	DAM	03-30-09						
4	AS-BUILT	CDB	CDB	DAM	07-16-10						

DESIGN INFORMATION		DESIGN BY:		DATE	
CONDUCTOR	1272 MCM 45/7 ACSR	DAM/CDB	08-08-08	FACILITY: TRANSMISSION SYSTEM MAINTENANCE	
OPGW	AC-71/571	CDB	08-08-08	LOCATION UNIT: 181-230KV LINE-RHAME SUBSTATION TO BELFIELD SUBSTATION	
		DESIGN CHK: SW/ULTEIG	08-08-08	RHAME TO BELFIELD 230KV TRANSMISSION LINE	
		DRAFT CHK:		SCALE: AS SHOWN	
		APPROVED: DAM	09-05-08	COUNTY NAME: SLOPE	
				BASIN DRAWING NO. 181-090-T3-035	
				REV. 4	