

0710
MARGO G. SMITH TRUST
SW 1/4 SEC. 4 T134N R99W
CENTERLINE LENGTH 2640.50'
160.03 RODS-7.58 ACRES

SW 1/4
SEC. 4 T134N R99W
SLOPE CO., NORTH DAKOTA

0720
LAWRENCE URLACHER & CLEMENTINE URLACHER FAMILY SURFACE TRUST
SE 1/4 SEC. 4 T134N R99W
CENTERLINE LENGTH 2540.48'
153.97 RODS-7.29 ACRES

SE 1/4
SEC. 4 T134N R99W
SLOPE CO., NORTH DAKOTA


0730
KEITH & ANN MARIE ANDERSON
ARDEN & VIRGINIA STAFFORD
SW 1/4 SEC. 3 T134N R99W
CENTERLINE LENGTH 2536.96'
153.76 RODS-7.28 ACRES



ST-118 STA=2463+80.00 281	ST-118 STA=2472+10.00 282	ST-118 STA=2480+70.00 283	ST-113 STA=2489+40.00 284	ST-107 STA=2496+30.00 285	ST-118 STA=2504+10.00 286	ST-091 STA=2510+30.00 287	ST-113 STA=2515+60.00 288	ST-113 STA=2523+90.00 289
---------------------------------	---------------------------------	---------------------------------	---------------------------------	---------------------------------	---------------------------------	---------------------------------	---------------------------------	---------------------------------

----- PROFILE 20' LEFT
----- PROFILE 20' RIGHT
----- 26 FT CLEARANCE 212 F (100 C)

200.0 FT. HORIZ. SCALE
 20.0 FT. VERT. SCALE

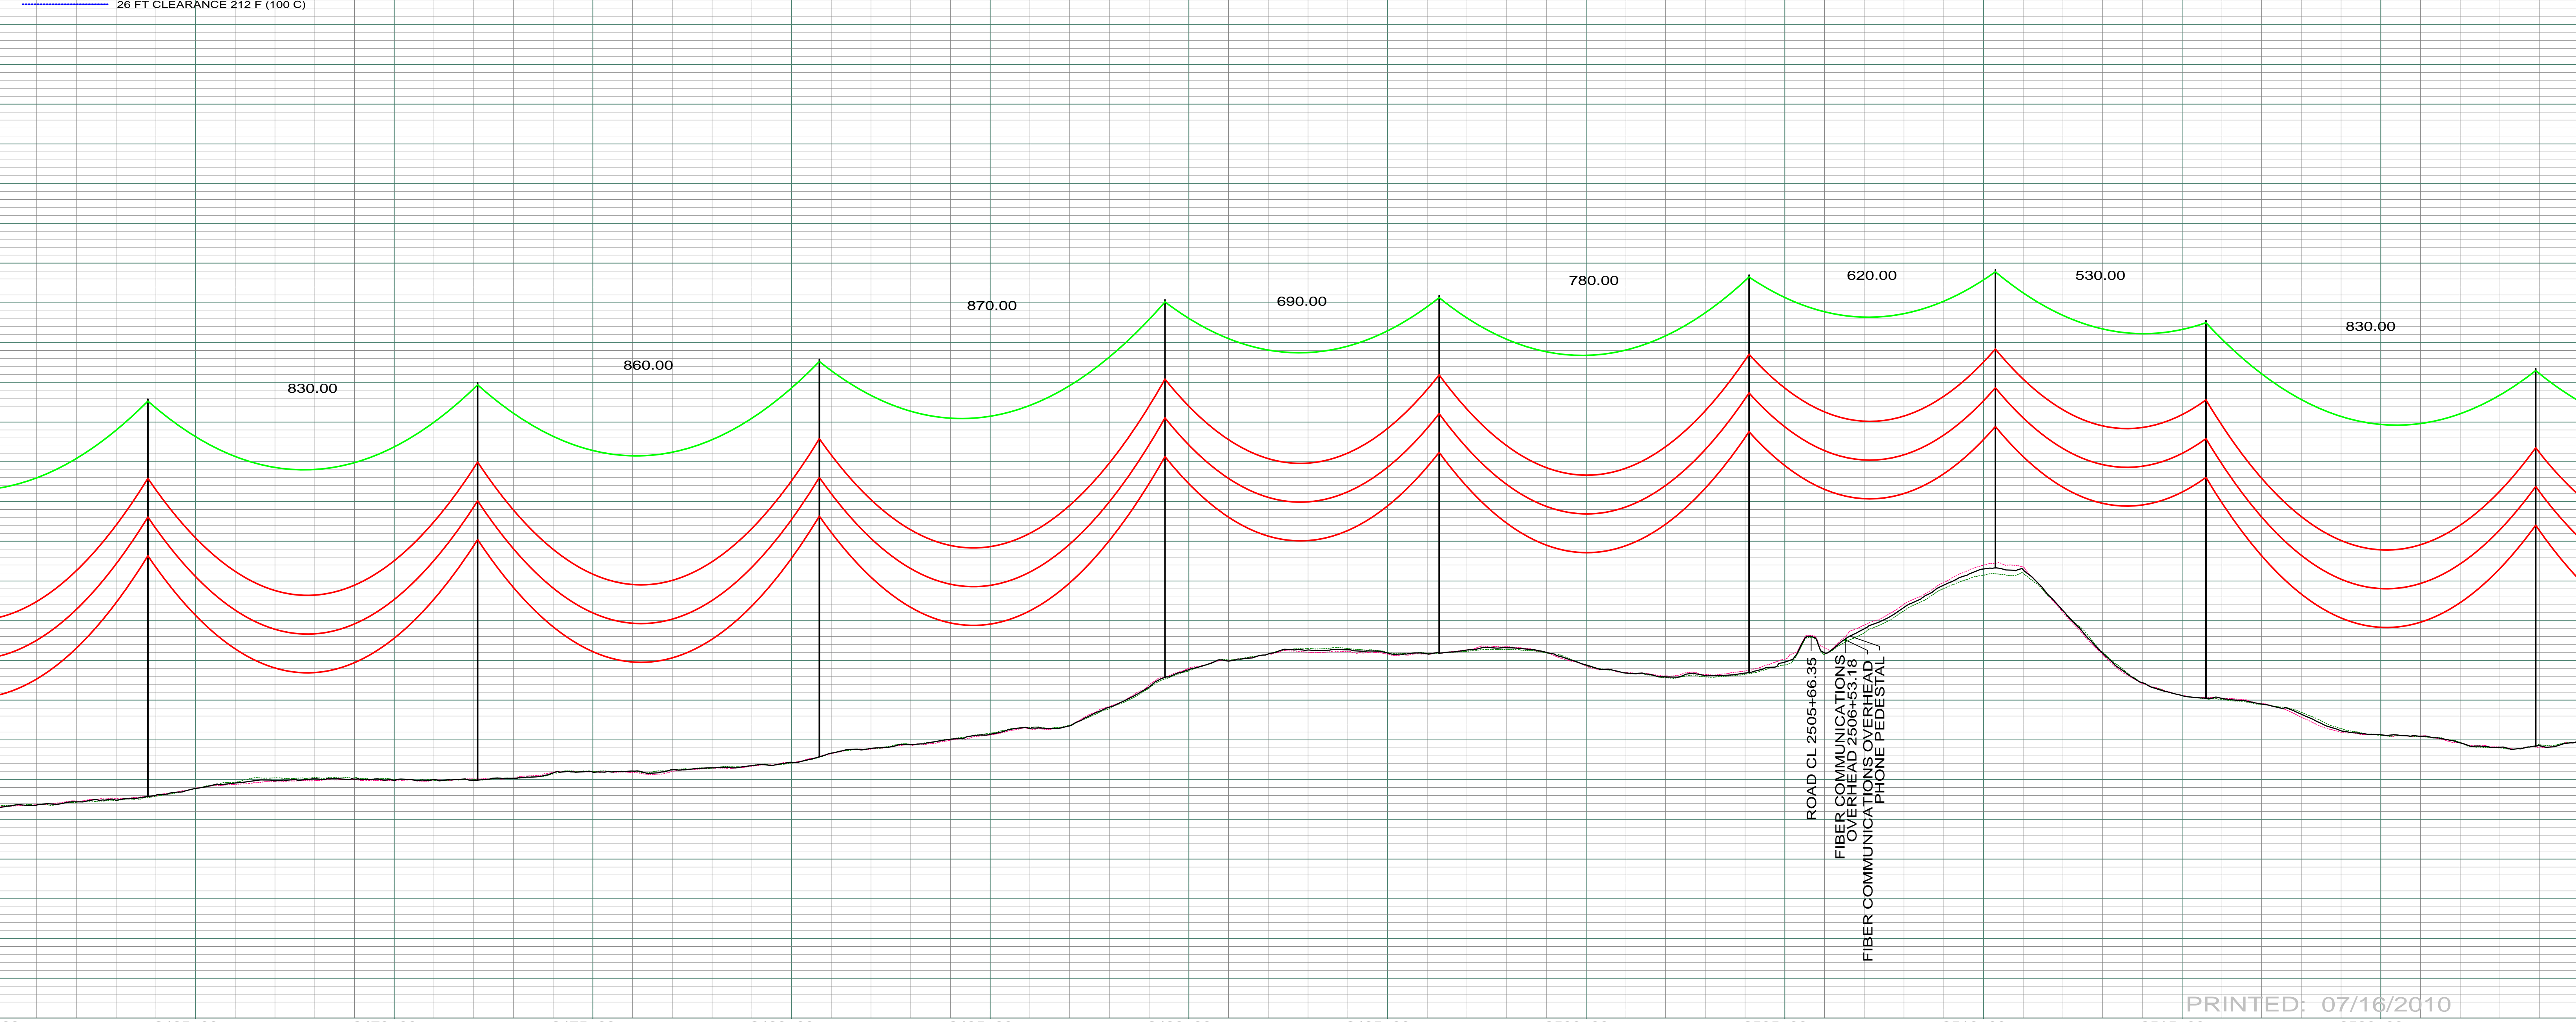

PRINTED: 07/16/2010

REV	DESCRIPTION	DRWN	DSGN	APPD	DATE	REV	DESCRIPTION	DRWN	DSGN	APPD	DATE	STATE NAME: NORTH DAKOTA	NAD83 NDSPCS INTL FT SOUTH ZONE	DESIGN BY: DAM/CDB	08-08-08	FACILITY: TRANSMISSION SYSTEM MAINTENANCE	BASIN ELECTRIC POWER COOPERATIVE 1717 EAST INTERSTATE AVENUE BISMARCK, NORTH DAKOTA PHONE 701-223-0441	SCALE: AS SHOWN	COUNTY NAME: SLOPE
1	ISSUE TO PUBLIC SERVICE COMMISSION	CDB	CDB	DAM	08-08-08							DESIGN BY: DAM/CDB	08-08-08	DRAWN BY: CDB	08-08-08	LOCATION UNIT: 181-230KV LINE-RHAME SUBSTATION TO BELFIELD SUBSTATION			
2	RELEASE FOR BID	CDB	CDB	DAM	01-15-09							DESIGN BY: DAM/CDB	08-08-08	DESIGN CHK: SW/ULTEIG	08-08-08	RHAME TO BELFIELD 230KV TRANSMISSION LINE			
3	ISSUED FOR CONSTRUCTION	CDB	CDB	DAM	03-30-09							DESIGN BY: DAM/CDB	08-08-08	DRAFT CHK:					
4	AS-BUILT	CDB	CDB	DAM	07-16-10							DESIGN BY: DAM/CDB	08-08-08	APPROVED: DAM	09-05-08	PLAN AND PROFILE MILE 40 & 41			

SCALE: AS SHOWN	COUNTY NAME: SLOPE
BASIN DRAWING NO. 181-090-T3-045	REV. 4