

DATE OF AERIAL PHOTOGRAPHY
NOVEMBER 09, 2007
GEODIGITAL INTERNATIONAL

0855
STATE OF NORTH DAKOTA
PART OF 1/2 SEC. 7-T135N-R98W
PART OF S 1/2 SEC. 6-T135N-R98W
CENTERLINE LENGTH 150.03'-9.09 RODS-0.43 ACRES

0860
PETER & MARY FICEK FAMILY TRUST
SE 1/4 SEC. 6-T135N-R98W
CENTERLINE LENGTH 410.82'
24.90 RODS-1.18 ACRES


0870
KATHLEEN ROLLER
W 1/2 SEC. 5-T135N-R98W
CENTERLINE LENGTH 4836.71'
293.07 RODS-13.87 ACRES

SW 1/4
SEC. 5 T135N R98W
SLOPE CO., NORTH DAKOTA

ST-113 STA=2973+30.00 350	ST-107 STA=2981+10.00 351	ST-107 STA=2988+10.00 352	ST-107 STA=2994+70.00 353	SA38-095 STA=2999+76.04 354 AP 34	SA38-100 STA=3005+16.04 355 AP 35	ST-102 STA=3010+90.00 356	ST-107 STA=3017+60.00 357	ST-113 STA=3024+70.00 358	ST-113 STA=3033+30.00 359
---------------------------------	---------------------------------	---------------------------------	---------------------------------	--	--	---------------------------------	---------------------------------	---------------------------------	---------------------------------

- - - - - PROFILE 20' LEFT
 - - - - - PROFILE 20' RIGHT
 - - - - - 26 FT CLEARANCE 212 F (100 C)

200.0 FT. - HORIZ. SCALE
 20.0 FT. - VERT. SCALE

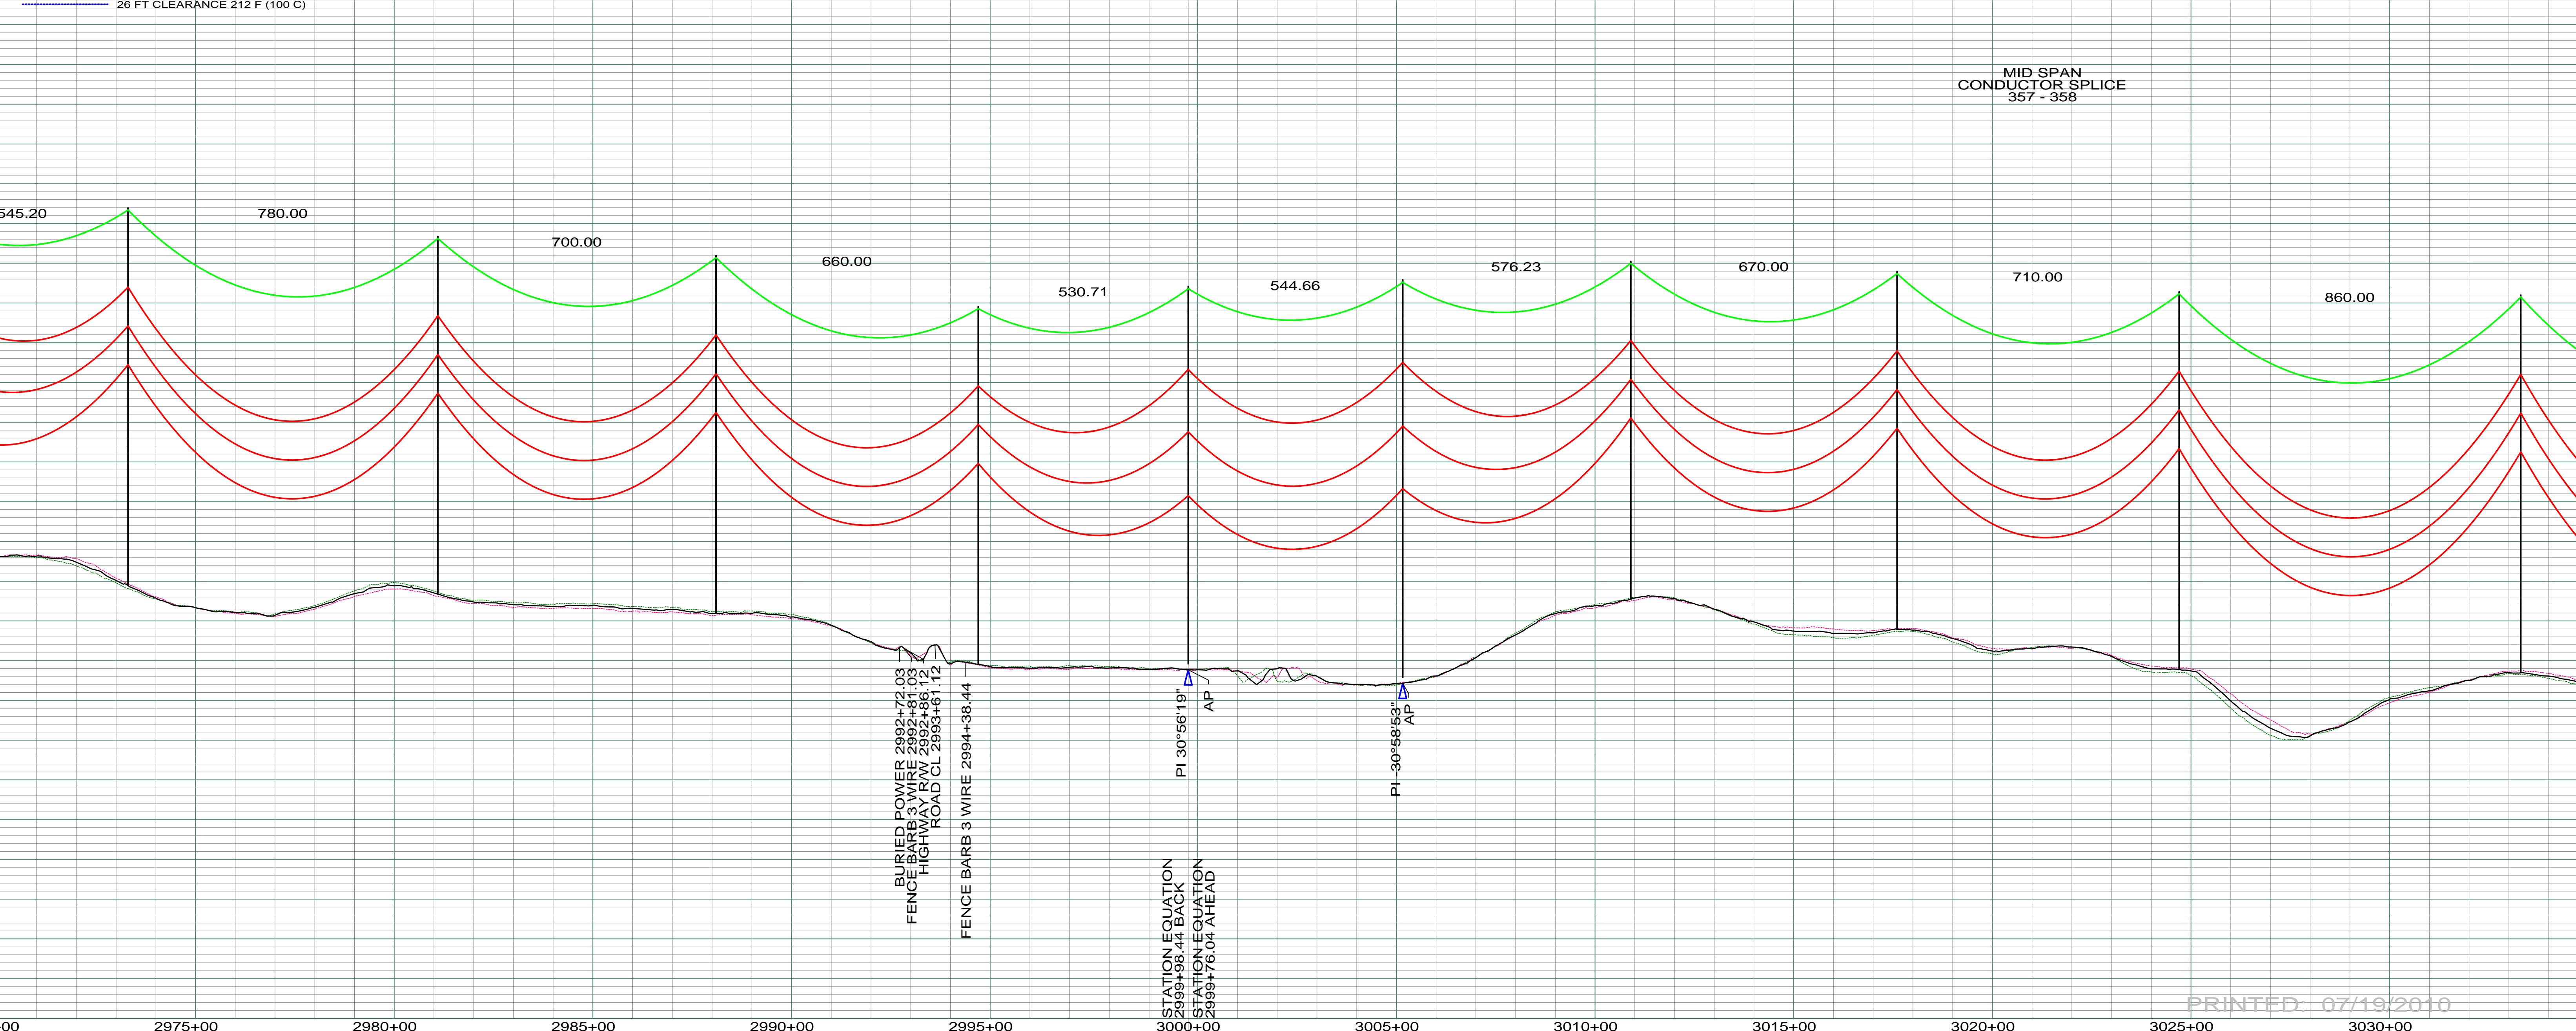

PRINTED: 07/19/2010

REV	DESCRIPTION	DRWN	DSGN	APPD	DATE	REV	DESCRIPTION	DRWN	DSGN	APPD	DATE
1	ISSUE TO PUBLIC SERVICE COMMISSION	CDB	CDB	DAM	08-08-08						
2	RELEASE FOR BID	CDB	CDB	DAM	01-15-09						
3	ISSUED FOR CONSTRUCTION	CDB	CDB	DAM	03-30-09						
4	MOVED STR 353 AHEAD 10 FEET TO STA 2994+70 (FIELD MOVED) AS-BUILT	CDB	CDB	DAM	07-16-10						

STATE NAME: NORTH DAKOTA		NAD83 NDSPCS INTL FT SOUTH ZONE		DESIGN BY: DAM/CDB	08-08-08	FACILITY: TRANSMISSION SYSTEM MAINTENANCE LOCATION UNIT: 181-230KV LINE-RHAME SUBSTATION TO BELFIELD SUBSTATION RHAME TO BELFIELD 230KV TRANSMISSION LINE SCALE: AS SHOWN COUNTY NAME: SLOPE BASIN DRAWING NO. 181-090-T3-054 REV. 4
DESIGN INFORMATION				DRAWN BY: CDB	08-08-08	
CONDUCTOR	1272 MCM 45/7 ACSR	STRINGING TENSION	0	DESIGN RULING SPAN	800	
OPGW	AC-71/571	NESC TENSION	0	ACTUAL RULING SPAN	0	
				DRAFT CHK:		
				APPROVED: DAM	09-05-08	