


DATE OF AERIAL PHOTOGRAPHY
NOVEMBER 08, 2007
GEO DIGITAL INTERNATIONAL

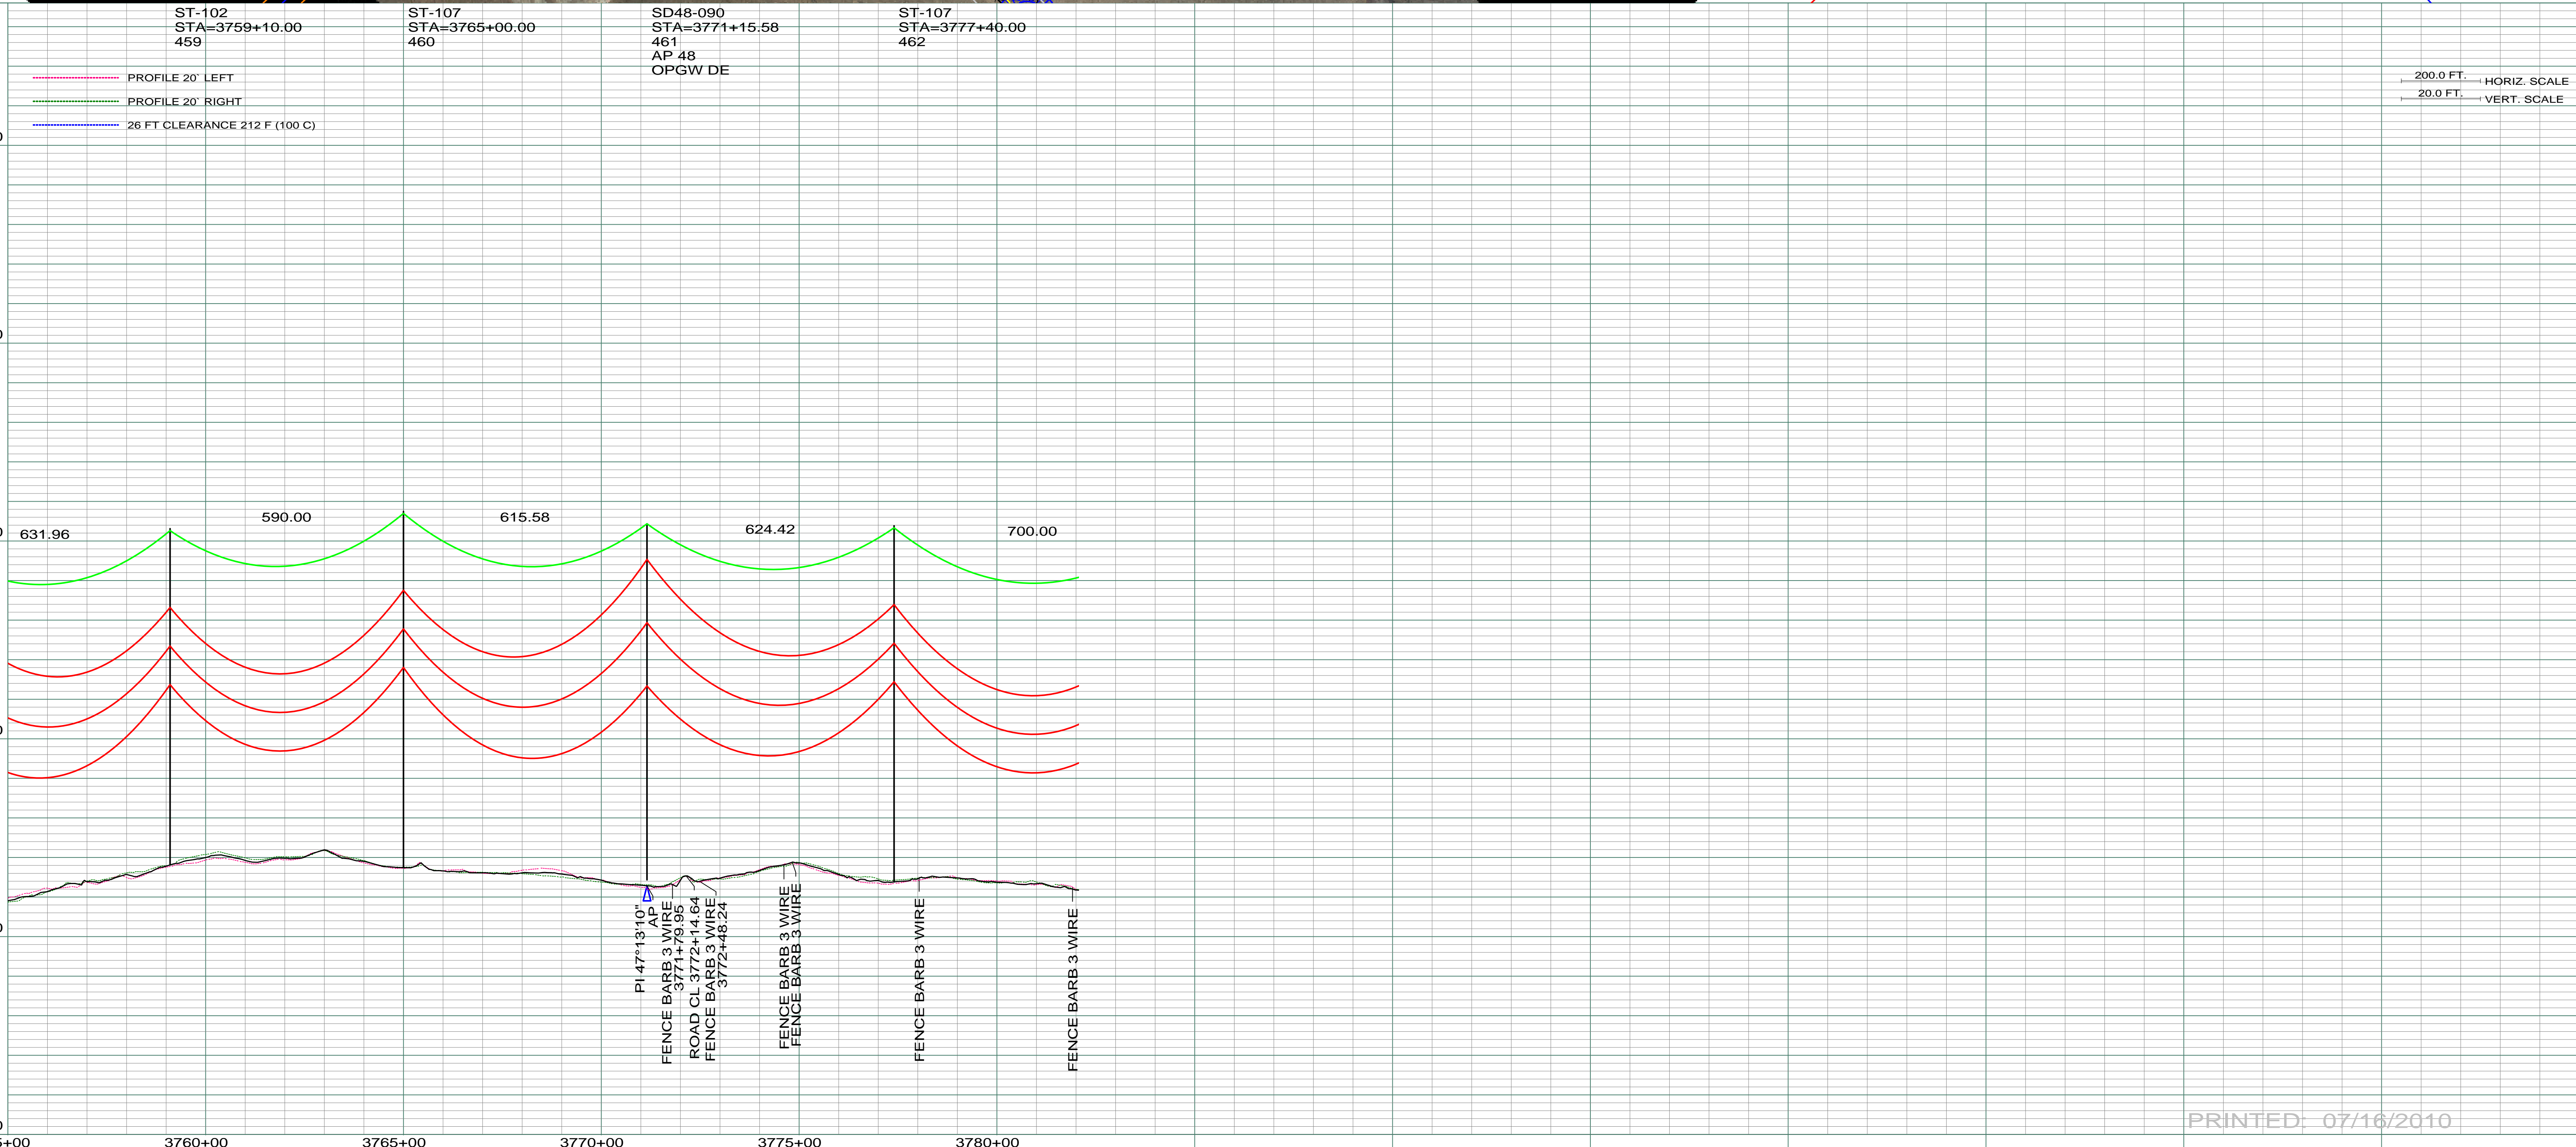

200.0 FT. HORIZ. SCALE
20.0 FT. VERT. SCALE

PRINTED: 07/16/2010

REV	DESCRIPTION	DRWN	DSGN	APPD	DATE	REV	DESCRIPTION	DRWN	DSGN	APPD	DATE
1	ISSUE TO PUBLIC SERVICE COMMISSION	CDB	CDB	DAM	08-08-08						
2	RELEASE FOR BID	CDB	CDB	DAM	01-15-09						
3	ISSUED FOR CONSTRUCTION	CDB	CDB	DAM	03-30-09						
4	AS-BUILT	CDB	CDB	DAM	07-16-10						

DESIGN INFORMATION		DESIGN RULING SPAN	ACTUAL RULING SPAN
CONDUCTOR	1272 MCM 45/7 ACSR	800	0
OPGW	AC-71/571	0	0

DESIGN BY:	DATE
DAM/CDB	08-08-08
DRAWN BY:	DATE
CDB	08-08-08
DESIGN CHK:	DATE
SW/ULTEIG	08-08-08
DRAFT CHK:	
APPROVED:	DATE
DAM	09-05-08

FACILITY:	LOCATION UNIT:
TRANSMISSION SYSTEM MAINTENANCE	181-230KV LINE-RHAME SUBSTATION TO BELFIELD SUBSTATION
RHAME TO BELFIELD 230KV TRANSMISSION LINE	
PLAN AND PROFILE	
MILE 64 & 65	

SCALE:	COUNTY NAME:
AS SHOWN	STARK
BASIN DRAWING NO.	REV.
181-090-T3-069	4

