

DATE OF AERIAL PHOTOGRAPHY  
NOVEMBER 08, 2007  
GEODIGITAL INTERNATIONAL

ST-118  
STA=3952+30.00  
485


ST-118  
STA=3959+70.00  
486

SD58-090  
STA=3967+44.29  
487  
AP 50

ST-107  
STA=3973+80.00  
488

PROFILE 20' LEFT  
PROFILE 20' RIGHT  
26 FT CLEARANCE 212 F (100 C)

200.0 FT. HORIZ. SCALE  
20.0 FT. VERT. SCALE

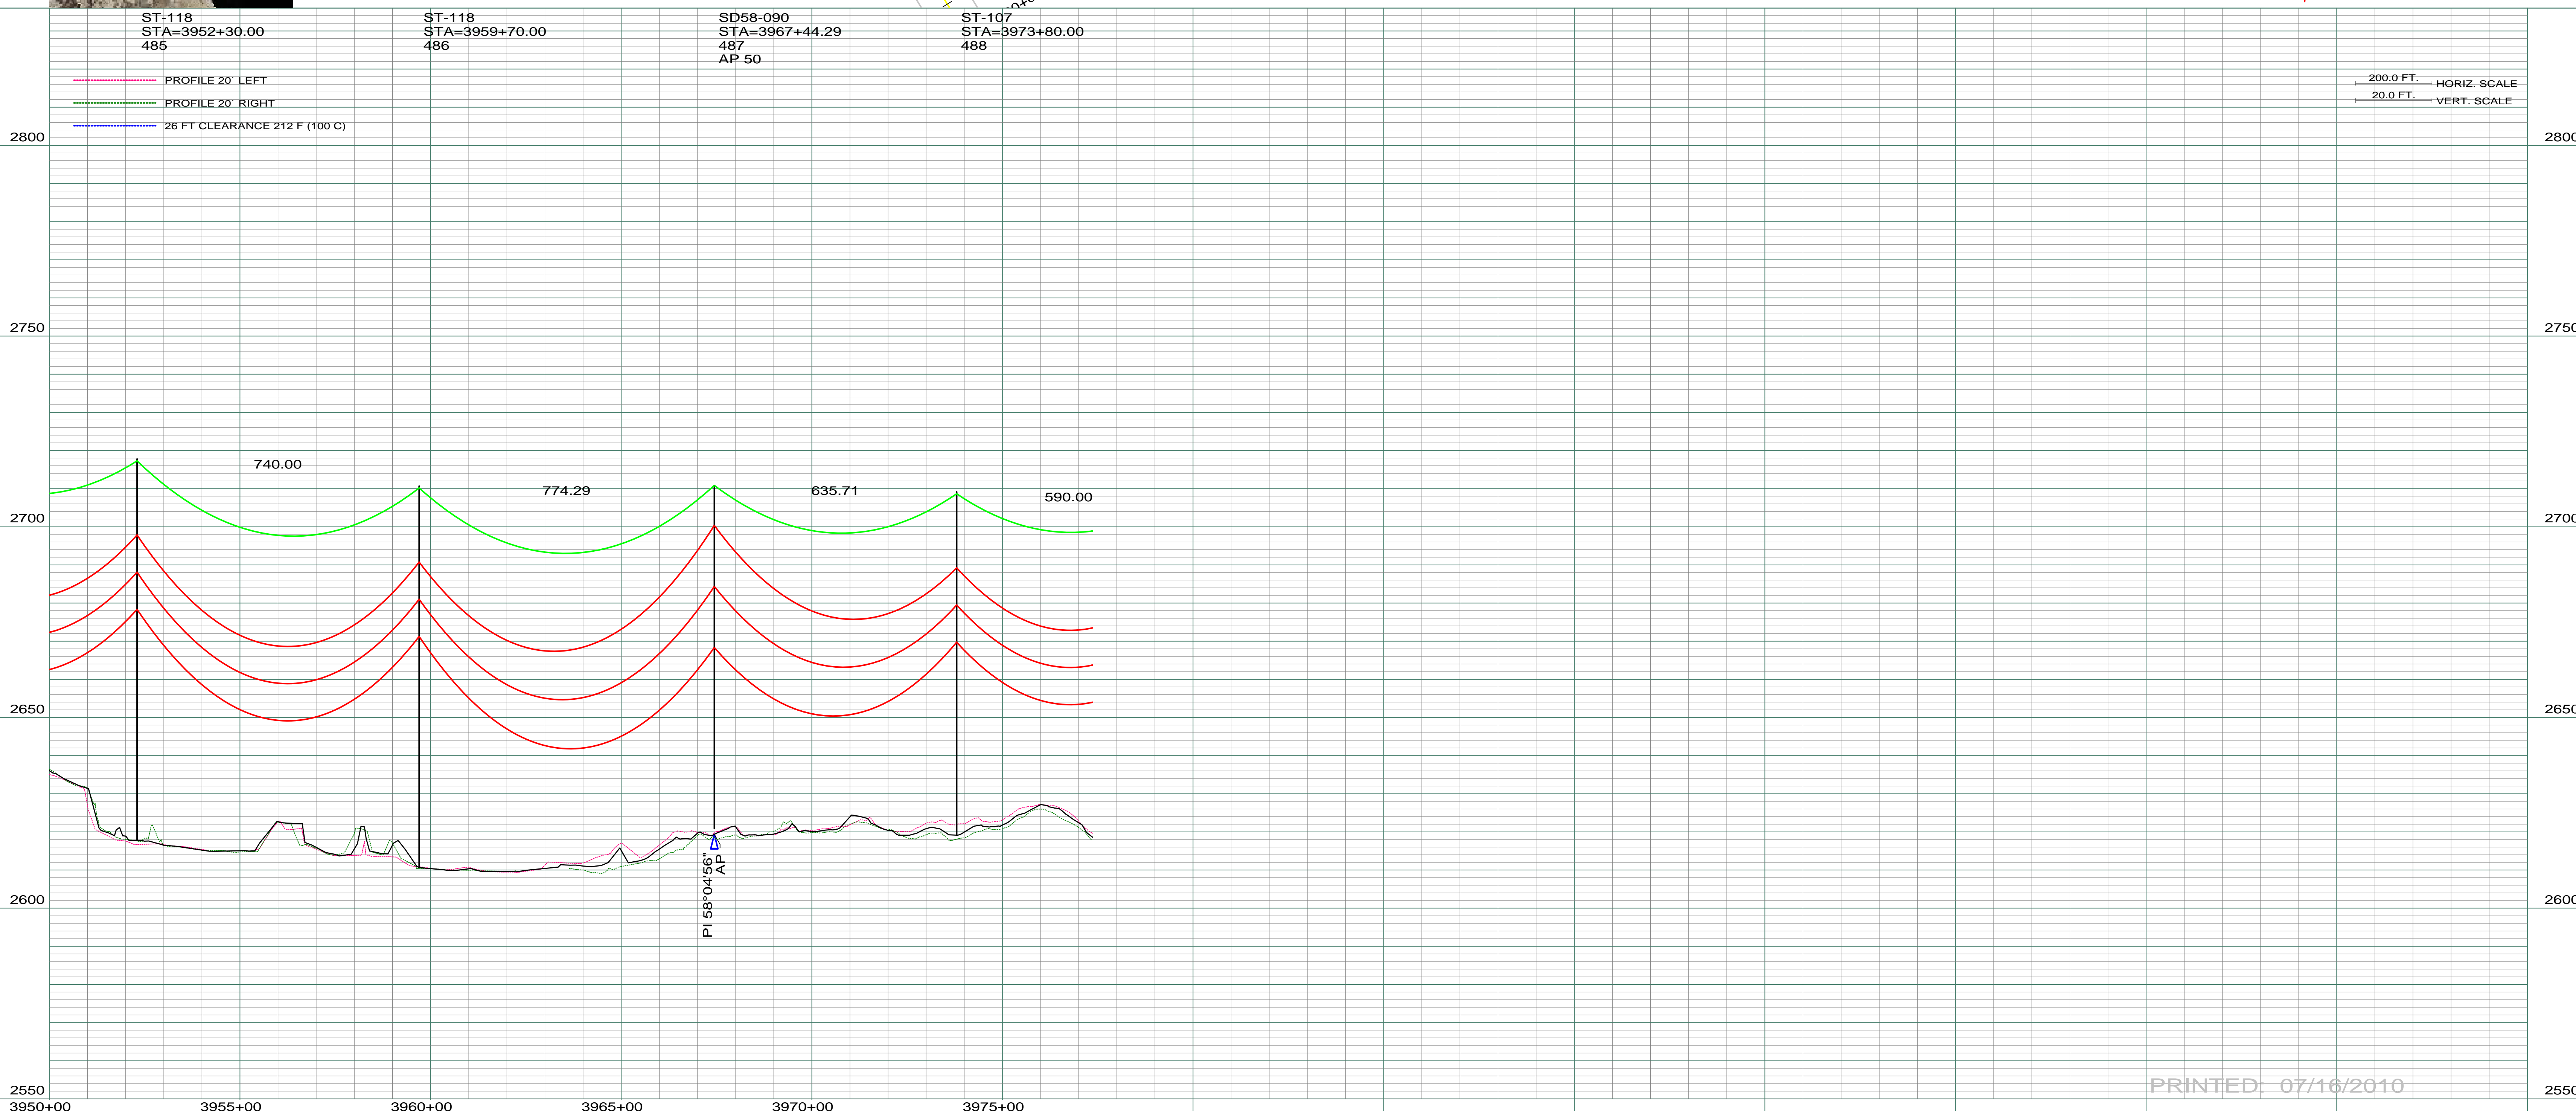

PRINTED: 07/16/2010

REV	DESCRIPTION	DRWN	DSGN	APPD	DATE	REV	DESCRIPTION	DRWN	DSGN	APPD	DATE
1	ISSUE TO PUBLIC SERVICE COMMISSION	CDB	CDB	DAM	08-08-08						
2	RELEASE FOR BID	CDB	CDB	DAM	01-15-09						
3	ISSUED FOR CONSTRUCTION	CDB	CDB	DAM	03-30-09						
4	AS-BUILT	CDB	CDB	DAM	07-16-10						

STATE NAME: NORTH DAKOTA		NAD83 NDSPCS INTL FT SOUTH ZONE		DESIGN BY:	DAM/CDB	08-08-08	FACILITY:	TRANSMISSION SYSTEM MAINTENANCE		
DESIGN INFORMATION				DRAWN BY:	CDB	08-08-08	LOCATION UNIT:	181-230KV LINE-RHAME SUBSTATION TO BELFIELD SUBSTATION		
CONDUCTOR	1272 MCM 45/7 ACSR	STRINGING TENSION		DESIGN CHK:	SW/ULTEIG	08-08-08	RHAME TO BELFIELD 230KV TRANSMISSION LINE			
OPGW	AC-71/571	NESC TENSION	0	DRAFT CHK:			SCALE:	AS SHOWN	COUNTY NAME:	STARK
		DESIGN RULING SPAN	800	APPROVED:	DAM	09-05-08	PLAN AND PROFILE		BASIN DRAWING NO.	181-090-T3-073
		ACTUAL RULING SPAN	0				MILE 68 & 69		REV.	4