


LIDAR & AERIAL PHOTOGRAPHY
JULY 20, 2008
FUGRO HORIZONS, INC.

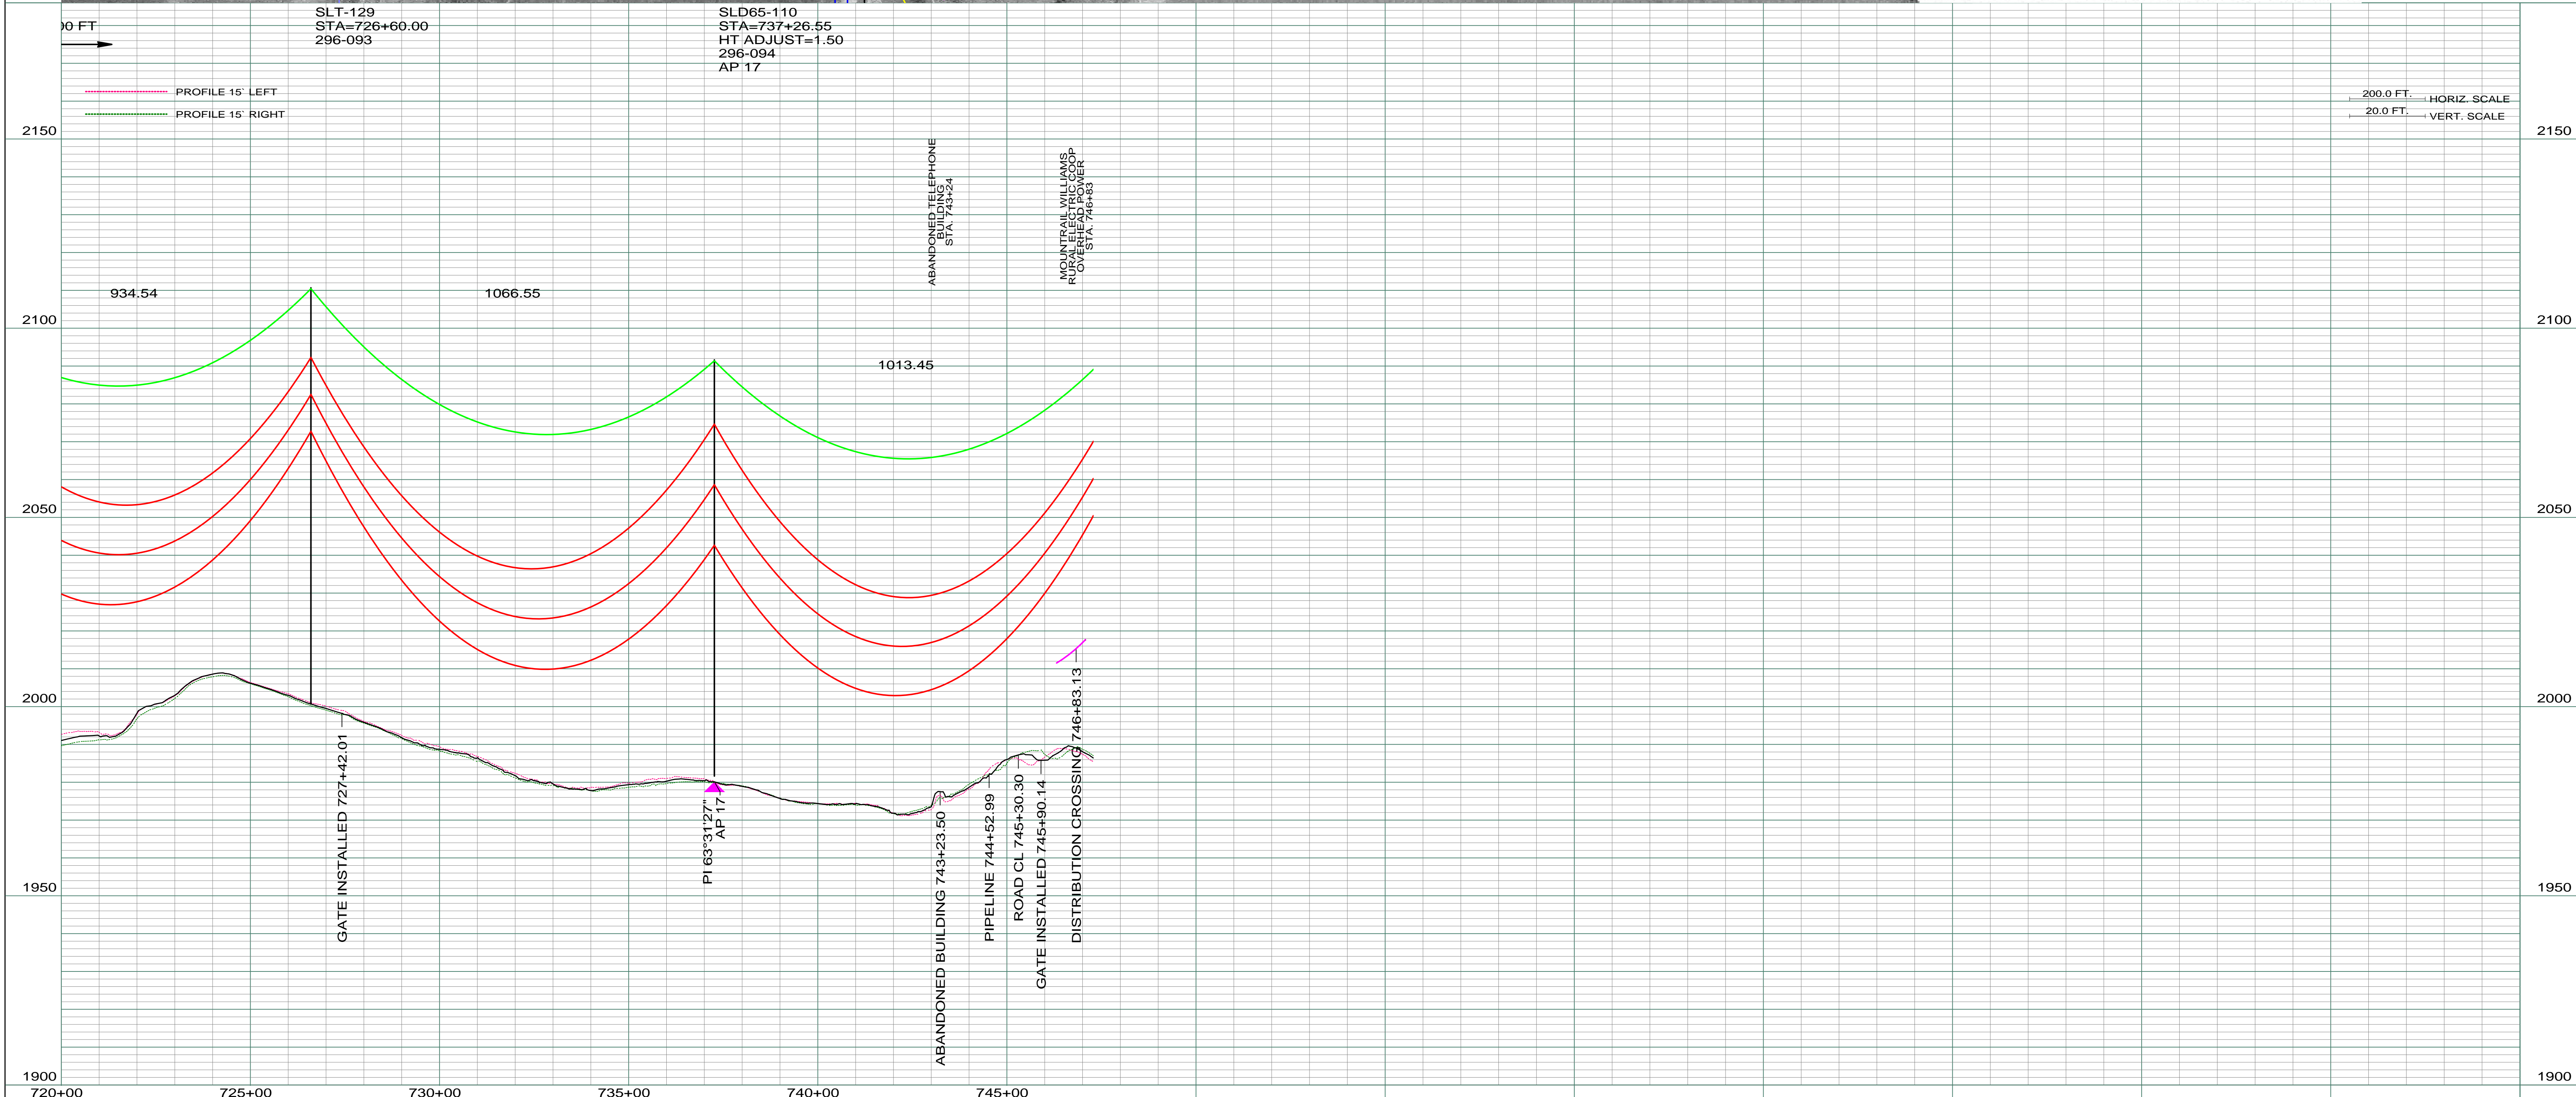

REV	DESCRIPTION	DRWN	DSGN	APPD	DATE	REV	DESCRIPTION	DRWN	DSGN	APPD	DATE
1	MOVED STR 91 AH 10 FEET, STR 93 AH 10 FEET, ISSUE FOR BID	CDB	CDB	DAM	10/22/09						
2	ISSUED FOR CONSTRUCTION	CDB	CDB	DAM	02/03/10						
3	MODIFIED CROSSING TEXT AND MILE INFORMATION	CDB	CDB	DAM	03/11/10						
4	AS-BUILT	CDB	CDB	DAM	03/07/11						

DESIGN INFORMATION		DESIGN BY:	DATE
CONDUCTOR	1272 MCM 45/7 ACSR	DAM/CDB	10/12/09
OPGW	AC-71/571	CDB	10/12/09
		DESIGN CHK:	01/08/10
		DRAFT CHK:	
		APPROVED:	10/12/09

STATE NAME: NORTH DAKOTA	NAD83 NDSPCS INTL FT NORTH ZONE	FACILITY:	TRANSMISSION SYSTEM MAINTENANCE
DESIGN INFORMATION		LOCATION UNIT:	296-230KV LINE-WILLISTON SUBSTATION TO TIOGA SUBSTATION
CONDUCTOR	1272 MCM 45/7 ACSR	SCALE:	AS SHOWN
OPGW	AC-71/571	COUNTY NAME:	WILLIAMS
		BASIN DRAWING NO.:	296-090-T3-015
		REV.:	4

WILLISTON TO TIOGA 230KV TRANSMISSION LINE
PLAN AND PROFILE
MILE 12 & 12

BASIN ELECTRIC POWER COOPERATIVE
1717 EAST INTERSTATE AVENUE
BISMARCK, NORTH DAKOTA
PHONE 701-223-0441