


1050  
JOSEPH & LINDA JACKMAN  
N1/2NW1/4 SEC. 14 T156N R100W  
LENGTH 2642.44 = 160.15 RODS = 7.58 ACRES

1040  
RICHARD NELSON & DAVID NELSON  
NE1/4 SEC. 14 T156N R100W  
LENGTH 2636.29 = 159.90 RODS = 7.57 ACRES

NW 1/4  
SEC. 13 T156N R100W  
WILLIAMS CO., NORTH DAKOTA

NE 1/4  
SEC. 14 T156N R100W  
WILLIAMS CO., NORTH DAKOTA

LIDAR & AERIAL PHOTOGRAPHY  
JULY 20, 2008  
FUGRO HORIZONS, INC.

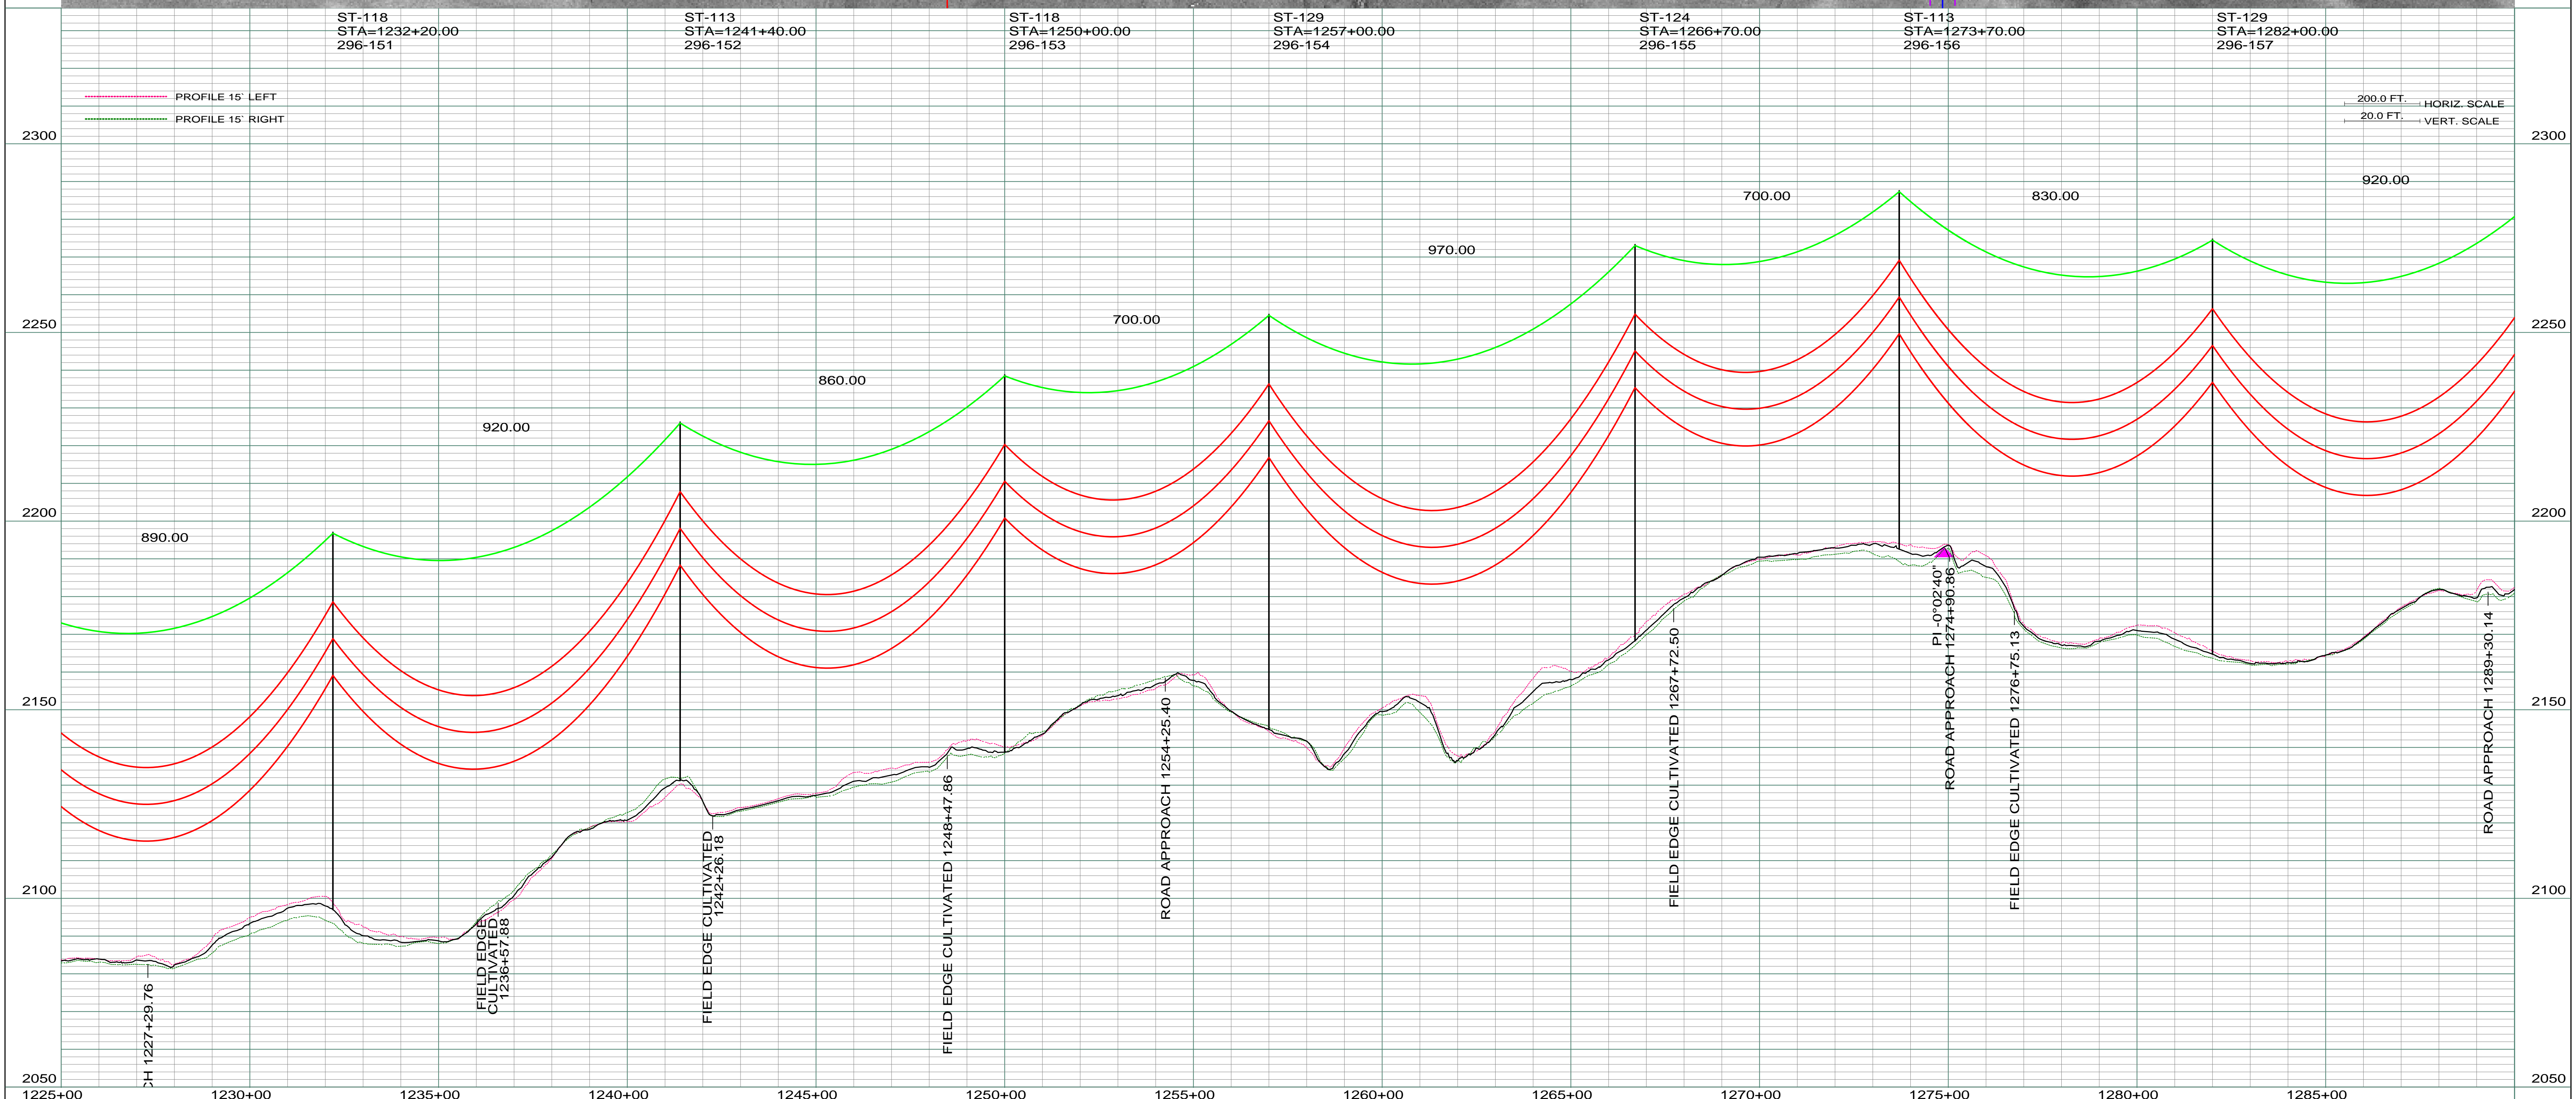

REV	DESCRIPTION	DRWN	DSGN	APPD	DATE	REV	DESCRIPTION	DRWN	DSGN	APPD	DATE
1	ISSUE FOR BID	CDB	CDB	DAM	10/27/09						
2	ISSUED FOR CONSTRUCTION	CDB	CDB	DAM	02/03/10						
3	MODIFIED CROSSING TEXT AND MILE INFORMATION	CDB	CDB	DAM	03/11/10						
4	AS-BUILT	CDB	CDB	DAM	03/07/11						

DESIGN INFORMATION		DESIGNER		DATE	
CONDUCTOR	1272 MCM 45/7 ACSR	STRINGING TENSION	6501	NESC TENSION	12617
OPGW	AC-71/571	STRINGING TENSION	2285	NESC TENSION	5932
		DESIGN R.S.	800	ACTUAL R.S.	820
		DESIGN R.S.	800	ACTUAL R.S.	839

STATE NAME	NAD83 NDSPCS INTL FT NORTH ZONE	DESIGN BY:	DAM/CDB	DATE:	10/12/09
STATE NAME: NORTH DAKOTA	NAD83 NDSPCS INTL FT NORTH ZONE	DESIGN BY:	CDB	DATE:	10/12/09
		DESIGN CHK:	MBN ENGRG.	DATE:	01/08/10
		DRAFT CHK:		DATE:	
		APPROVED:	DAM	DATE:	10/12/09

FACILITY:		LOCATION UNIT:		SCALE:		COUNTY NAME:	
TRANSMISSION SYSTEM MAINTENANCE		296-230KV LINE-WILLISTON SUBSTATION TO TIOGA SUBSTATION		AS SHOWN		WILLIAMS	
WILLISTON TO TIOGA 230KV TRANSMISSION LINE				BASIN DRAWING NO.		REV.	
PLAN AND PROFILE				296-090-T3-025		4	
MILE 23 & 24							