

1030  
H & K FARM, LLP  
NW 1/4 SEC. 13 T156N R100W  
LENGTH 2642.09 - 160.13 RODS - 7.58 ACRES


1020  
FRED & BETTY BERGMAN  
NE 1/4 SEC. 13 T156N R100W  
LENGTH 2643.75 - 160.23 RODS - 7.59 ACRES

1010  
OSMOND SKOGEN  
N 1/2 NE 1/4 - NE 1/4 NW 1/4 - LOT 1 SEC. 18 T156N R99W  
LENGTH 6143.28 - 311.71 RODS - 14.76 ACRES

NE 1/4  
SEC. 13 T156N R100W  
WILLIAMS CO., NORTH DAKOTA

NW 1/4  
SEC. 18 T156N R99W  
WILLIAMS CO., NORTH DAKOTA

LIDAR & AERIAL PHOTOGRAPHY  
JULY 20, 2009  
FUGRO HORIZONS, INC.

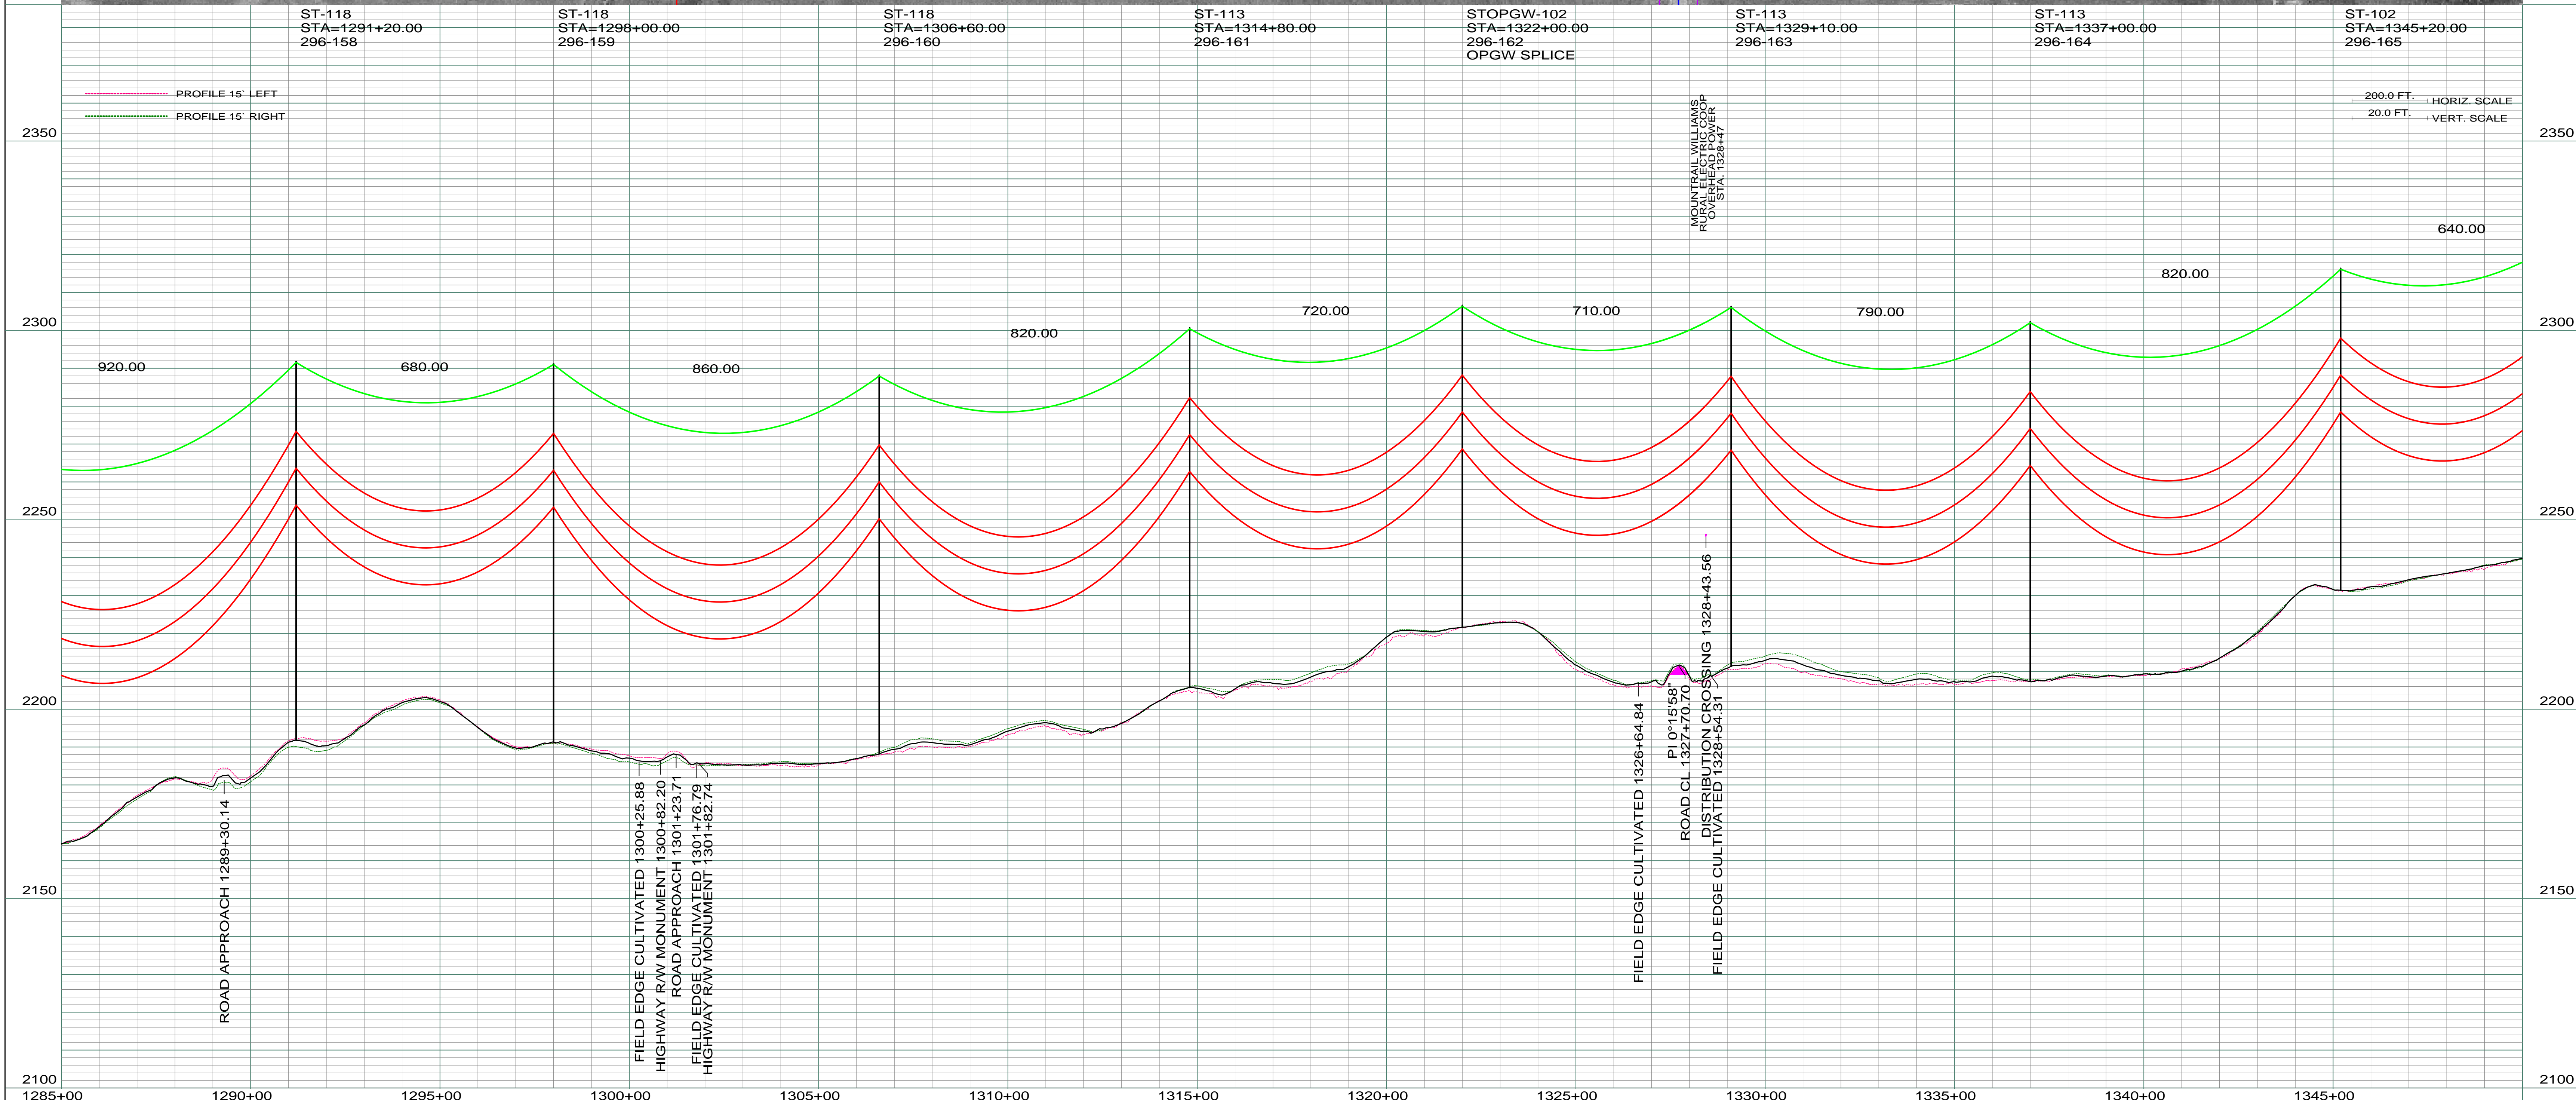

REV	DESCRIPTION	DRWN	DSGN	APPD	DATE
1	ISSUE FOR BID	CDB	CDB	DAM	10/27/09
2	ISSUED FOR CONSTRUCTION	CDB	CDB	DAM	02/03/10
3	MODIFIED CROSSING TEXT AND MILE INFORMATION	CDB	CDB	DAM	03/11/10
4	AS-BUILT	CDB	CDB	DAM	03/07/11

DESIGN INFORMATION					
CONDUCTOR	SIZE	STRINGING TENSION	NESC TENSION	DESIGN R.S.	ACTUAL R.S.
	1272 MCM 45/7 ACSR	6501	12617	800	820
	OPGW	AC-71/571	2277	5810	781

DESIGN BY:		FACILITY:	
DAM/CDB	10/12/09	TRANSMISSION SYSTEM MAINTENANCE	
DRAWN BY:	10/12/09	LOCATION UNIT:	
CDB		296-230KV LINE-WILLISTON SUBSTATION TO TIOGA SUBSTATION	
DESIGN CHK:	01/08/10	WILLISTON TO TIOGA 230KV TRANSMISSION LINE	
MBN ENGRG.		SCALE:	
DRAFT CHK:		AS SHOWN	
APPROVED:	10/12/09	COUNTY NAME:	
DAM		WILLIAMS	
		BASIN DRAWING NO. REV.	
		296-090-T3-026 4	