



1010
OSMOND SROGEN
N7/2NE1/4, NE1/4NW1/4, LOT 1 SEC. 16 T156N R99W
LENGTH 5143.26-311.71 RODS-11.26 ACRES

1000
DALE HENRICH
NW1/4 SEC. 17 T156N R99W
LENGTH 2051.07-101.00 RODS-7.00 ACRES

0990
DAN & MARGARETTE BURDICK
W1/2E1/4 SEC. 17 T156N R99W
LENGTH 1320.06-80.00 RODS-3.79 ACRES

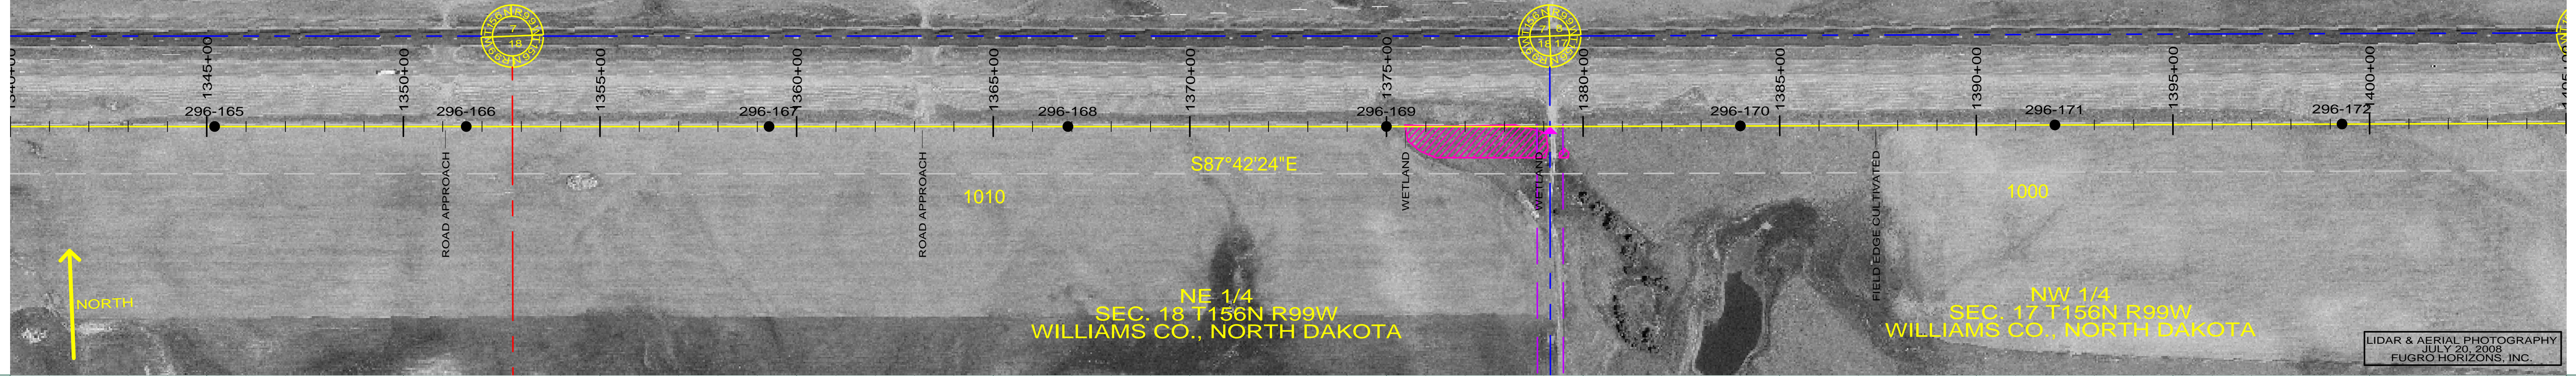

LIDAR & AERIAL PHOTOGRAPHY
JULY 20, 2009
FUGRO HORIZONS, INC.

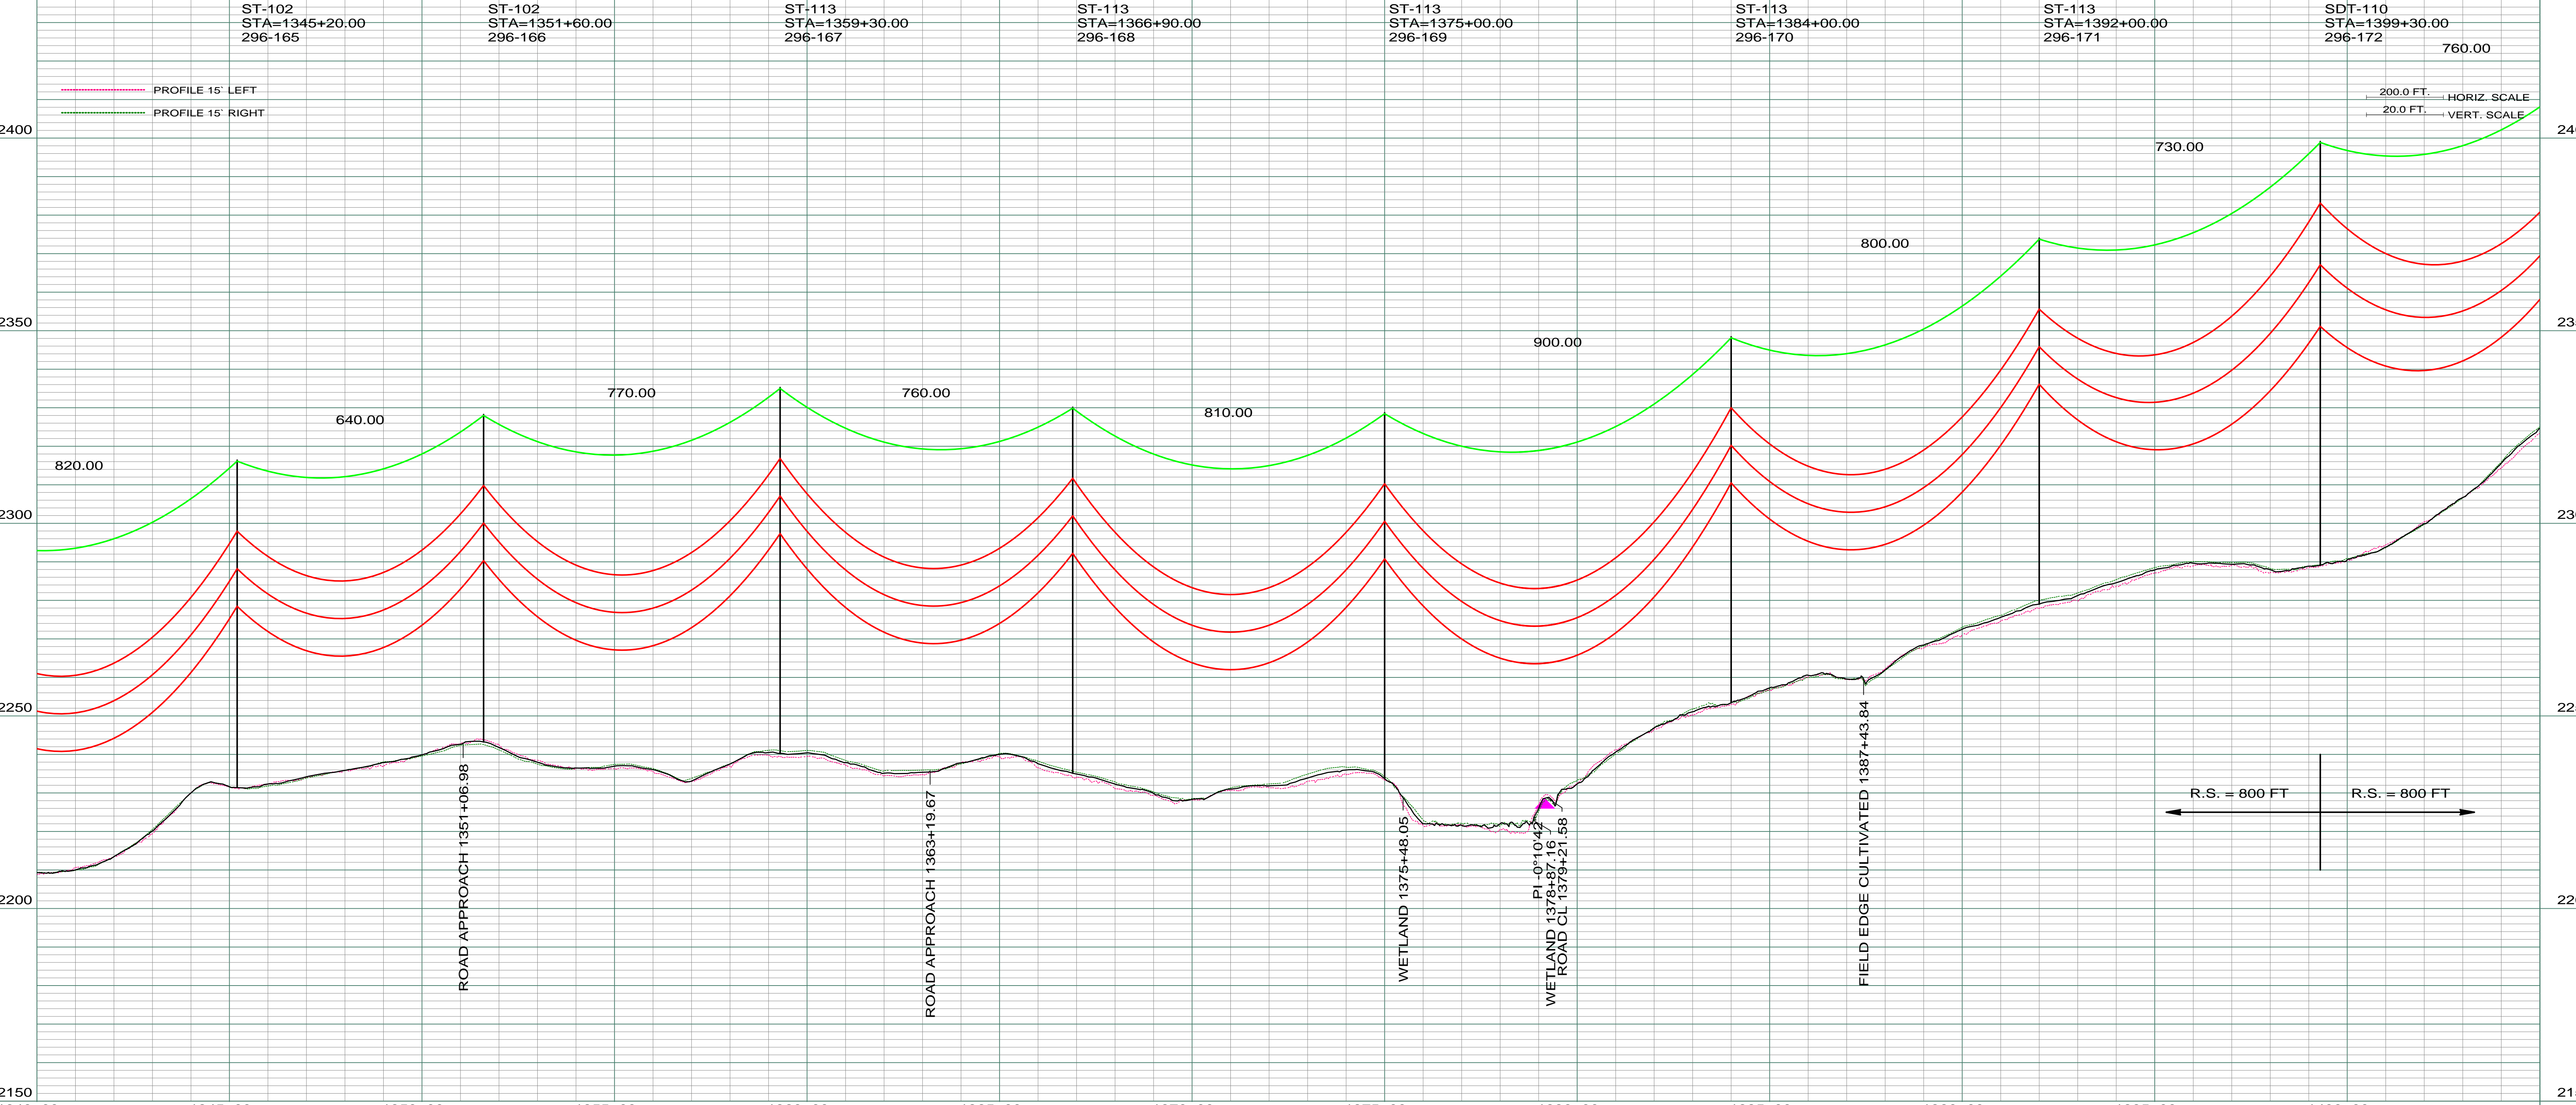

REV	DESCRIPTION	DRWN	DSGN	APPD	DATE	REV	DESCRIPTION	DRWN	DSGN	APPD	DATE
1	ISSUE FOR BID	CDB	CDB	DAM	10/27/09						
2	ISSUED FOR CONSTRUCTION	CDB	CDB	DAM	02/03/10						
3	MODIFIED CROSSING TEXT AND MILE INFORMATION	CDB	CDB	DAM	03/11/10						
4	AS-BUILT	CDB	CDB	DAM	03/07/11						

DESIGN INFORMATION					
CONDUCTOR	SIZE	STRINGING TENSION	NESC TENSION	DESIGN R.S.	ACTUAL R.S.
	1272 MCM 45/7 ACSR	6501	12617	800	820
	OPGW AC-71/571	2277	5810	750	781

STATE NAME: NORTH DAKOTA		NAD83 NDSPCS INTL FT NORTH ZONE		DESIGN BY: DAM/CDB		10/12/09	
DRAWN BY: CDB		10/12/09		DESIGN CHK: MBN ENGRG.		01/08/10	
DRAFT CHK:				APPROVED: DAM		10/12/09	
FACILITY: TRANSMISSION SYSTEM MAINTENANCE				LOCATION UNIT: 296-230KV LINE-WILLISTON SUBSTATION TO TIOGA SUBSTATION			
WILLISTON TO TIOGA 230KV TRANSMISSION LINE				SCALE: AS SHOWN			
MILE 25 & 26				COUNTY NAME: WILLIAMS			
BASIN DRAWING NO. 296-090-T3-027				REV. 4			

BASIN ELECTRIC POWER COOPERATIVE
1717 EAST INTERSTATE AVENUE
BISMARCK, NORTH DAKOTA
PHONE 701-223-0441