

0960
STATE OF NORTH DAKOTA
NE 1/4 SEC. 16 T156N R99W
LENGTH 2837.54-159.85 RODS-7.57 ACRES


0940
CYNTHIA MITTAL
S1/2NW1/4, W1/2W1/2E1/2NW1/4
SEC. 15 T156N R99W
LENGTH 1649.85-99.99 RODS-4.73 ACRES

0940
RONALD & CAROLE HAUG
S1/2NW1/4, E3/4W1/2W1/2E1/2NW1/4
SEC. 15 T156N R99W
LENGTH 989.75-59.98 RODS-2.84 ACRES

NE 1/4
SEC. 16 T156N R99W
WILLIAMS CO., NORTH DAKOTA

NW 1/4
SEC. 15 T156N R99W
WILLIAMS CO., NORTH DAKOTA

LIDAR & AERIAL PHOTOGRAPHY
JULY 20, 2008
FUGRO HORIZONS, INC.

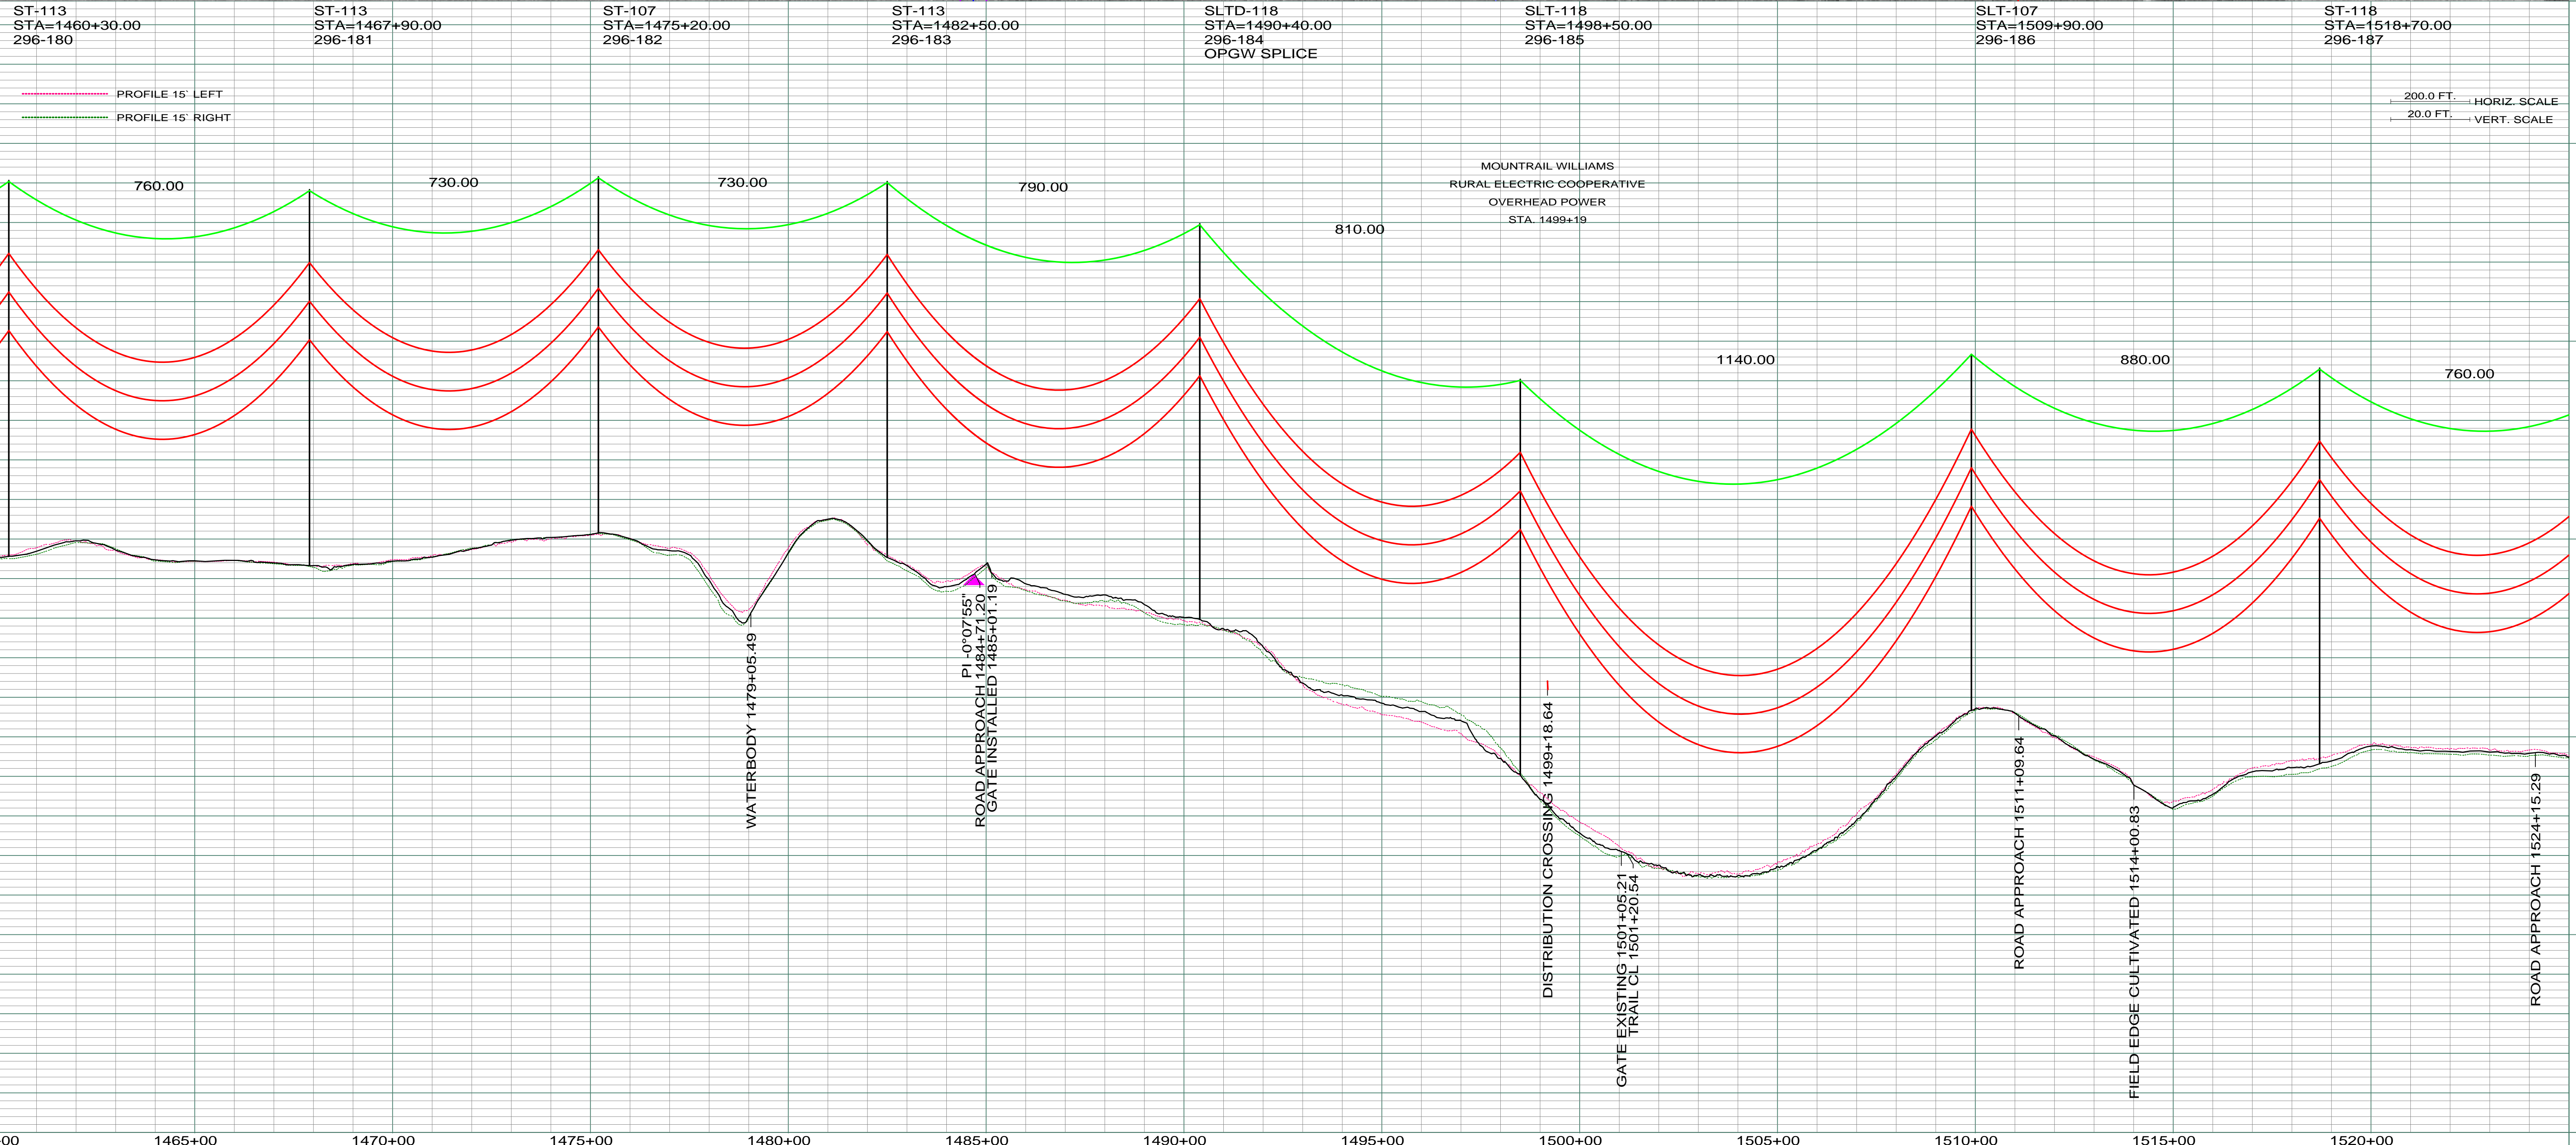

| REV | DESCRIPTION | DRWN | DSGN | APPD | DATE | REV | DESCRIPTION | DRWN | DSGN | APPD | DATE |
|-----|---|------|------|------|----------|-----|-------------|------|------|------|------|
| 1 | ISSUE FOR BID | CDB | CDB | DAM | 10/27/09 | | | | | | |
| 2 | ISSUED FOR CONSTRUCTION | CDB | CDB | DAM | 02/03/10 | | | | | | |
| 3 | MODIFIED CROSSING TEXT AND MILE INFORMATION | CDB | CDB | DAM | 03/11/10 | | | | | | |
| 4 | AS-BUILT | CDB | CDB | DAM | 03/07/11 | | | | | | |

| DESIGN INFORMATION | | | | | |
|------------------------------|-------------------|--------------|-------------|-------------|--|
| SIZE | STRINGING TENSION | NESC TENSION | DESIGN R.S. | ACTUAL R.S. | |
| CONDUCTOR 1272 MCM 45/7 ACSR | 6501 | 12617 | 800 | 799 | |
| OPGW AC-71/571 | 2277 | 5810 | 750 | 765 | |

| DESIGN INFORMATION | | | |
|--------------------|----------|------------|----------|
| DESIGN BY: | DATE | DESIGN BY: | DATE |
| DAM/CDB | 10/12/09 | CDB | 10/12/09 |
| DESIGN CHK: | 01/08/10 | DRAFT CHK: | |
| MBN ENGRG. | | APPROVED: | 10/12/09 |
| DAM | | | |

| WILLISTON TO TIOGA 230KV TRANSMISSION LINE | |
|--|-----------------------|
| PLAN AND PROFILE | |
| MILE 27 & 28 | |
| SCALE: AS SHOWN | COUNTY NAME: WILLIAMS |
| BASIN DRAWING NO. 296-090-T3-029 | REV. 4 |

FACILITY: TRANSMISSION SYSTEM MAINTENANCE

LOCATION UNIT: 296-230KV LINE-WILLISTON SUBSTATION TO TIOGA SUBSTATION

WILLISTON TO TIOGA 230KV TRANSMISSION LINE

PLAN AND PROFILE

MILE 27 & 28

SCALE: AS SHOWN

COUNTY NAME: WILLIAMS

BASIN DRAWING NO. 296-090-T3-029

REV. 4