

0900  
RONALD & CAROLE HAUG  
NW 1/4 NW 1/4 SEC. 13 T156N R99W  
LENGTH 1317.80-79.87 RODS 3.78 ACRES


0880  
WANDA OLSON  
NE 1/4 NE 1/4 SEC. 13 T156N R99W  
LENGTH 1317.78-79.87 RODS 3.78 ACRES

NW 1/4  
SEC. 13 T156N R99W  
WILLIAMS CO., NORTH DAKOTA

0890  
PATRICIA ANDERSON ET AL  
NW 1/4 NE 1/4 NE 1/4 NW 1/4  
SEC. 13 T156N R99W  
LENGTH 2635.58-159.73 RODS 7.56 ACRES

NE 1/4  
SEC. 13 T156N R99W  
WILLIAMS CO., NORTH DAKOTA

LIDAR & AERIAL PHOTOGRAPHY  
JULY 20, 2018  
FUGRO HORIZONS, INC.

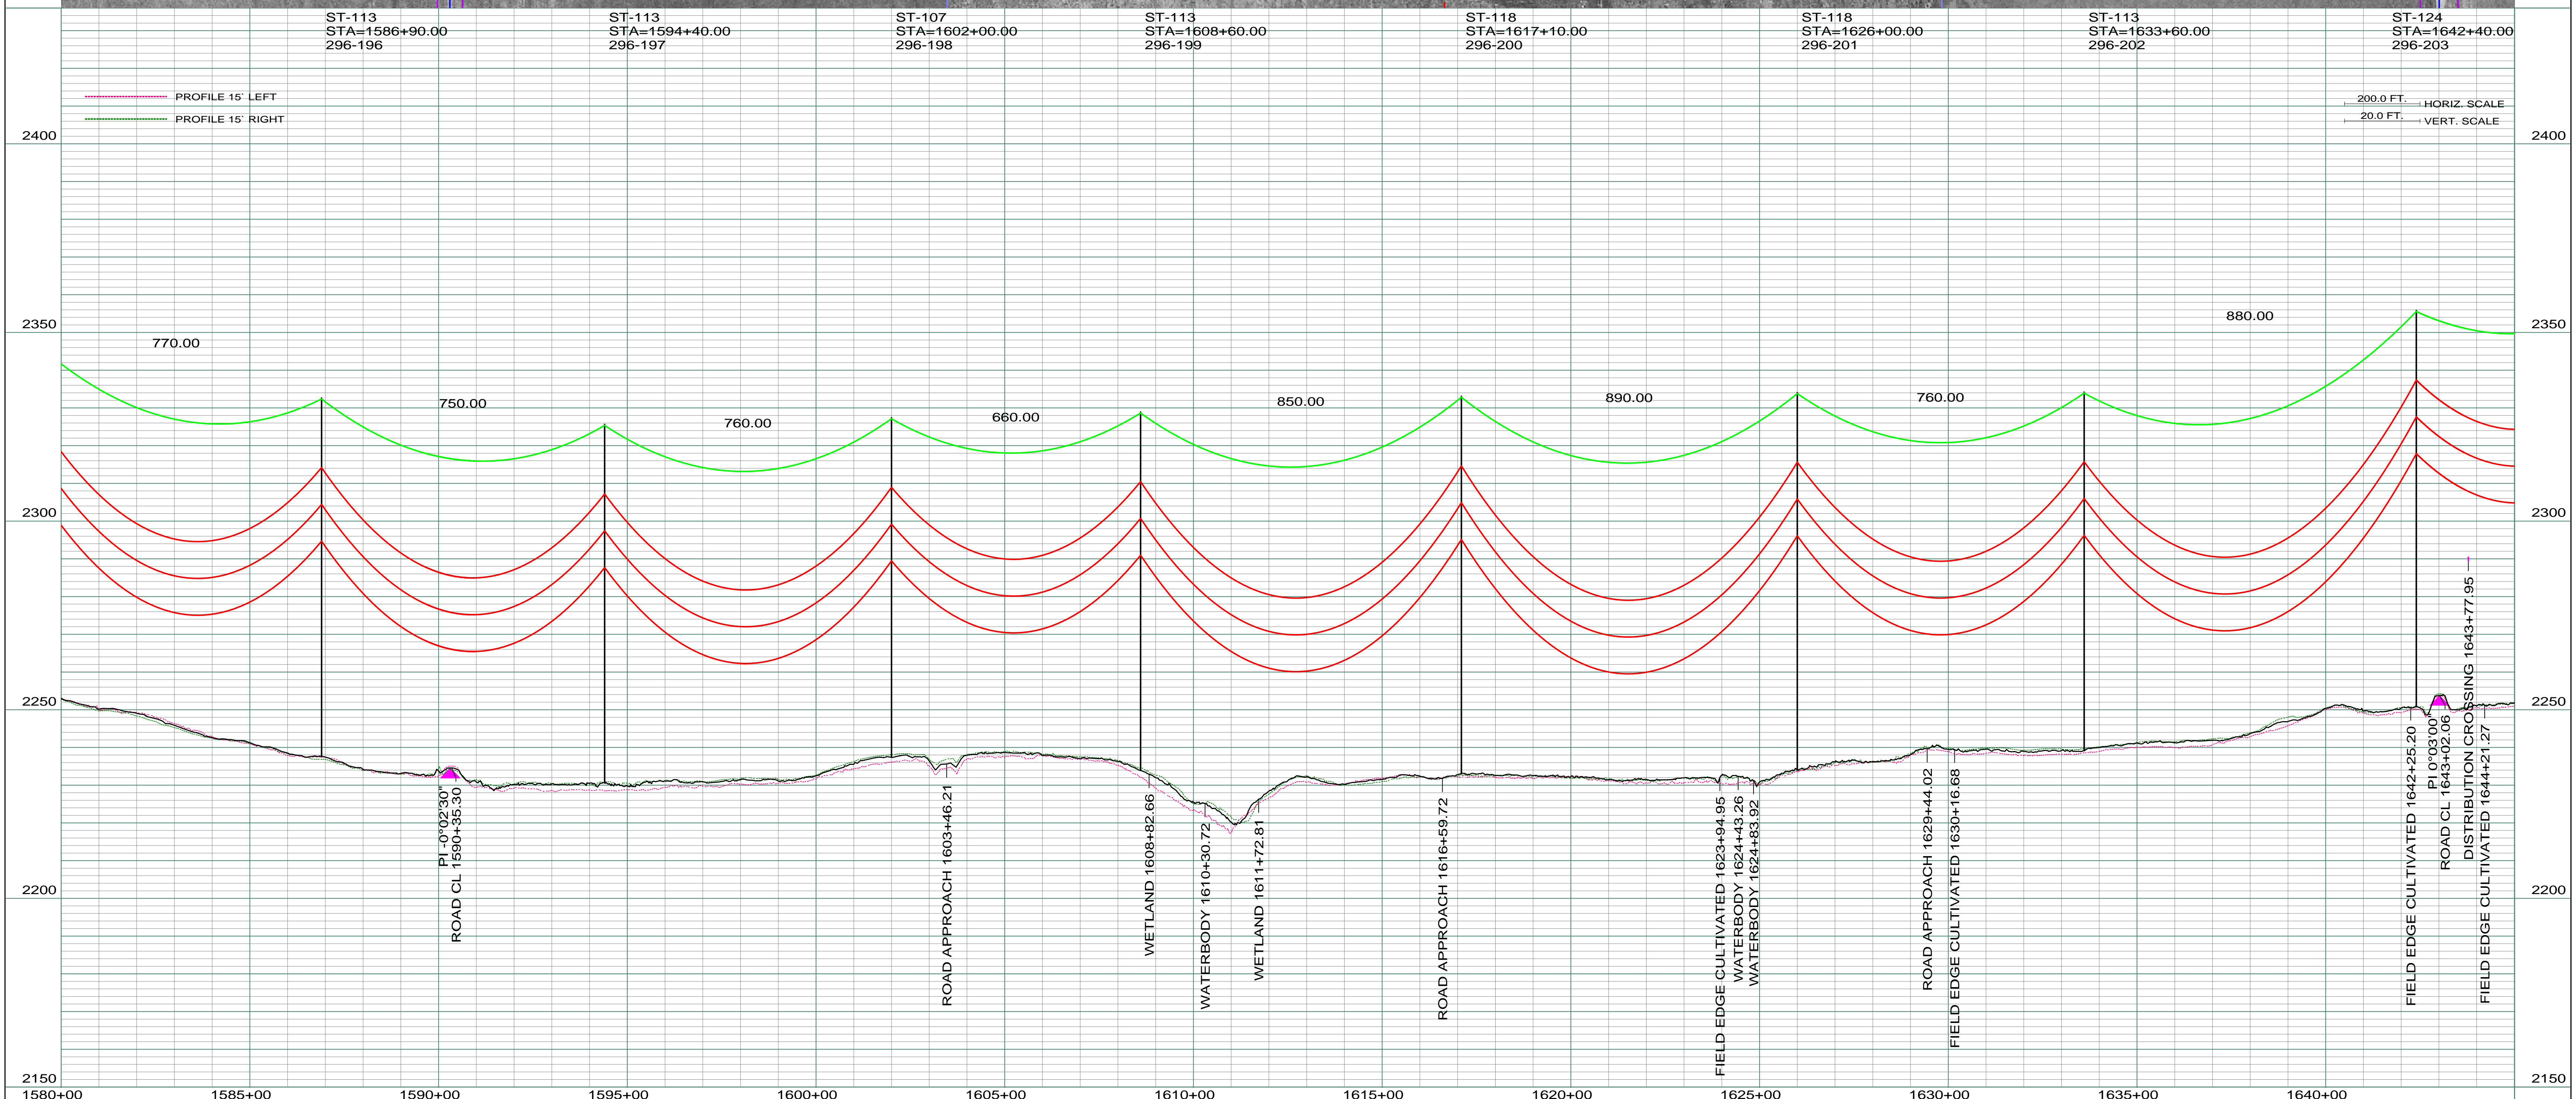

REV	DESCRIPTION	DRWN	DSGN	APPD	DATE	REV	DESCRIPTION	DRWN	DSGN	APPD	DATE
1	ISSUE FOR BID	CDB	CDB	DAM	10/27/09						
2	ISSUED FOR CONSTRUCTION	CDB	CDB	DAM	02/03/10						
3	MODIFIED CROSSING TEXT AND MILE INFORMATION 203 TO ST-124, 201 AHD 50FT, 202 AHD 70FT, 203 AHD 150FT	CDB	CDB	DAM	03/11/10						
4	AS-BUILT	CDB	CDB	DAM	03/07/11						

DESIGN INFORMATION		DESIGN BY:		DATE	
CONDUCTOR	1272 MCM 45/7 ACSR	DAM/CDB	10/12/09	FACILITY: TRANSMISSION SYSTEM MAINTENANCE	
OPGW	AC-71/571	CDB	10/12/09	LOCATION UNIT: 296-230KV LINE-WILLISTON SUBSTATION TO TIOGA SUBSTATION	
STRINGING TENSION	6501	DESIGN CHK:	01/08/10	WILLISTON TO TIOGA 230KV TRANSMISSION LINE	
NESC TENSION	12617	DRAFT CHK:		SCALE: AS SHOWN COUNTY NAME: WILLIAMS	
DESIGN R.S.	800	APPROVED:	10/12/09	BASIN DRAWING NO. 296-090-T3-031	
ACTUAL R.S.	799			REV. 4	