

0870
 WANDA CLAYTON
 NE 1/4 SEC. 18 T156N R98W
 LENGTH 2638.93' 159.94 RODS 7.57 ACRES


0860
 ERIC HAUG
 NE 1/4 SEC. 18 T156N R98W
 LENGTH 2637.75' 159.86 RODS 7.57 ACRES

0850
 LARRY & DORINNE HAUG
 NW 1/4 SEC. 17 T156N R98W
 LENGTH 2638.93' 159.94 RODS 7.57 ACRES

NW 1/4
 SEC. 18 T156N R98W
 WILLIAMS CO., NORTH DAKOTA

NE 1/4
 SEC. 18 T156N R98W
 WILLIAMS CO., NORTH DAKOTA

LIDAR & AERIAL PHOTOGRAPHY
 JULY 20, 2008
 FUGRO HORIZONS, INC.

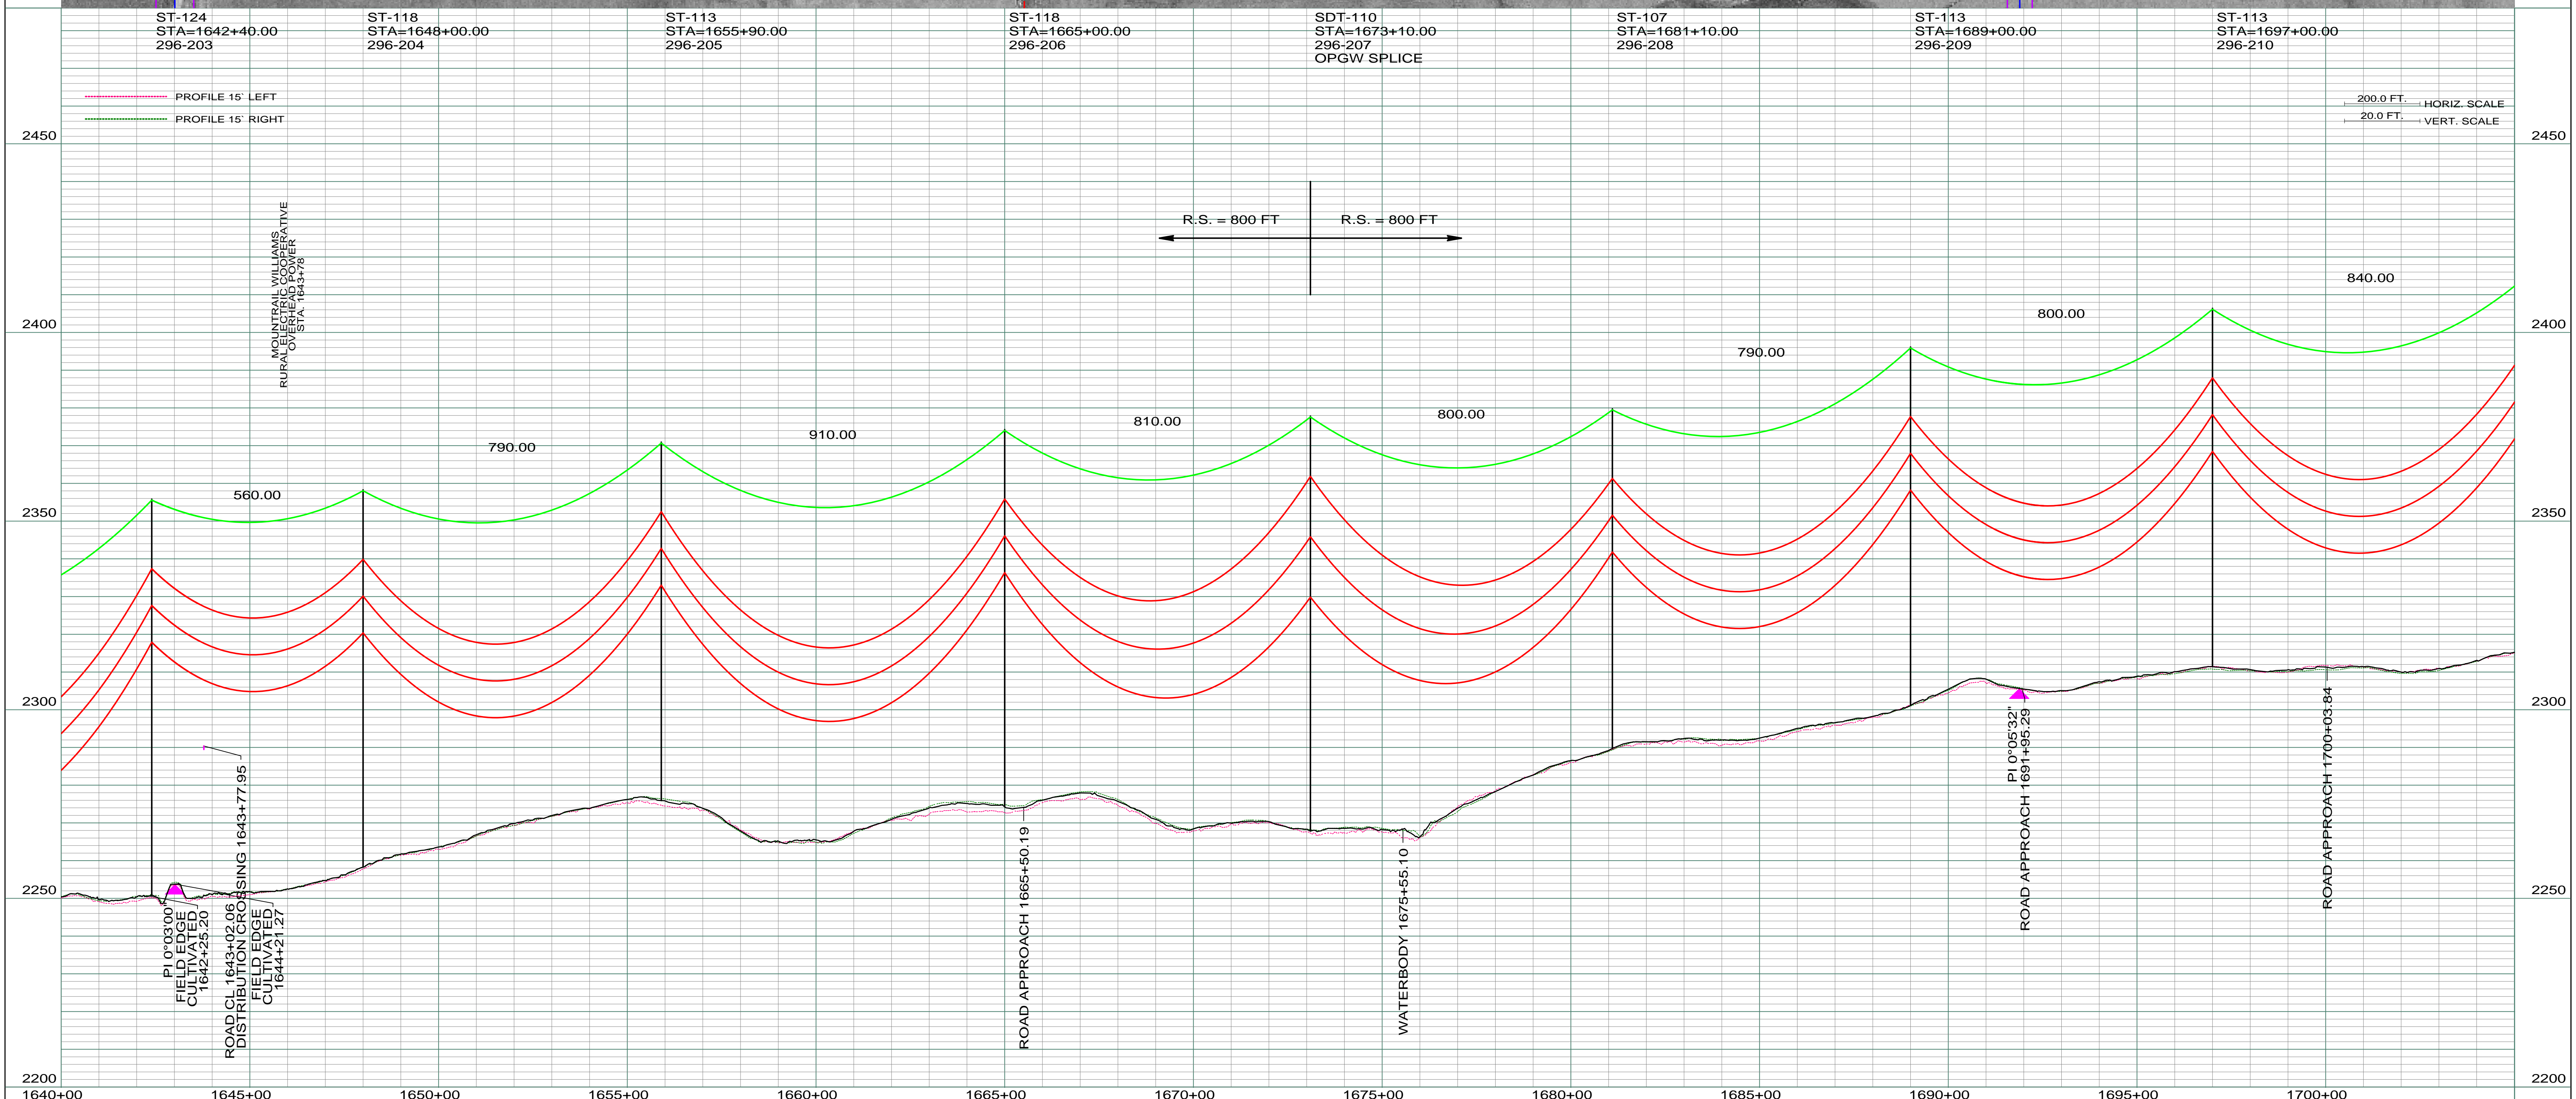

REV	DESCRIPTION	DRWN	DSGN	APPD	DATE
1	ISSUE FOR BID	CDB	CDB	DAM	10/27/09
2	ISSUED FOR CONSTRUCTION	CDB	CDB	DAM	02/03/10
3	MODIFIED CROSSING TEXT AND MILE INFORMATION 203 TO ST-124, 204 TO ST-118, MOVED 203 AHD 150FT, 204 BK 50FT	CDB	CDB	DAM	03/11/10
4	AS-BUILT	CDB	CDB	DAM	03/07/11

REV	DESCRIPTION	DRWN	DSGN	APPD	DATE

DESIGN INFORMATION					
CONDUCTOR	SIZE	STRINGING TENSION	NESC TENSION	DESIGN R.S.	ACTUAL R.S.
	1272 MCM 45/7 ACSR	6501	12617	800	830
	OPGW	AC-71/571	2285	5932	800

DESIGN BY:	DATE
DAM/CDB	10/12/09
DRAWN BY:	DATE
CDB	10/12/09
DESIGN CHK:	DATE
MBN ENGRG.	01/08/10
DRAFT CHK:	
APPROVED:	DATE
DAM	10/12/09

FACILITY: TRANSMISSION SYSTEM MAINTENANCE
 LOCATION UNIT: 296-230KV LINE-WILLISTON SUBSTATION TO TIOGA SUBSTATION
 WILLISTON TO TIOGA 230KV TRANSMISSION LINE
 PLAN AND PROFILE
 MILE 31 & 32

	BASIN ELECTRIC POWER COOPERATIVE 1717 EAST INTERSTATE AVENUE BISMARCK, NORTH DAKOTA PHONE 701-223-0441
	SCALE: AS SHOWN COUNTY NAME: WILLIAMS BASIN DRAWING NO. 296-090-T3-032 REV. 4