


NW 1/4  
SEC. 17 T156N R97W  
WILLIAMS CO., NORTH DAKOTA

NE 1/4  
SEC. 17 T156N R97W  
WILLIAMS CO., NORTH DAKOTA

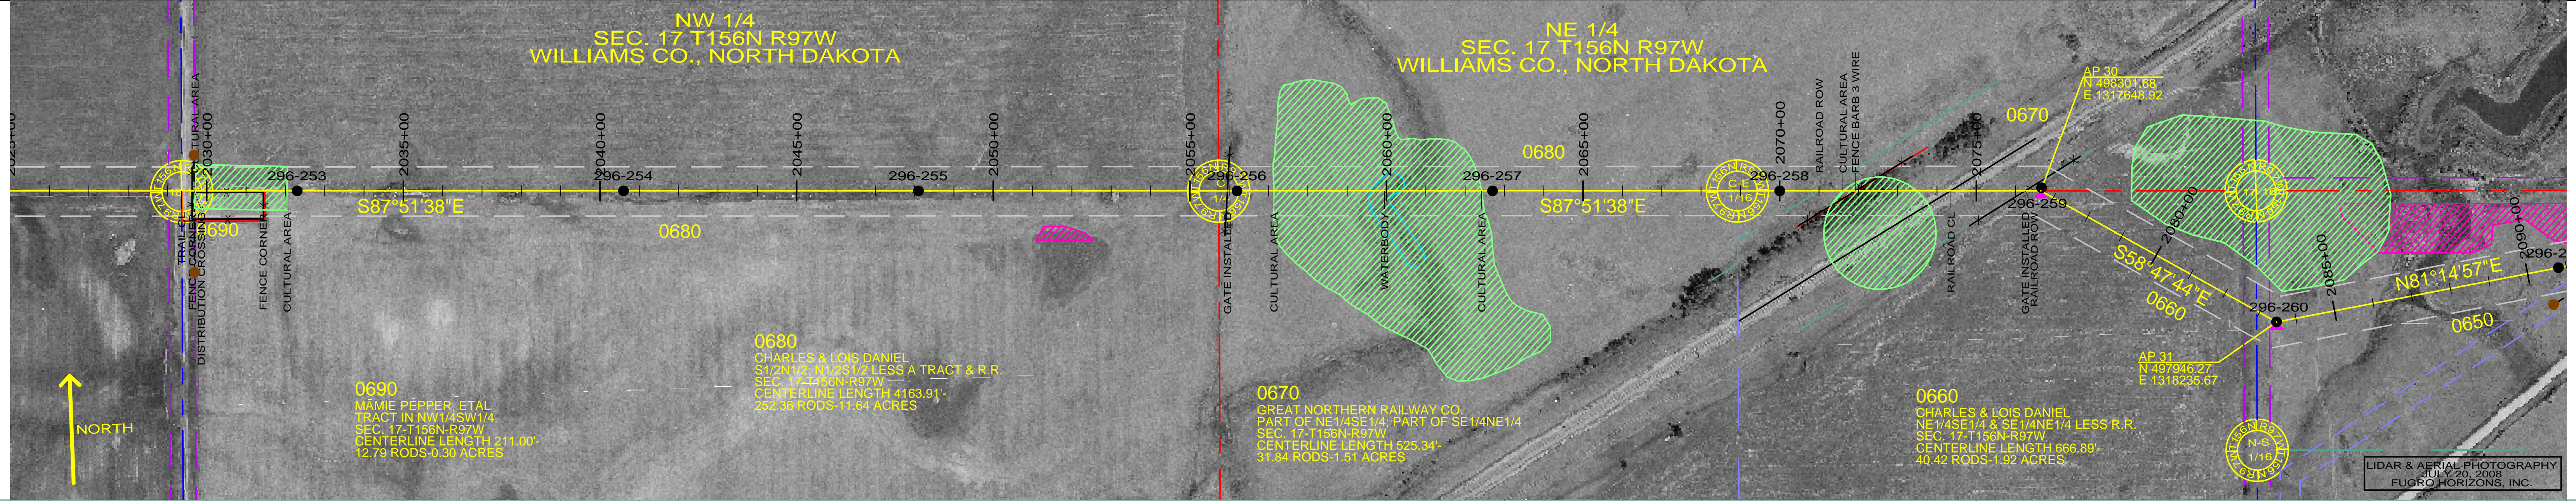

0690  
MAMIE PEPPER, ETAL  
TRACT IN NW 1/4 SW 1/4  
SEC. 17 T156N R97W  
CENTERLINE LENGTH 211.00'  
12.79 RODS-0.30 ACRES

0680  
CHARLES & LOIS DANIEL  
S 1/2 NW 1/4 MANSUEZ LESS A TRACT & R.R.  
SEC. 17 T156N R97W  
CENTERLINE LENGTH 4163.91'  
232.46 RODS-17.84 ACRES

0670  
GREAT NORTHERN RAILWAY CO.  
PART OF NE 1/4 SE 1/4, PART OF SE 1/4 NE 1/4  
SEC. 17 T156N R97W  
CENTERLINE LENGTH 525.34'  
31.84 RODS-1.51 ACRES

0660  
CHARLES & LOIS DANIEL  
NE 1/4 SE 1/4 & SE 1/4 NE 1/4 LESS R.R.  
SEC. 17 T156N R97W  
CENTERLINE LENGTH 666.89'  
40.42 RODS-1.92 ACRES

LIDAR & AERIAL PHOTOGRAPHY  
JULY 20, 2008  
FUGRO HORIZONS, INC.

ST-118  
STA=2032+30.00  
296-253

ST-113  
STA=2040+60.00  
296-254

ST-118  
STA=2048+10.00  
296-255

ST-113  
STA=2056+20.00  
296-256

ST-113  
STA=2062+70.00  
296-257


ST-124  
STA=2070+00.00  
296-258

SA38-110  
STA=2076+63.93  
HT ADJUST=1.50  
OFFSET ADJUST=-8.30  
296-259  
AP 30

SD40-095  
STA=2083+49.93  
HT ADJUST=1.50  
296-260  
AP 31  
OPGW SPLICE

PROFILE 15' LEFT  
PROFILE 15' RIGHT

200.0 FT. - HORIZ. SCALE  
20.0 FT. - VERT. SCALE

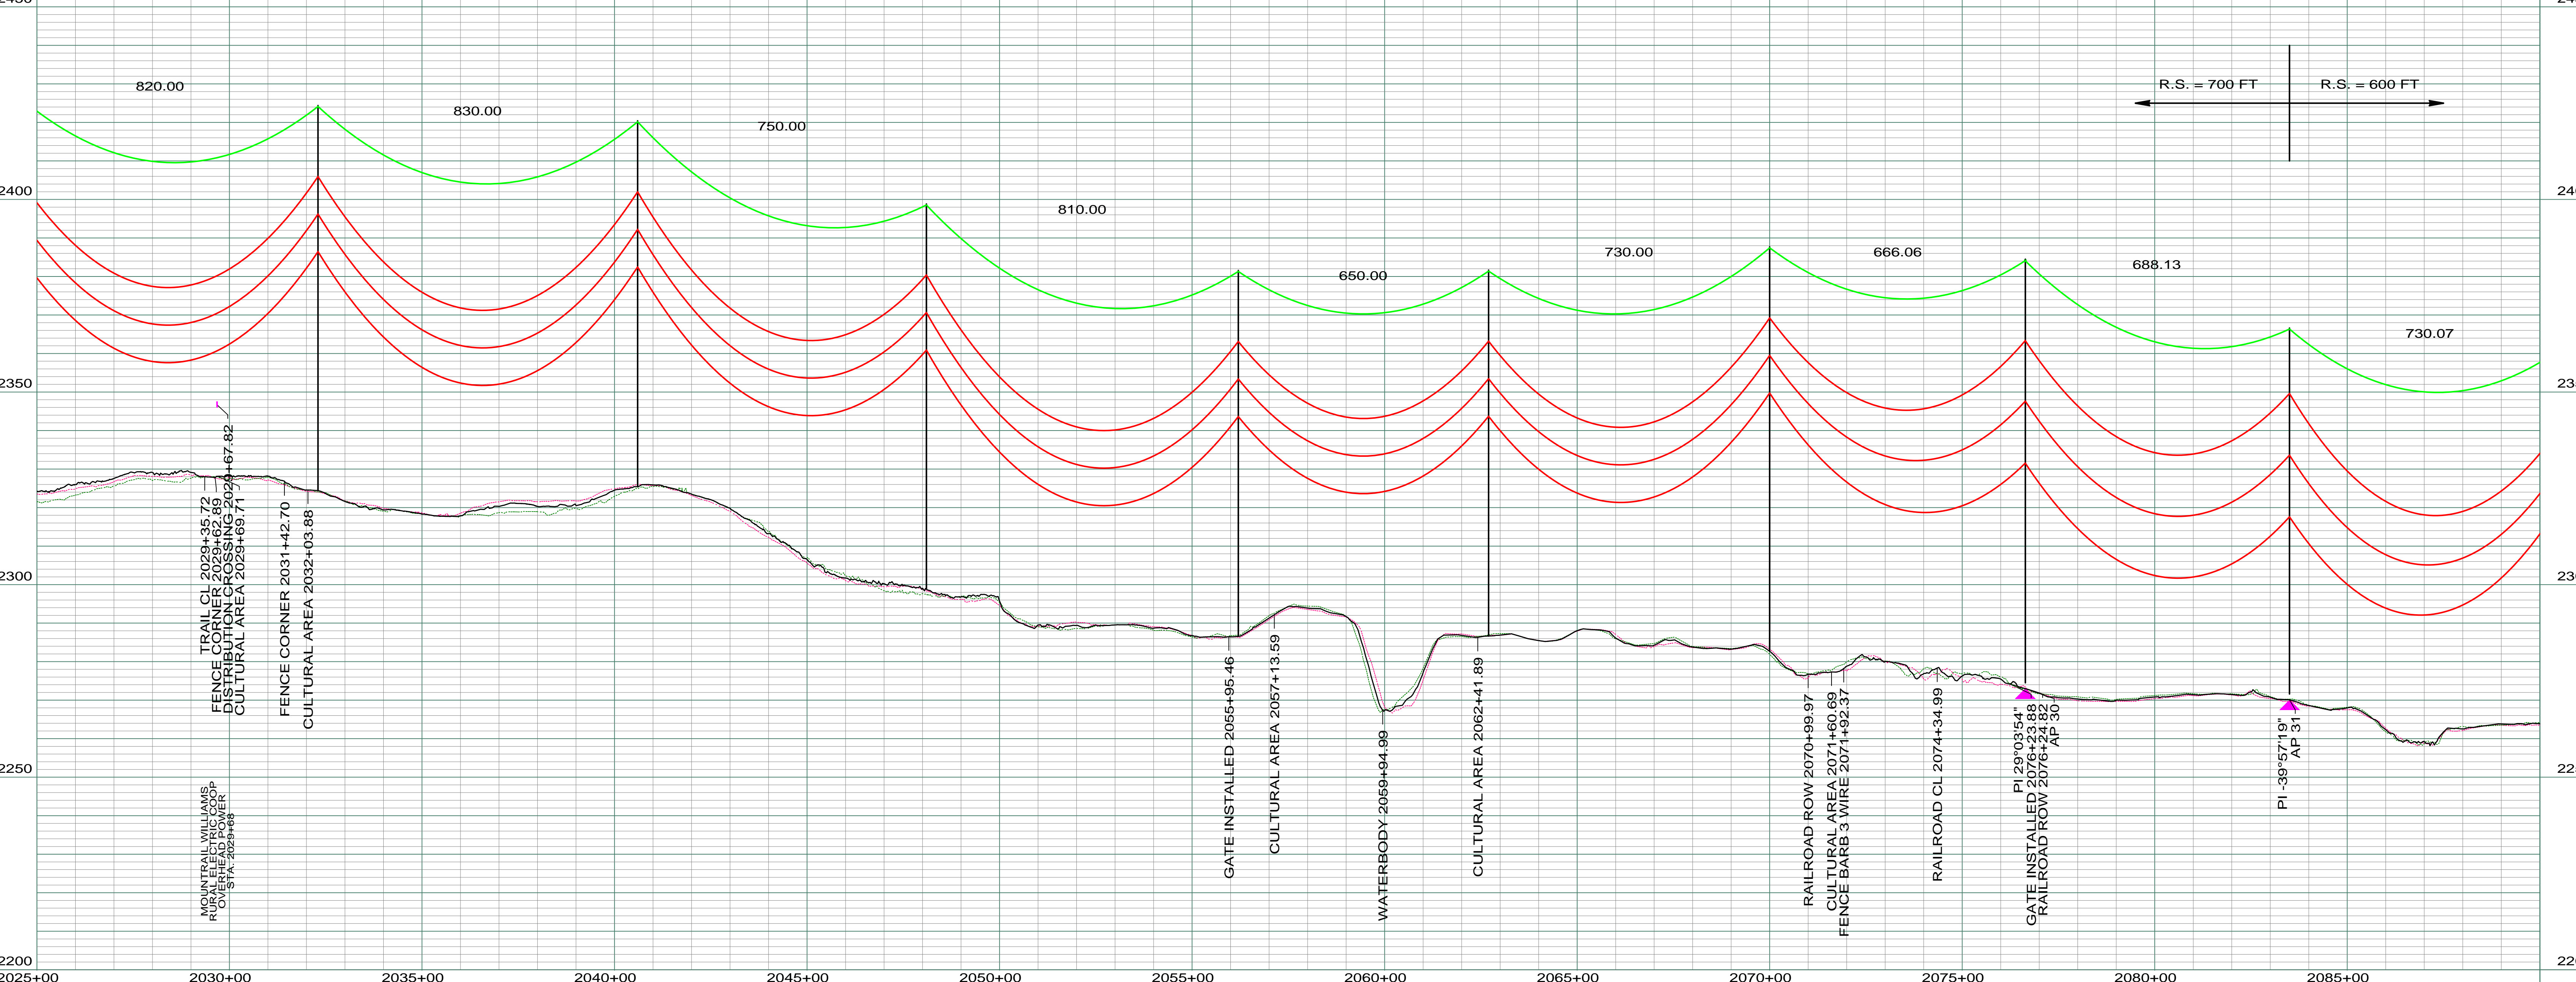

REV	DESCRIPTION	DRWN	DSGN	APPD	DATE	REV	DESCRIPTION	DRWN	DSGN	APPD	DATE
1	ISSUE FOR BID	CDB	CDB	DAM	10/27/09						
2	ISSUED FOR CONSTRUCTION	CDB	CDB	DAM	02/03/10						
3	MODIFIED CROSSING TEXT AND MILE INFORMATION	CDB	CDB	DAM	03/11/10						
4	AS-BUILT	CDB	CDB	DAM	03/07/11						

STATE NAME: NORTH DAKOTA		NAD83 NDSPCS INTL FT NORTH ZONE				DESIGN BY: DAM/CDB	10/12/09
DESIGN INFORMATION						DRAWN BY: CDB	10/12/09
CONDUCTOR	1272 MCM 45/7 ACSR	STRINGING TENSION	6549	NESC TENSION	12533	DESIGN R.S.	700
OPGW	AC-71/571		2248		5660	ACTUAL R.S.	744
						DESIGN CHK: MBN ENGRG.	01/08/10
						DRAFT CHK:	
						APPROVED: DAM	10/12/09
FACILITY: TRANSMISSION SYSTEM MAINTENANCE		WILLISTON TO TIOGA 230KV TRANSMISSION LINE					
LOCATION UNIT: 296-230KV LINE-WILLISTON SUBSTATION TO TIOGA SUBSTATION		SCALE: AS SHOWN					
		COUNTY NAME: WILLIAMS					
		PLAN AND PROFILE					
		MILE 38 & 39					
		BASIN DRAWING NO. 296-090-T3-039					
		REV. 4					