


LIDAR & AERIAL PHOTOGRAPHY
JULY 20, 2008
FUGRO HORIZONS, INC.

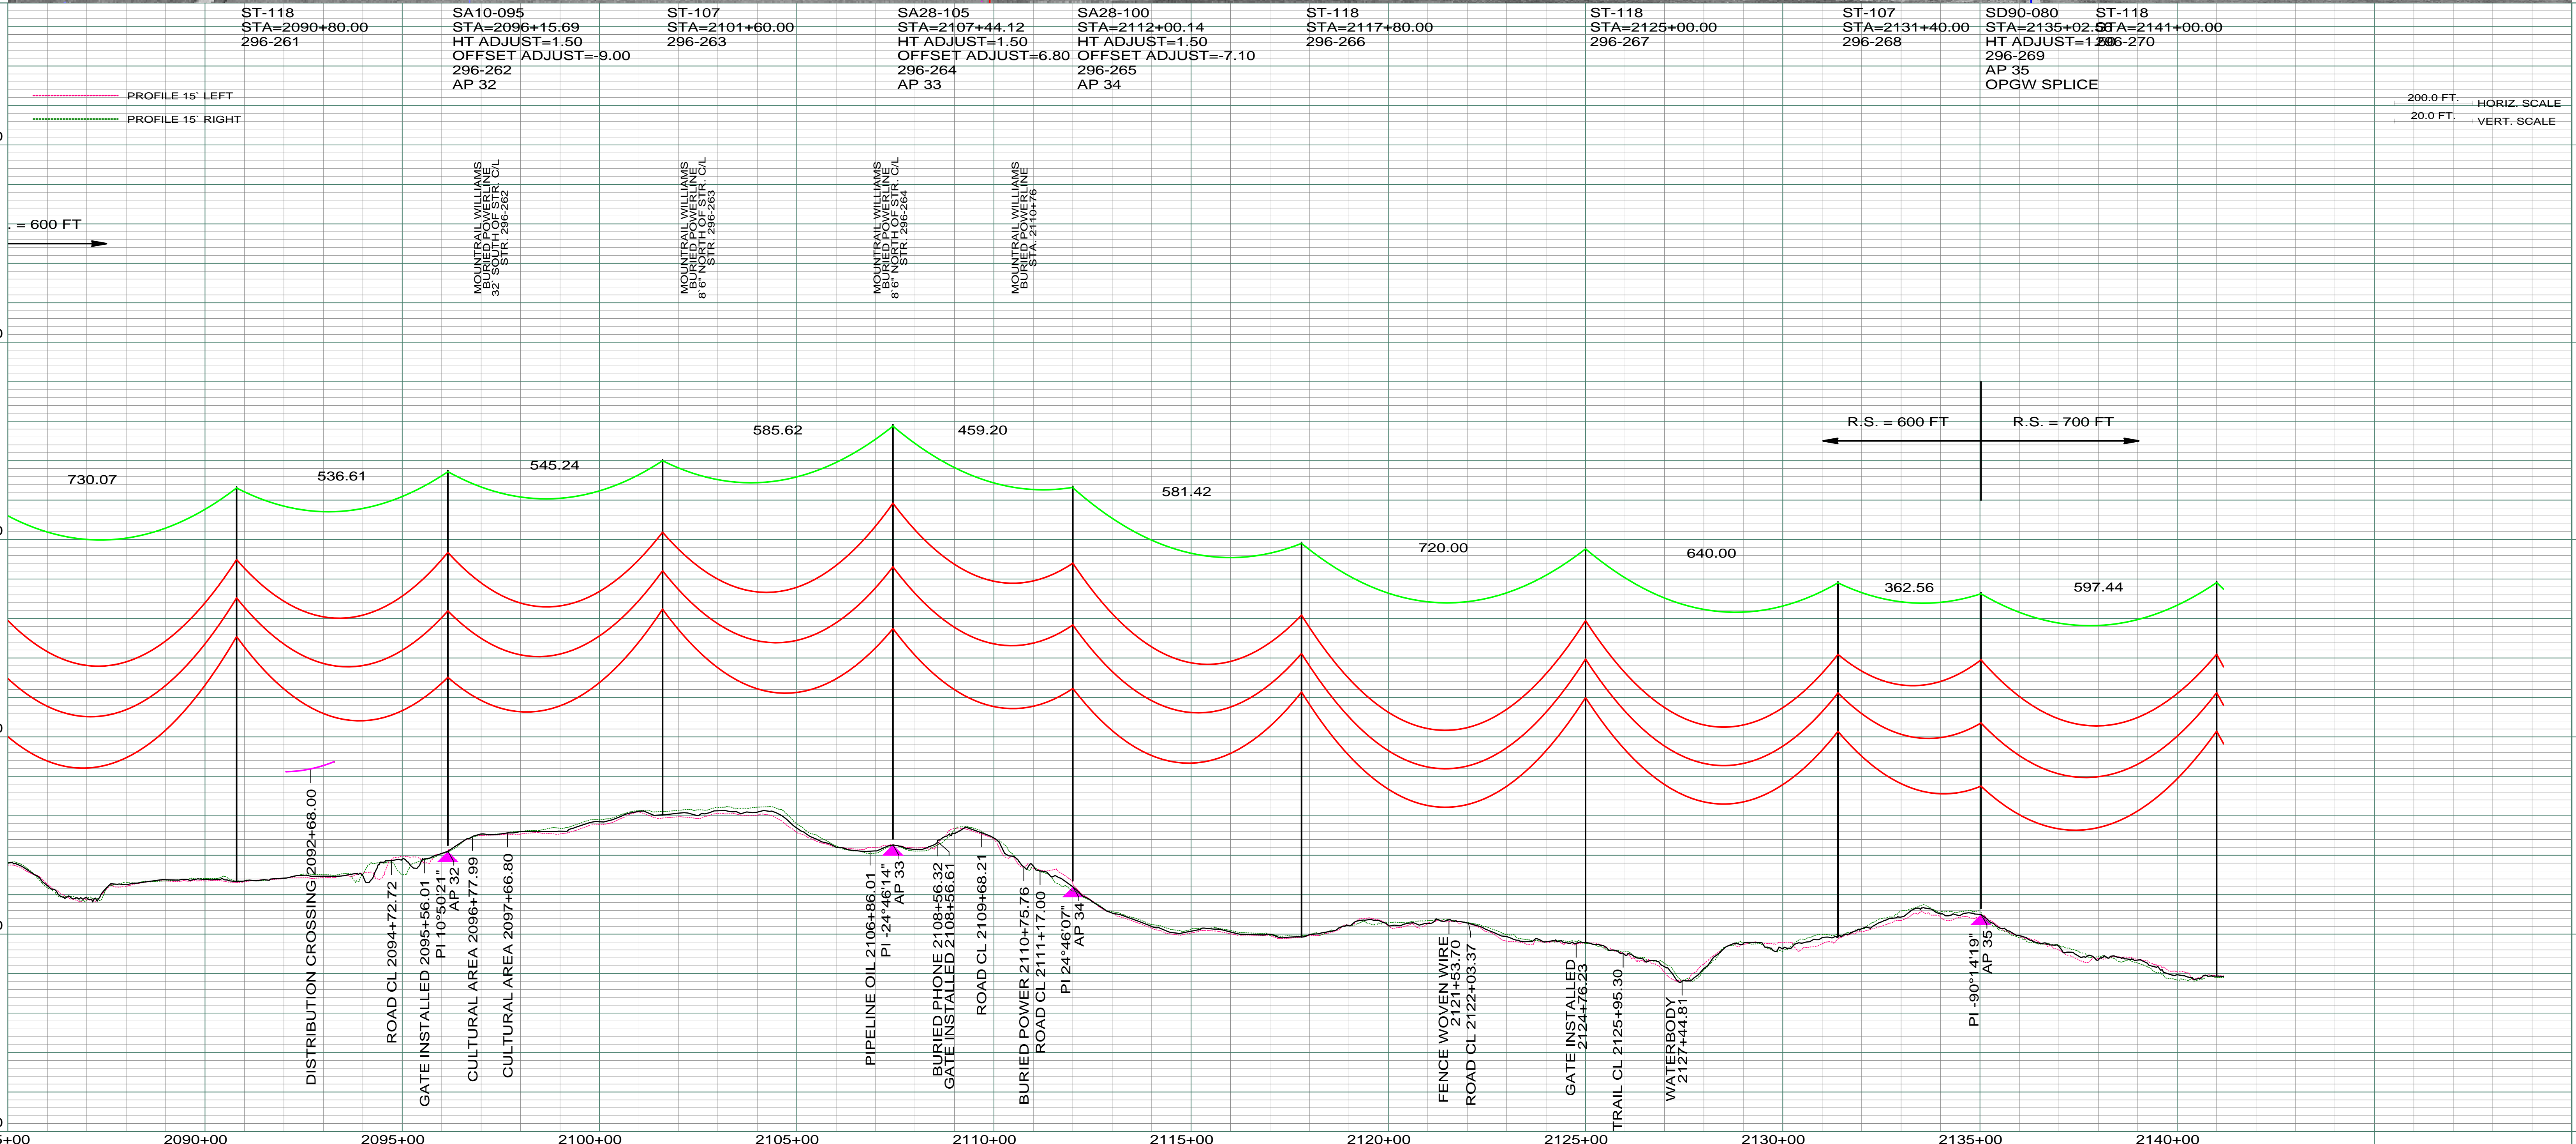

REV	DESCRIPTION	DRWN	DSGN	APPD	DATE
1	ISSUE FOR BID	CDB	CDB	DAM	10/27/09
2	ISSUED FOR CONSTRUCTION	CDB	CDB	DAM	02/03/10
3	MODIFIED CROSSING TEXT AND MILE INFORMATION	CDB	CDB	DAM	03/11/10
4	AS-BUILT	CDB	CDB	DAM	03/07/11

REV	DESCRIPTION	DRWN	DSGN	APPD	DATE
1	ISSUE FOR BID	CDB	CDB	DAM	10/27/09
2	ISSUED FOR CONSTRUCTION	CDB	CDB	DAM	02/03/10
3	MODIFIED CROSSING TEXT AND MILE INFORMATION	CDB	CDB	DAM	03/11/10
4	AS-BUILT	CDB	CDB	DAM	03/07/11

DESIGN INFORMATION		DESIGNER		DATE	
STATE NAME:	NORTH DAKOTA	DESIGN BY:	DAM/CDB	DATE:	10/12/09
CONDUCTOR:	1272 MCM 45/7 ACSR	DRAWN BY:	CDB	DATE:	10/12/09
OPGW:	AC-71/571	DESIGN CHK:	MBN ENGRG.	DATE:	01/08/10
		DRAFT CHK:		DATE:	
		APPROVED:	DAM	DATE:	10/12/09

FACILITY:		TRANSMISSION SYSTEM MAINTENANCE	
LOCATION UNIT:		296-230KV LINE-WILLISTON SUBSTATION TO TIOGA SUBSTATION	
SCALE:		AS SHOWN	
COUNTY NAME:		WILLIAMS	
BASIN DRAWING NO.:		296-090-T3-040	
REV.:		4	

WILLISTON TO TIOGA 230KV TRANSMISSION LINE
PLAN AND PROFILE
MILE 39 & 40