


| REV | DESCRIPTION | DRWN | DSGN | APPD | DATE | REV | DESCRIPTION | DRWN | DSGN | APPD | DATE |
|-----|--|------|------|------|----------|-----|---|------|------|------|----------|
| 1 | ISSUE FOR BID | CDB | CDB | DAM | 10/27/09 | 5 | MOVED STR 271 AHD 10 FT TO STA 2150+60, STR 272 AHD 2 FT TO STA 2158+31.96, STR 273 AHD 20 FT TO STA 2162+33.25 | CDB | CDB | DAM | 07/09/10 |
| 2 | ISSUED FOR CONSTRUCTION | CDB | CDB | DAM | 02/03/10 | 6 | MOVED STR 276 5 FT AHEAD TO AVOID BURIED FIBER | CDB | CDB | DAM | 09/30/10 |
| 3 | MODIFIED CROSSING TEXT AND MILE INFORMATION | CDB | CDB | DAM | 03/11/10 | 7 | AS-BUILT | CDB | CDB | DAM | 02/25/11 |
| 4 | ADDED WATER PIPELINE 2158+05, MOVED STRS 272, 273 (AP 36, 37), ADDED STATION EQUATION, MADE STR 274 AP 37A | CDB | CDB | DAM | 04/05/10 | | | | | | |

| DESIGN INFORMATION | | DESIGN BY: DAM/CDB | | | | 10/12/09 | | | |
|--------------------|--------------------|---------------------------------|------|--------------|-------|-------------|-----|-------------|-----|
| DRAWN BY: CDB | | DESIGN CHK: MBN ENGRG. | | | | 10/12/09 | | | |
| DRAFT CHK: | | APPROVED: DAM | | | | 10/12/09 | | | |
| STATE NAME: | NORTH DAKOTA | NAD83 NDSPCS INTL FT NORTH ZONE | | | | | | | |
| CONDUCTOR | 1272 MCM 45/7 ACSR | STRINGING TENSION | 6549 | NESC TENSION | 12533 | DESIGN R.S. | 700 | ACTUAL R.S. | 719 |
| OPGW | AC-71/571 | | 2248 | | 5660 | | 700 | | 719 |

| | | |
|--|---|-----------------------|
| FACILITY: | TRANSMISSION SYSTEM MAINTENANCE | |
| LOCATION UNIT: | 296-230KV LINE-WILLISTON SUBSTATION TO TIOGA SUBSTATION | |
| WILLISTON TO TIOGA 230KV TRANSMISSION LINE | | |
| SCALE: | AS SHOWN | COUNTY NAME: WILLIAMS |
| BASIN DRAWING NO. | 296-090-T3-041 | REV. 7 |
| PLAN AND PROFILE MILE 40 & 41 | | |

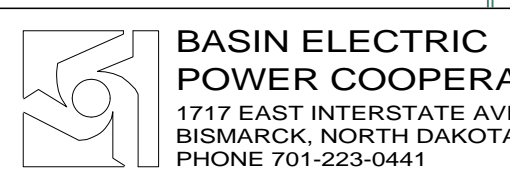

BASIN ELECTRIC
POWER COOPERATIVE
1717 EAST INTERSTATE AVENUE
BISMARCK, NORTH DAKOTA
PHONE 701-223-0441