
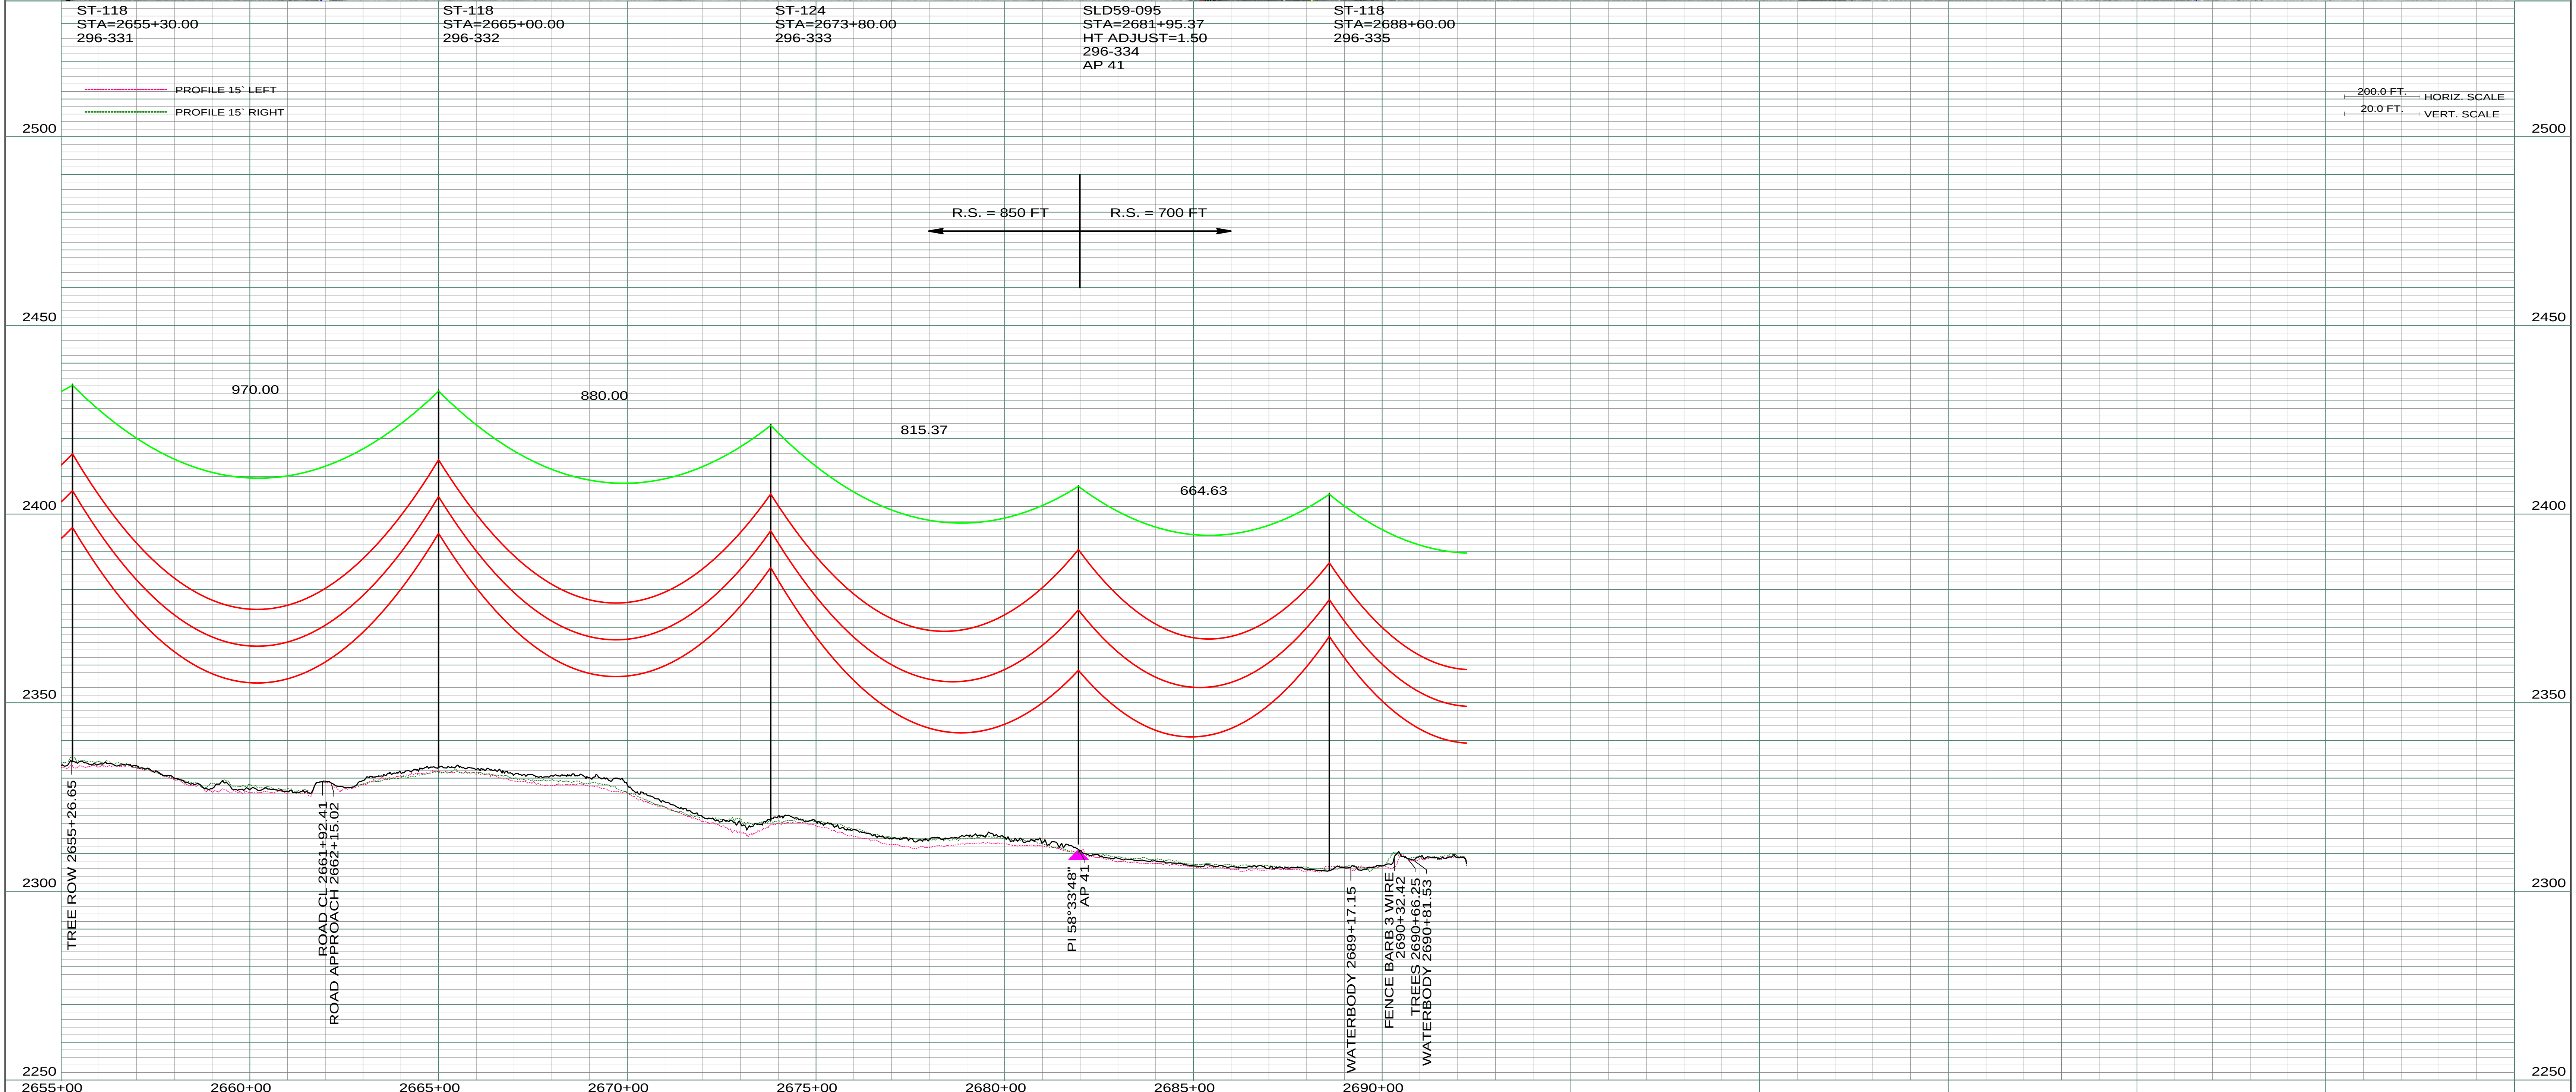


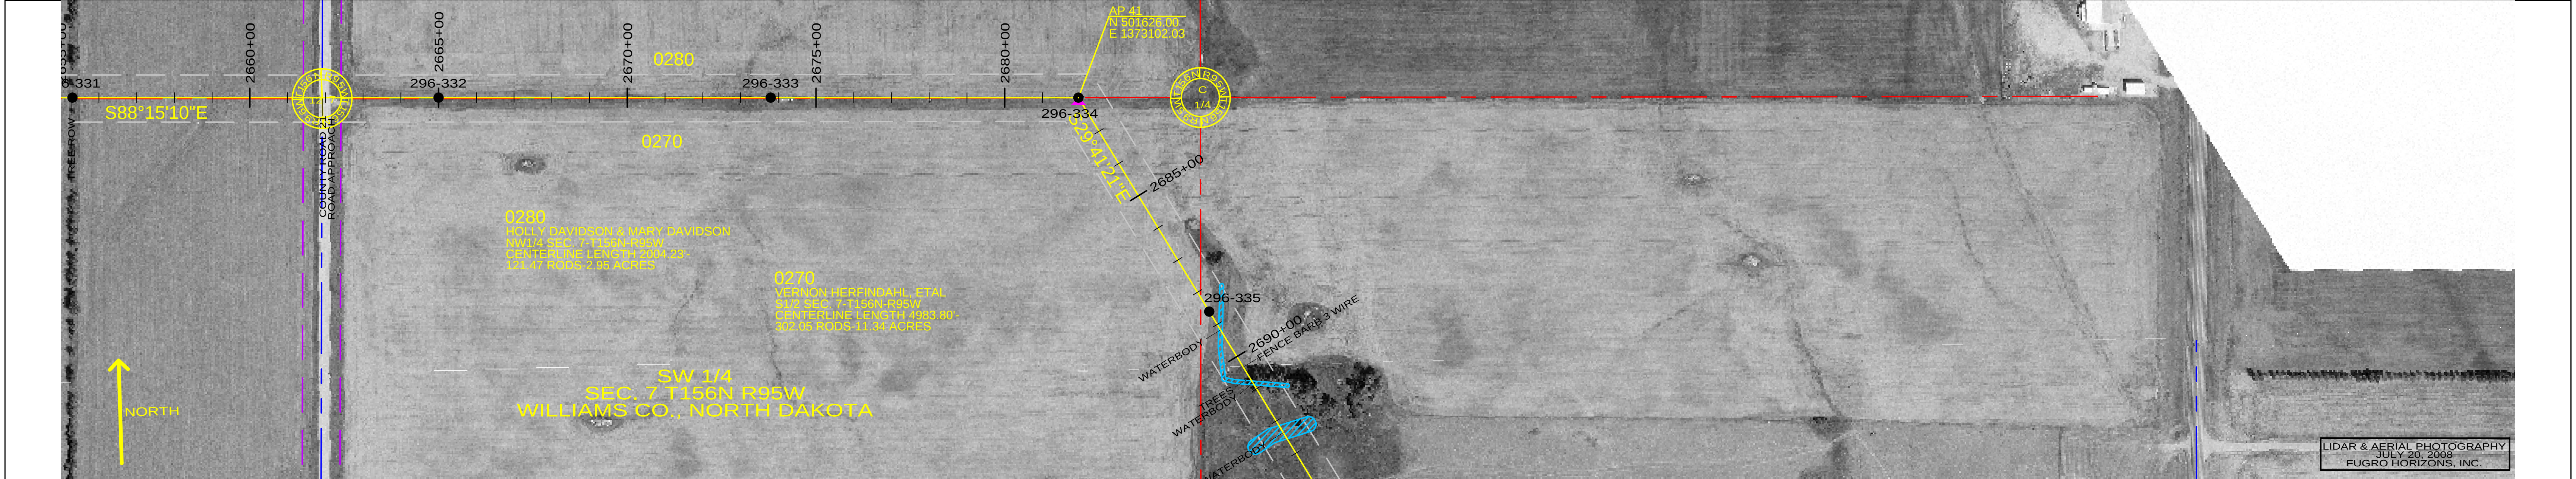

REV	DESCRIPTION	DRWN	DSGN	APPD	DATE	REV	DESCRIPTION	DRWN	DSGN	APPD	DATE	STATE NAME: NORTH DAKOTA	NAD83 NDSPCS INTL FT NORTH ZONE	DESIGN BY: DAM/CDB	10/12/09	FACILITY: TRANSMISSION SYSTEM MAINTENANCE	LOCATION UNIT: 296-230KV LINE-WILLISTON SUBSTATION TO TIOGA SUBSTATION	SCALE: AS SHOWN	COUNTY NAME: WILLIAMS
1	ISSUE FOR BID	CDB	CDB	DAM	10/27/09							DESIGN INFORMATION		DRAWN BY: CDB	10/12/09				
2	CHANGED STR 333 TO ST-124, ISSUED FOR CONSTRUCTION	CDB	CDB	DAM	02/03/10							CONDUCTOR	1272 MCM 45/7 ACSR	6501	12617	850	881	DESIGN CHK: MBN ENGRG.	01/08/10
3	MODIFIED CROSSING TEXT AND MILE INFORMATION	CDB	CDB	DAM	03/11/10							OPGW	AC-71/571	2281	6035	850	853	DRAFT CHK:	
4	AS-BUILT	CDB	CDB	DAM	03/07/11									APPROVED: DAM	10/12/09				
WILLISTON TO TIOGA 230KV TRANSMISSION LINE																	PLAN AND PROFILE		
MILE 50																	296-090-T3-051		
																	4		