


SE 1/4
SEC. 7 T156N R95W
WILLIAMS CO., NORTH DAKOTA

0265
DENNIS & EVELYN EKLUND
PART OF S1/2SE1/4 SEC. 7-T156N-R95W
CENTERLINE LENGTH 239.55-14.52 RODS-0.01 ACRES

NE 1/4
SEC. 18 T156N R95W
WILLIAMS CO., NORTH DAKOTA



LIDAR & AERIAL PHOTOGRAPHY
JULY 20, 2008
FUGRO HORIZONS, INC.

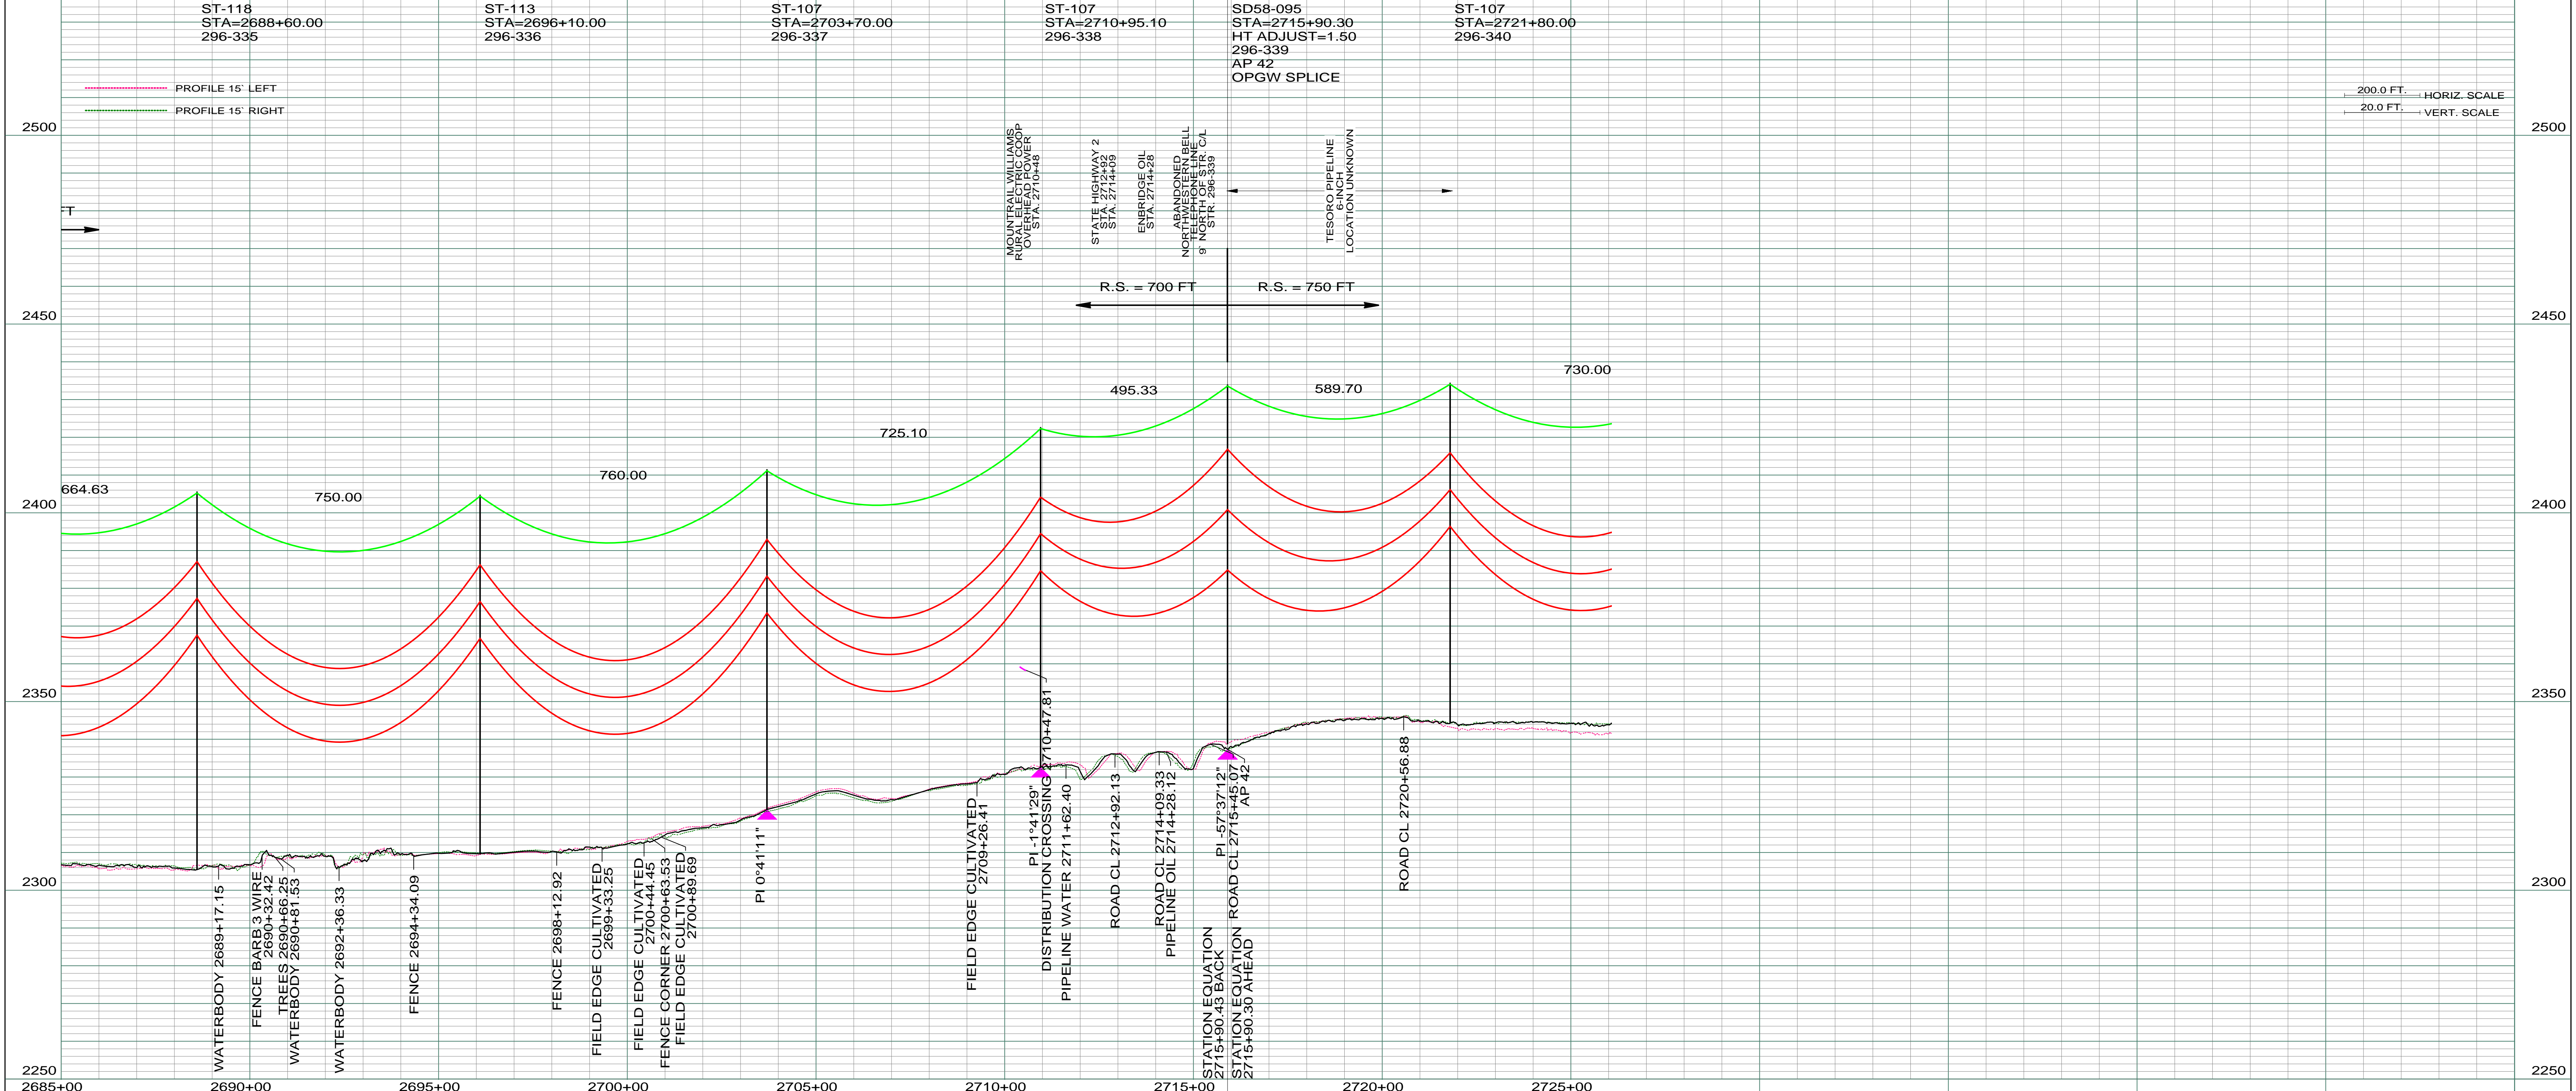

REV	DESCRIPTION	DRWN	DSGN	APPD	DATE	REV	DESCRIPTION	DRWN	DSGN	APPD	DATE
1	ISSUE FOR BID	CDB	CDB	DAM	10/27/09	5	AS-BUILT	CDB	CDB	DAM	03/07/11
2	ISSUED FOR CONSTRUCTION	CDB	CDB	DAM	02/03/10						
3	MODIFIED CROSSING TEXT AND MILE INFORMATION	CDB	CDB	DAM	03/11/10						
4	OFFSET STR 338 10 FT WEST, CREATED AP 41A AT STR 337 AND AP 41B AT STR 338. STA. EQ. AT AP 42, ADDED 0265 PROPERTY	CDB	CDB	DAM	08/30/10						

DESIGN INFORMATION		DESIGN BY:		DATE	
STATE NAME:	NORTH DAKOTA	DAM/CDB		10/12/09	
CONDUCTOR	1272 MCM 45/7 ACSR	DRAWN BY:		10/12/09	
STRINGING TENSION	6549	DESIGN CHK:		01/08/10	
NESS TENSION	12533	DRAFT CHK:			
DESIGN R.S.	700	APPROVED:		10/12/09	
ACTUAL R.S.	699	DAM			
OPGW	AC-71/571				
STRINGING TENSION	2248				
NESS TENSION	5660				
DESIGN R.S.	700				
ACTUAL R.S.	699				

FACILITY:		DATE	
TRANSMISSION SYSTEM MAINTENANCE		10/12/09	
LOCATION UNIT:		DATE	
296-230KV LINE-WILLISTON SUBSTATION TO TIOGA SUBSTATION		01/08/10	
WILLISTON TO TIOGA 230KV TRANSMISSION LINE		DATE	
PLAN AND PROFILE			
MILE 50 & 51			

SCALE: AS SHOWN COUNTY NAME: WILLIAMS

BASIN DRAWING NO. REV. 296-090-T3-052 5

BASIN ELECTRIC POWER COOPERATIVE
1717 EAST INTERSTATE AVENUE
BISMARCK, NORTH DAKOTA
PHONE 701-223-0441