
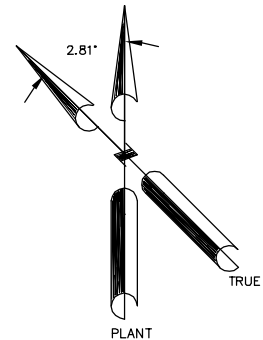


David W. Enbridge Pipelines \2534 - Phase VI CAD\Crookston Station\Planting-Civil-Structural-Survey\As-Built\534-P-13001.dwg 2/4/2010 8:56:30 AM

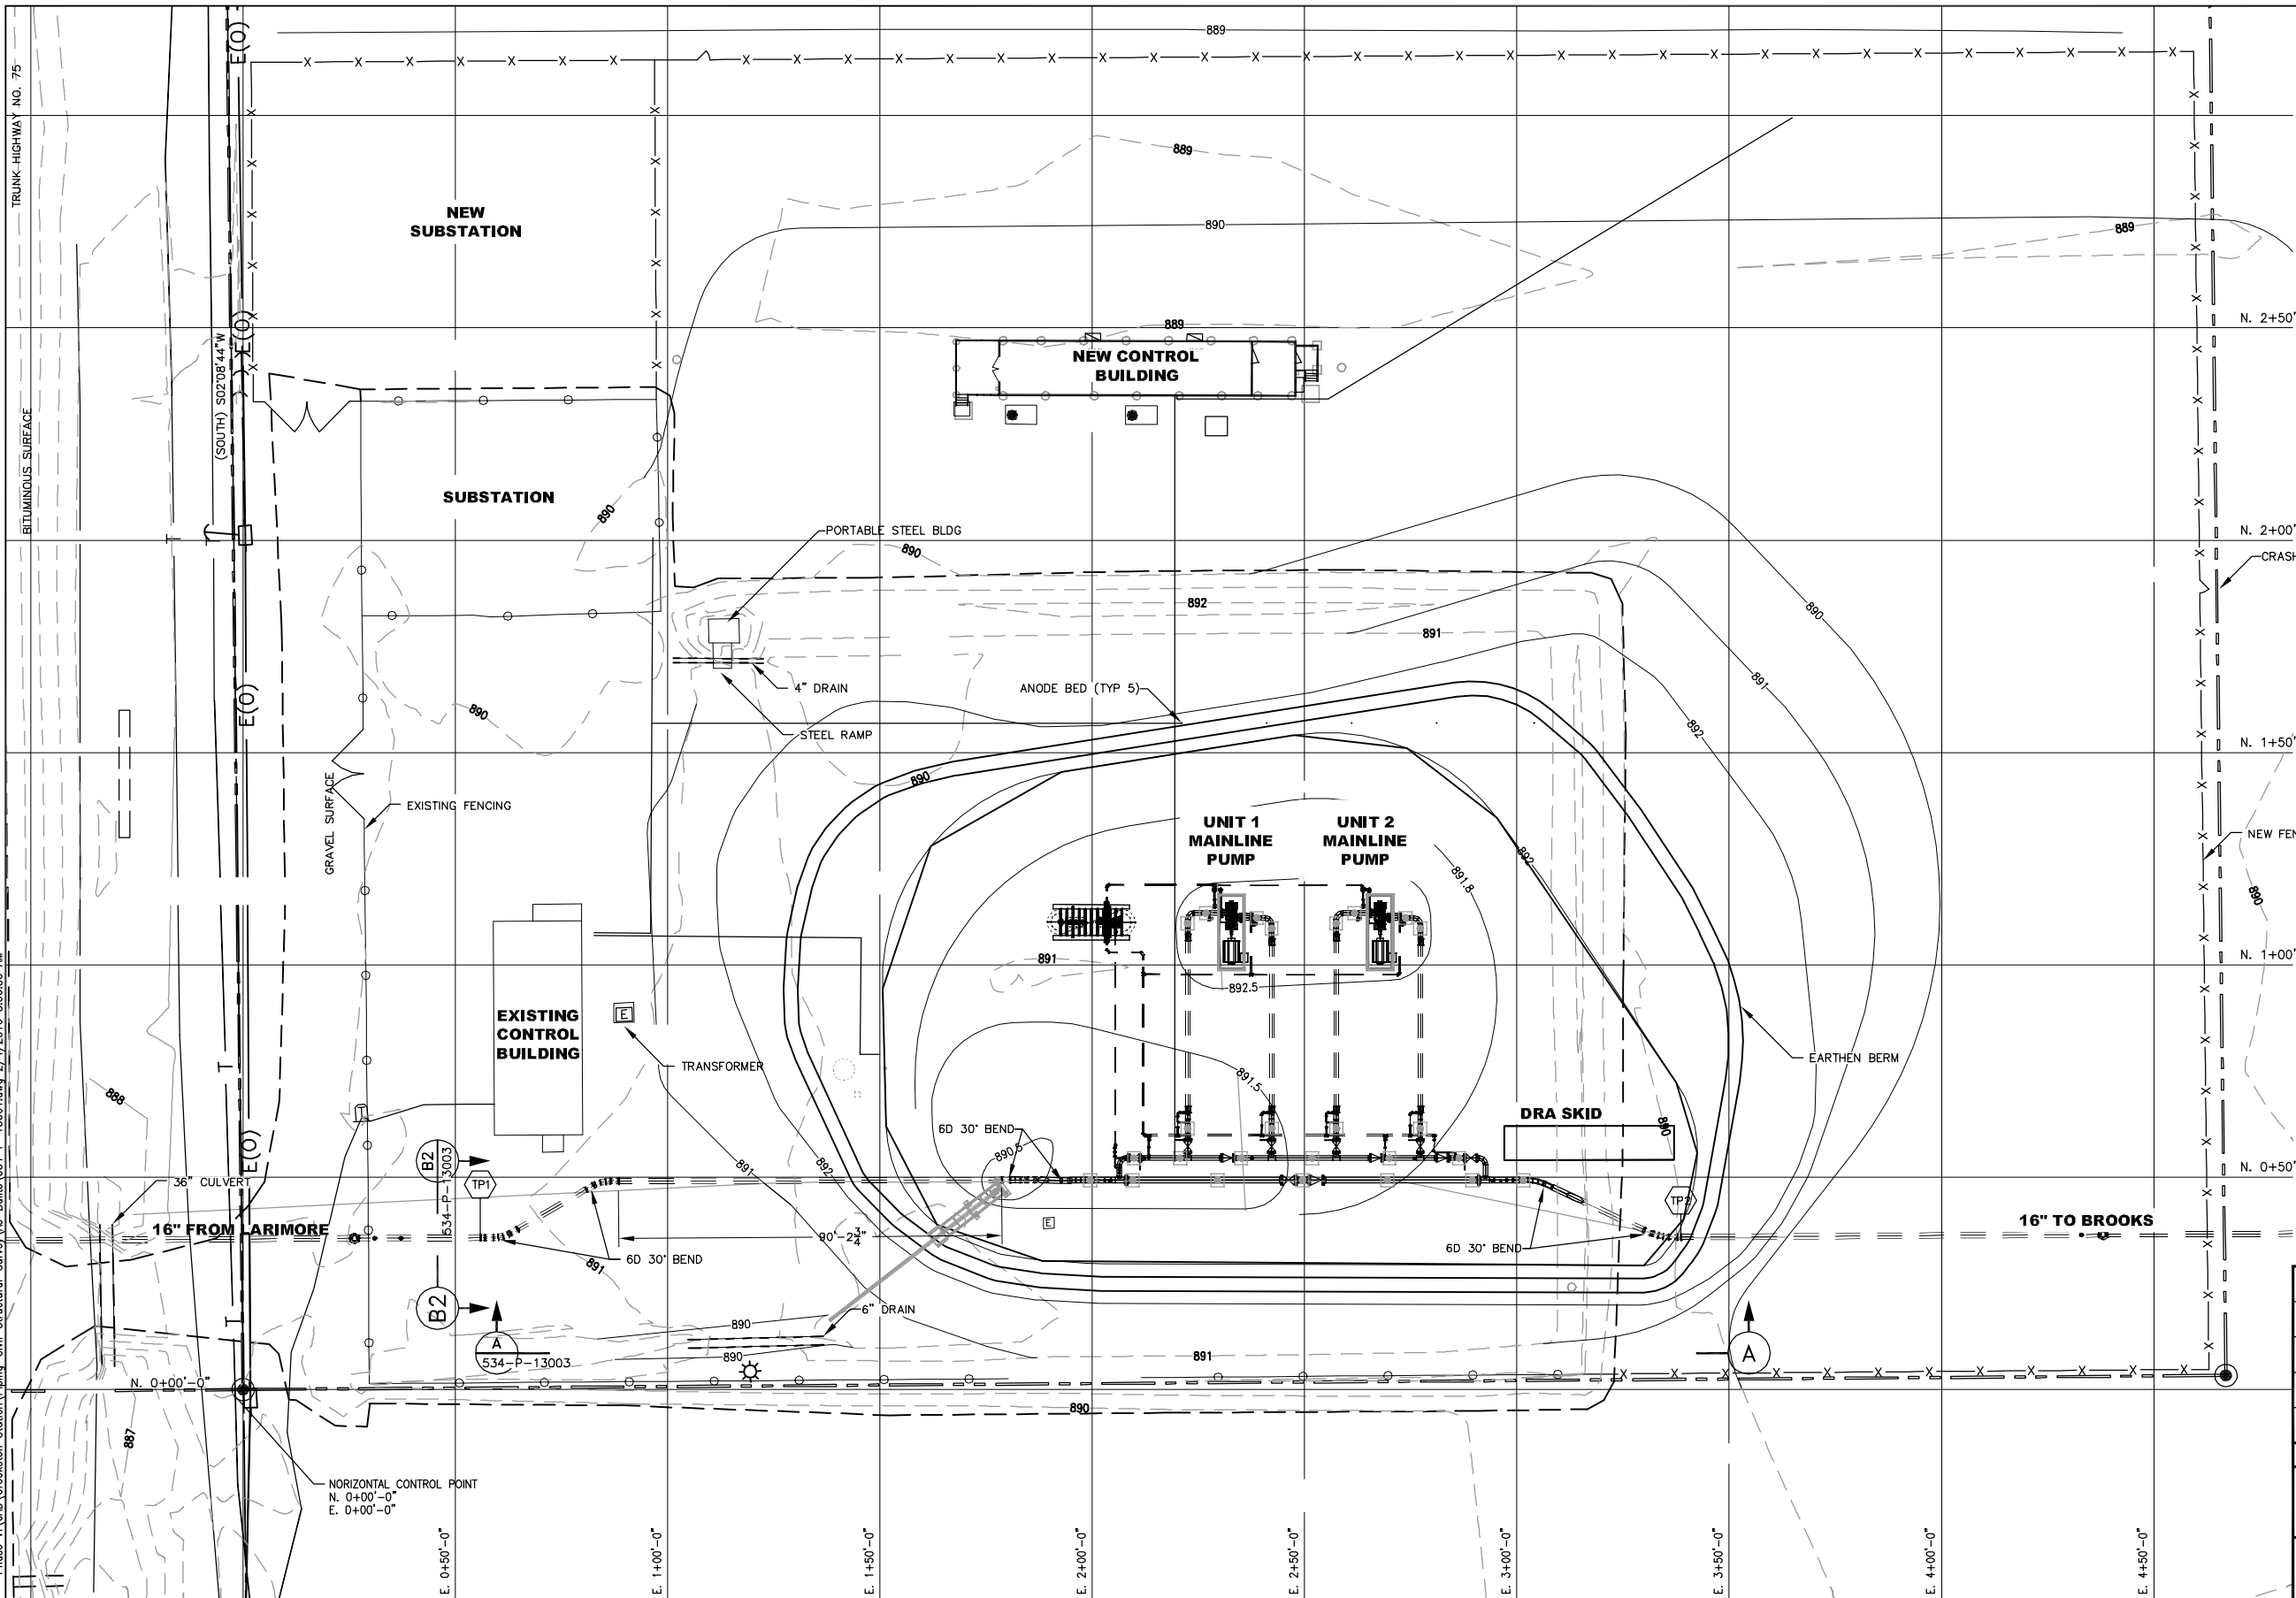

1	ISSUED FOR AS-BUILT	2/5/10	DLW
NO	REVISION	DATE	APPR BY

ENBRIDGE PIPELINES (NORTH DAKOTA) LLC
CROOKSTON (MN) STATION
 NEW PLOT PLAN

PROJECT: ENBRIDGE - 2534-13		
SCALE: 1"=20'	DATE: 1/30/08	DRAWN: ALF
CHECK: GR	APPR: TAK	DATE: 9/12/08

DWG. NO. 534-P-13001

Rooney Engineering, Inc.
 12201 E. Arapahoe Rd.
 Centennial, CO 80112
 (303) 792-5911