
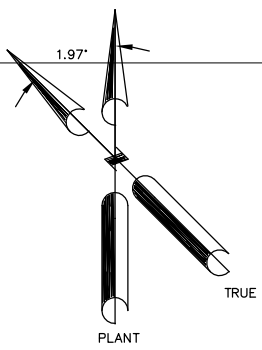


TonyF:\W\Enbridge Pipelines\02534 - Phase V\CAD\Cleerbrook Station\Piping-Civil-Structure-Survey\As-Built\534-P-15001.dwg 2/23/2010 11:36:23 AM

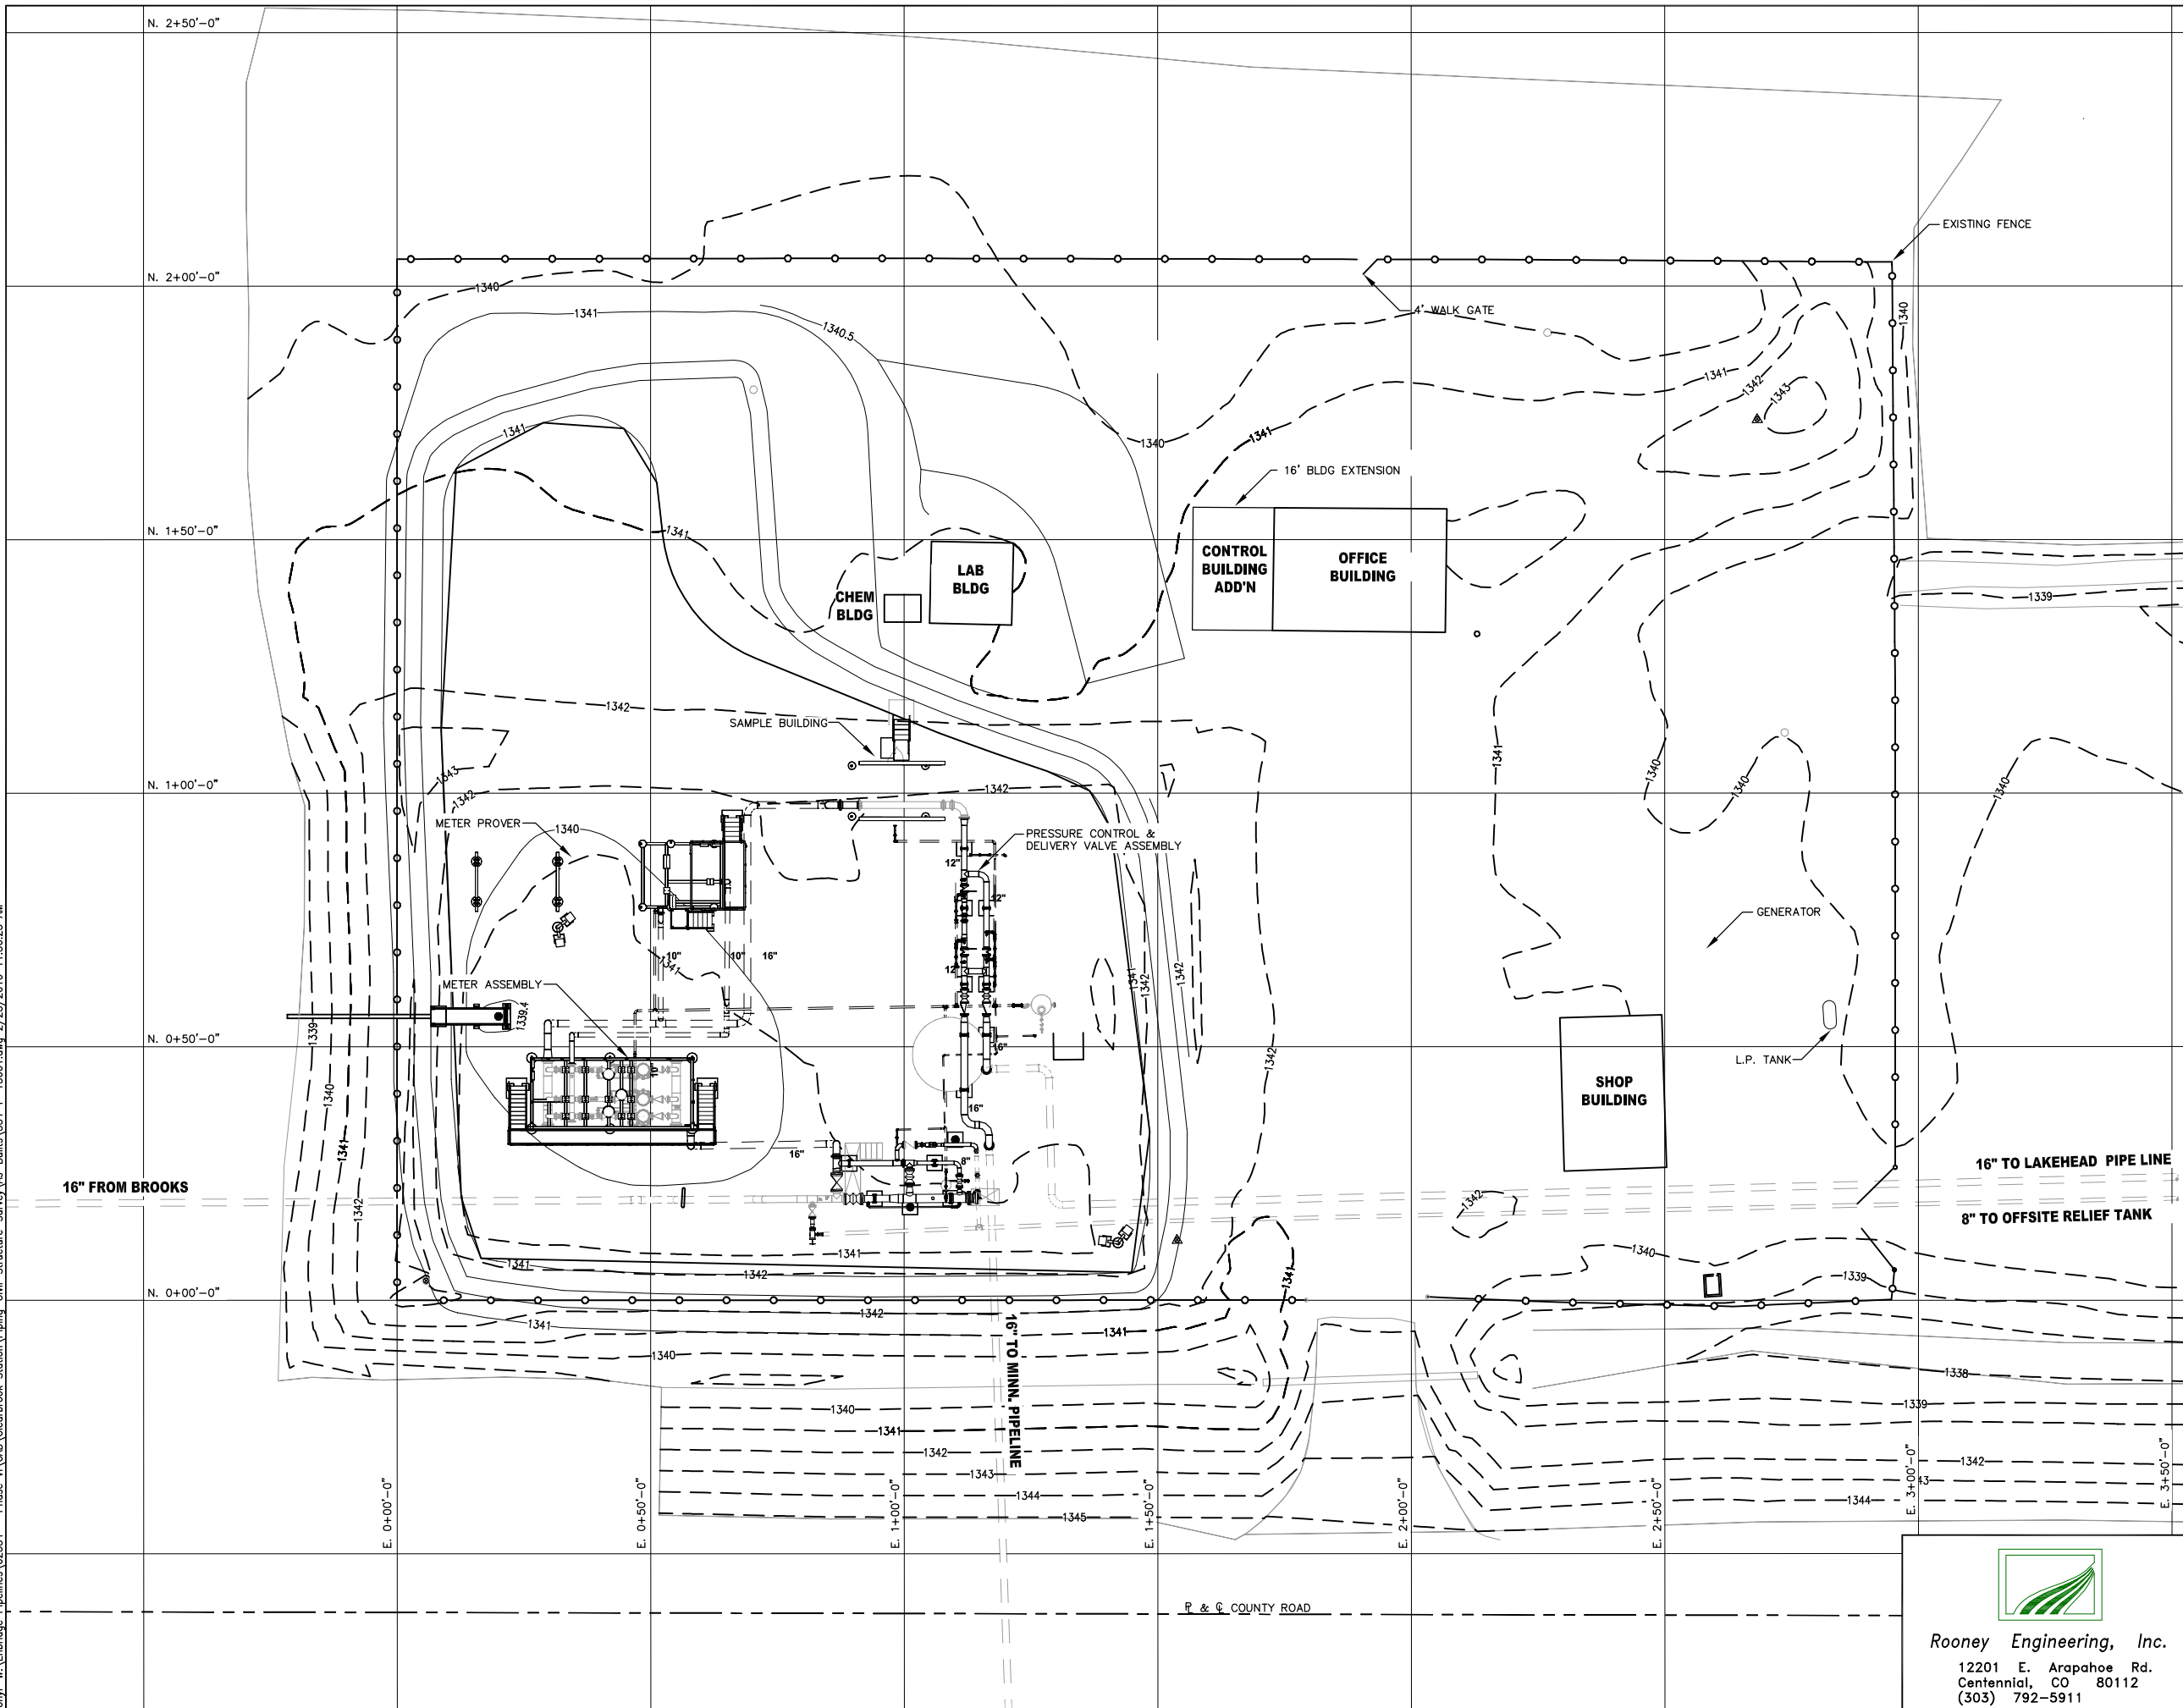


16" FROM BROOKS

16" TO LAKEHEAD PIPE LINE
8" TO OFFSITE RELIEF TANK

16" TO MINN. PIPELINE

R & Q COUNTY ROAD

1	AS-BUILTS	3/15/10	ALF
NO	REVISION	DATE	APPR BY


ENBRIDGE PIPELINES (NORTH DAKOTA) LLC
CLEARBROOK (MN) STATION
 NDSE 6 PLOT PLAN


Rooney Engineering, Inc.
 12201 E. Arapahoe Rd.
 Centennial, CO 80112
 (303) 792-5911

PROJECT: ENBRIDGE - 2534-15		
SCALE: 1/16"=1'-0"	DATE: 2/5/08	DRAWN: ALF
CHECK: GR	APPR: TAK	DATE: 6/5/09
DWG. NO. 534-P-15001		