



ROONEY ENGINEERING, INC

12201 East Arapahoe Road, C-10, Centennial, CO 80112
(303) 792-5911

RECEIVED

MAR 23 2011

DOCUMENT TRANSMITTAL SHEET PUBLIC SERVICE COMMISSION

PROJECT NAME: Phase 6 Expansion – Alexander Station & Stanley Tank

TRANSMITTAL DATE: March 22, 2011

TRANSMITTAL NUMBER: 2534-032111-01 – As-Built for Orders PU-07-791 and Alexander Station PU-10-33

TRANSMITTAL TO: **ATTN: Patrick Fahn**
Director - Compliance and Competitive Markets
North Dakota Public Service Commission
600 E. Boulevard
Bismarck, ND 58505-0480

CC: **Enbridge Pipeline (ND) LLC:** Brent Horton (w/CD), Sally Joyce, (w/CD), Trent Mattick, Steve Schmaltz, Tony Kueffler, Gary Blowers, Claudia Schrull

Rooney Engineering Inc.: Troy Pierantoni (w/CD), Ty France, Ed Kelly, Scott Frank, Eric Stahl

PHONE NUMBER: 701-328-4077



TRANSMITTED VIA: FedEx


TRANSMITTAL FROM: Jill Sanchez

Enclosed are: CD COPIES OF ALEXANDER STATION AS-BUILTS FOR ORDERS PU-07-791 AND PU-10-33. (PDF and CAD format)

Hard Copy:

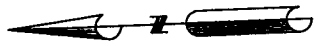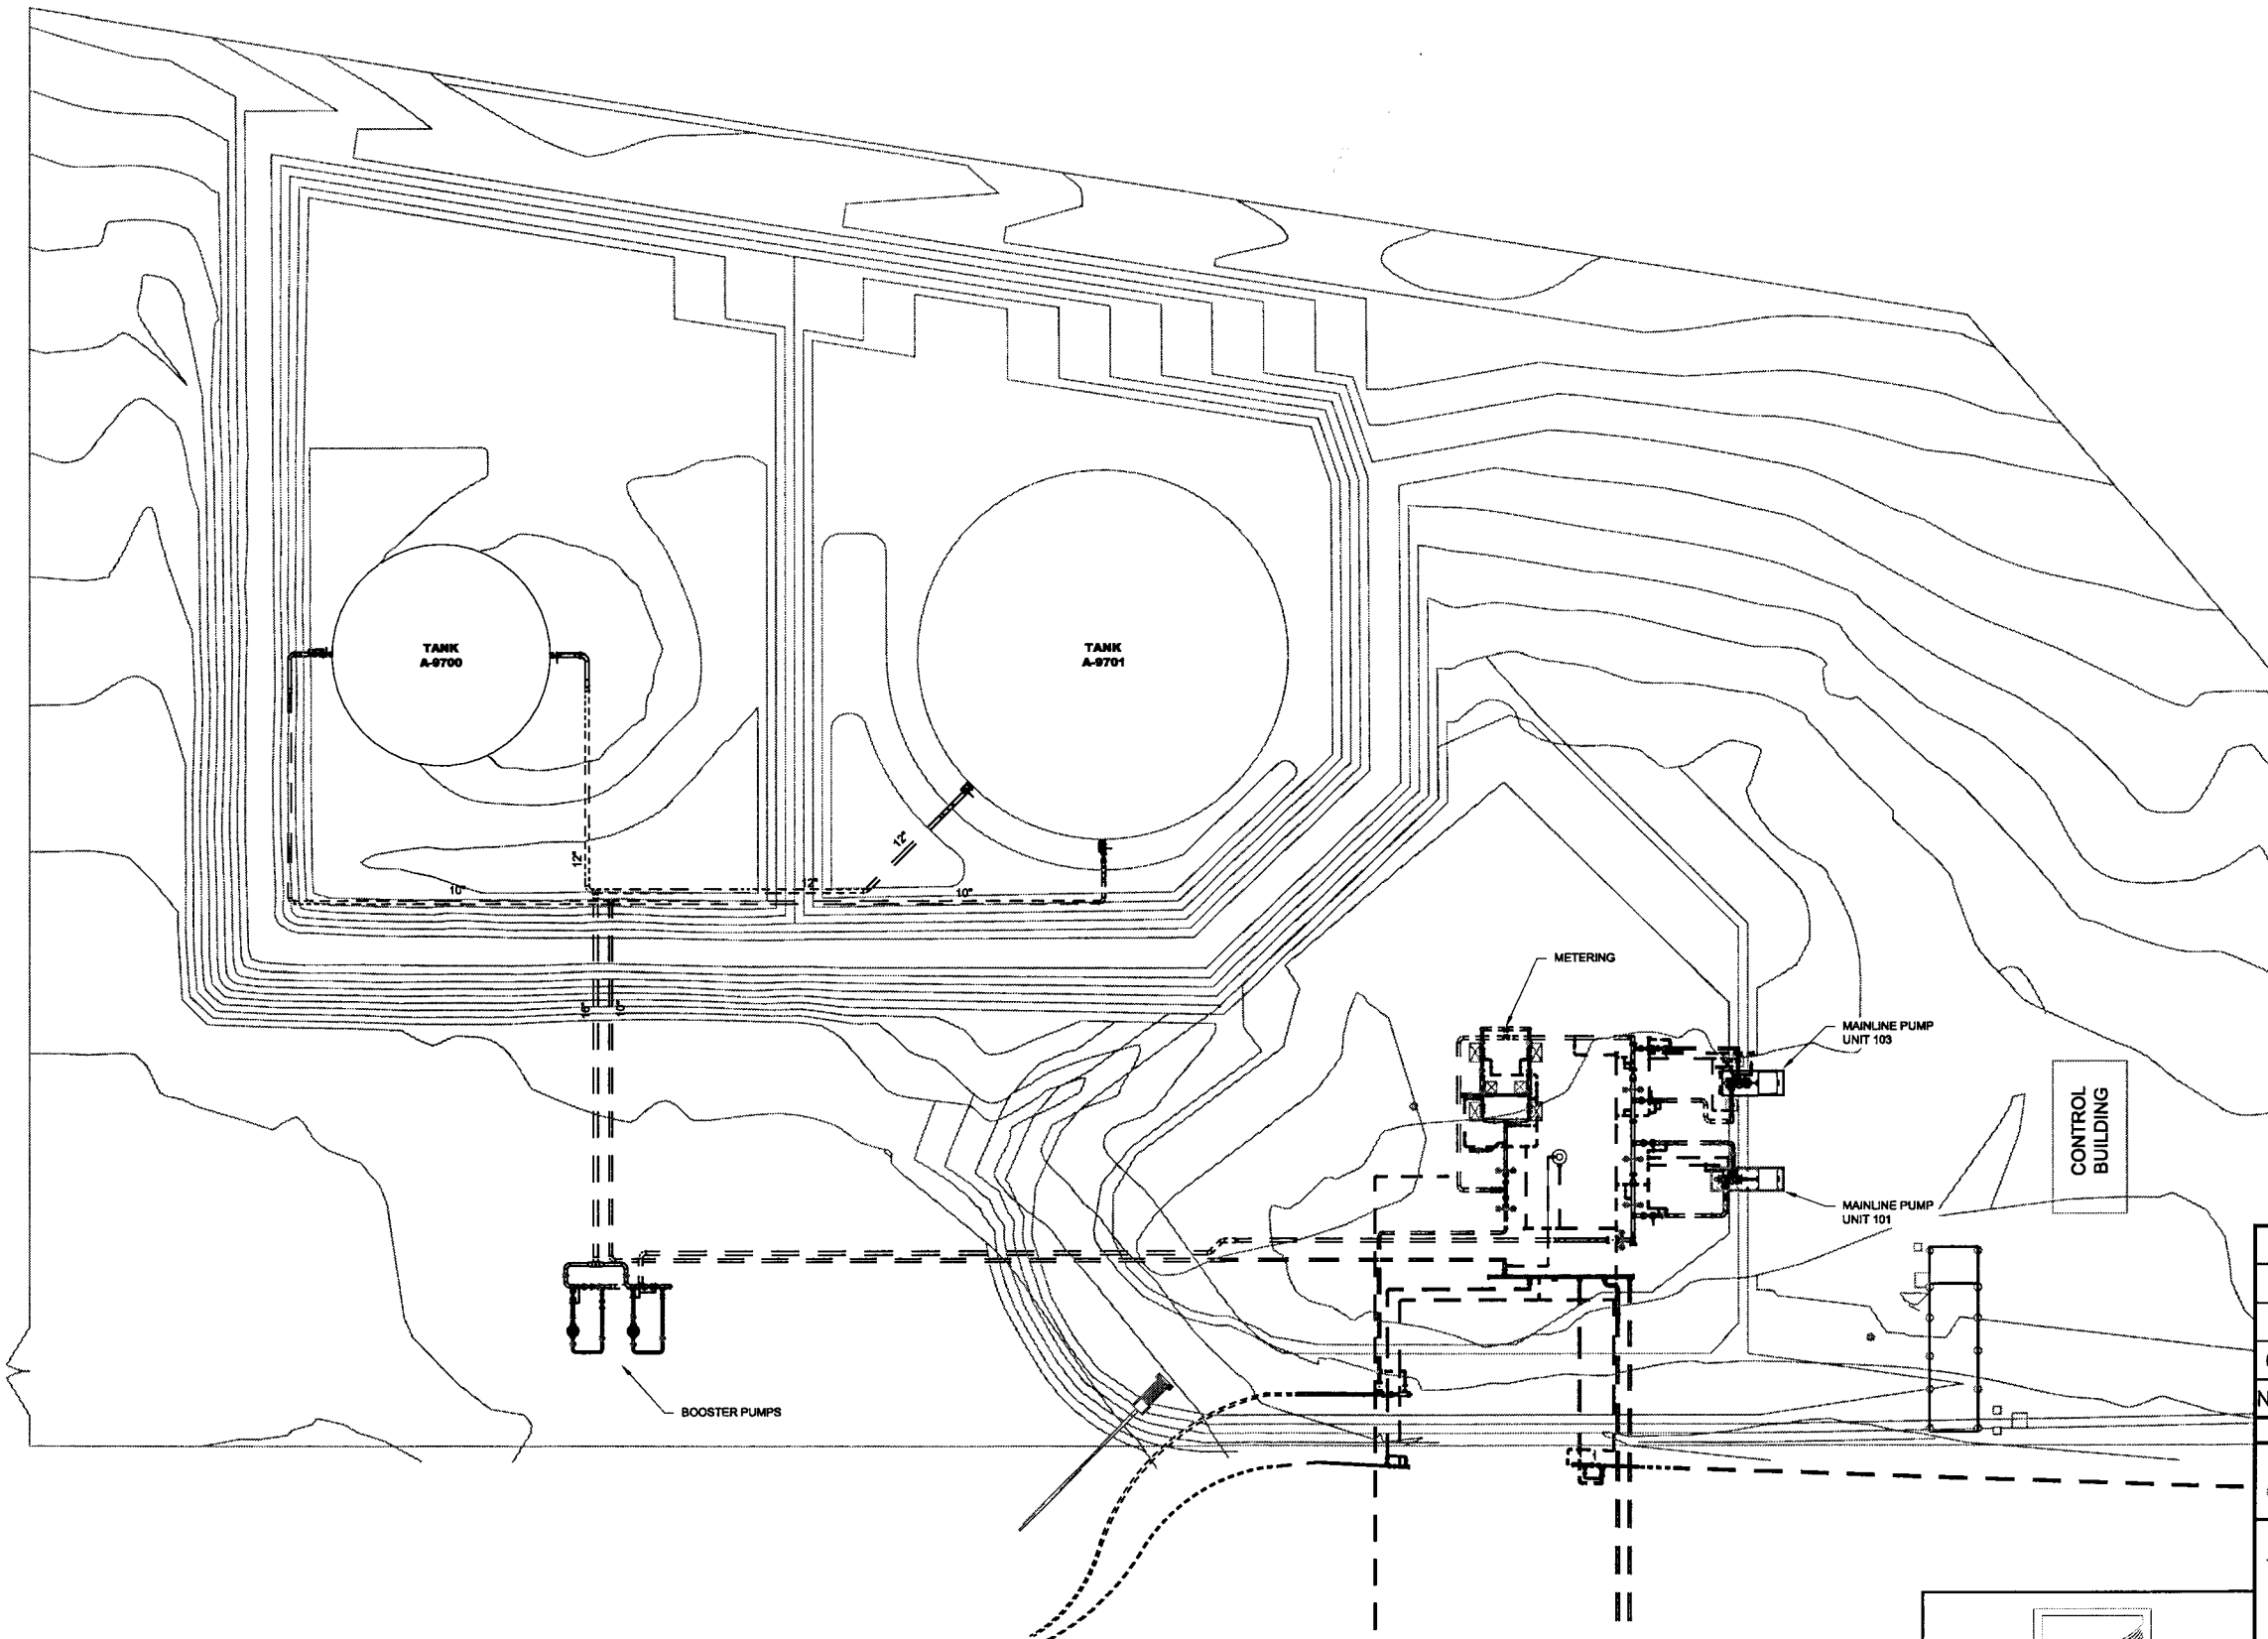534-P-01000 – Alexander Station ND PSC Submittal Plot Plan Rev. 1 (2-24-11)
609-P-05001 – Stanley Station ND PSC Submittal Plot Plan Rev. 1 (2-24-11)





Rooney Engineering, Inc.
 12201 E. Arapahoe Rd.
 Centennial, CO 80112
 (303) 792-5911

NO	REVISION	DATE	APPR	BY
1	ISSUED FOR AS-BUILT	2/24/11	SHF	MV
0	ISSUED FOR CONSTRUCTION	8/10/10	SHF	ADJ

ENBRIDGE PIPELINES (NORTH DAKOTA) LLC
ALEXANDER (ND) STATION
 ND PSC SUMITTAL
 PLOT PLAN

PROJECT:	SCALE: 3/32"=1'-0"	DATE: 4/28/08	DRAWN: ADJ
CHECK:	APPR:	DATE:	

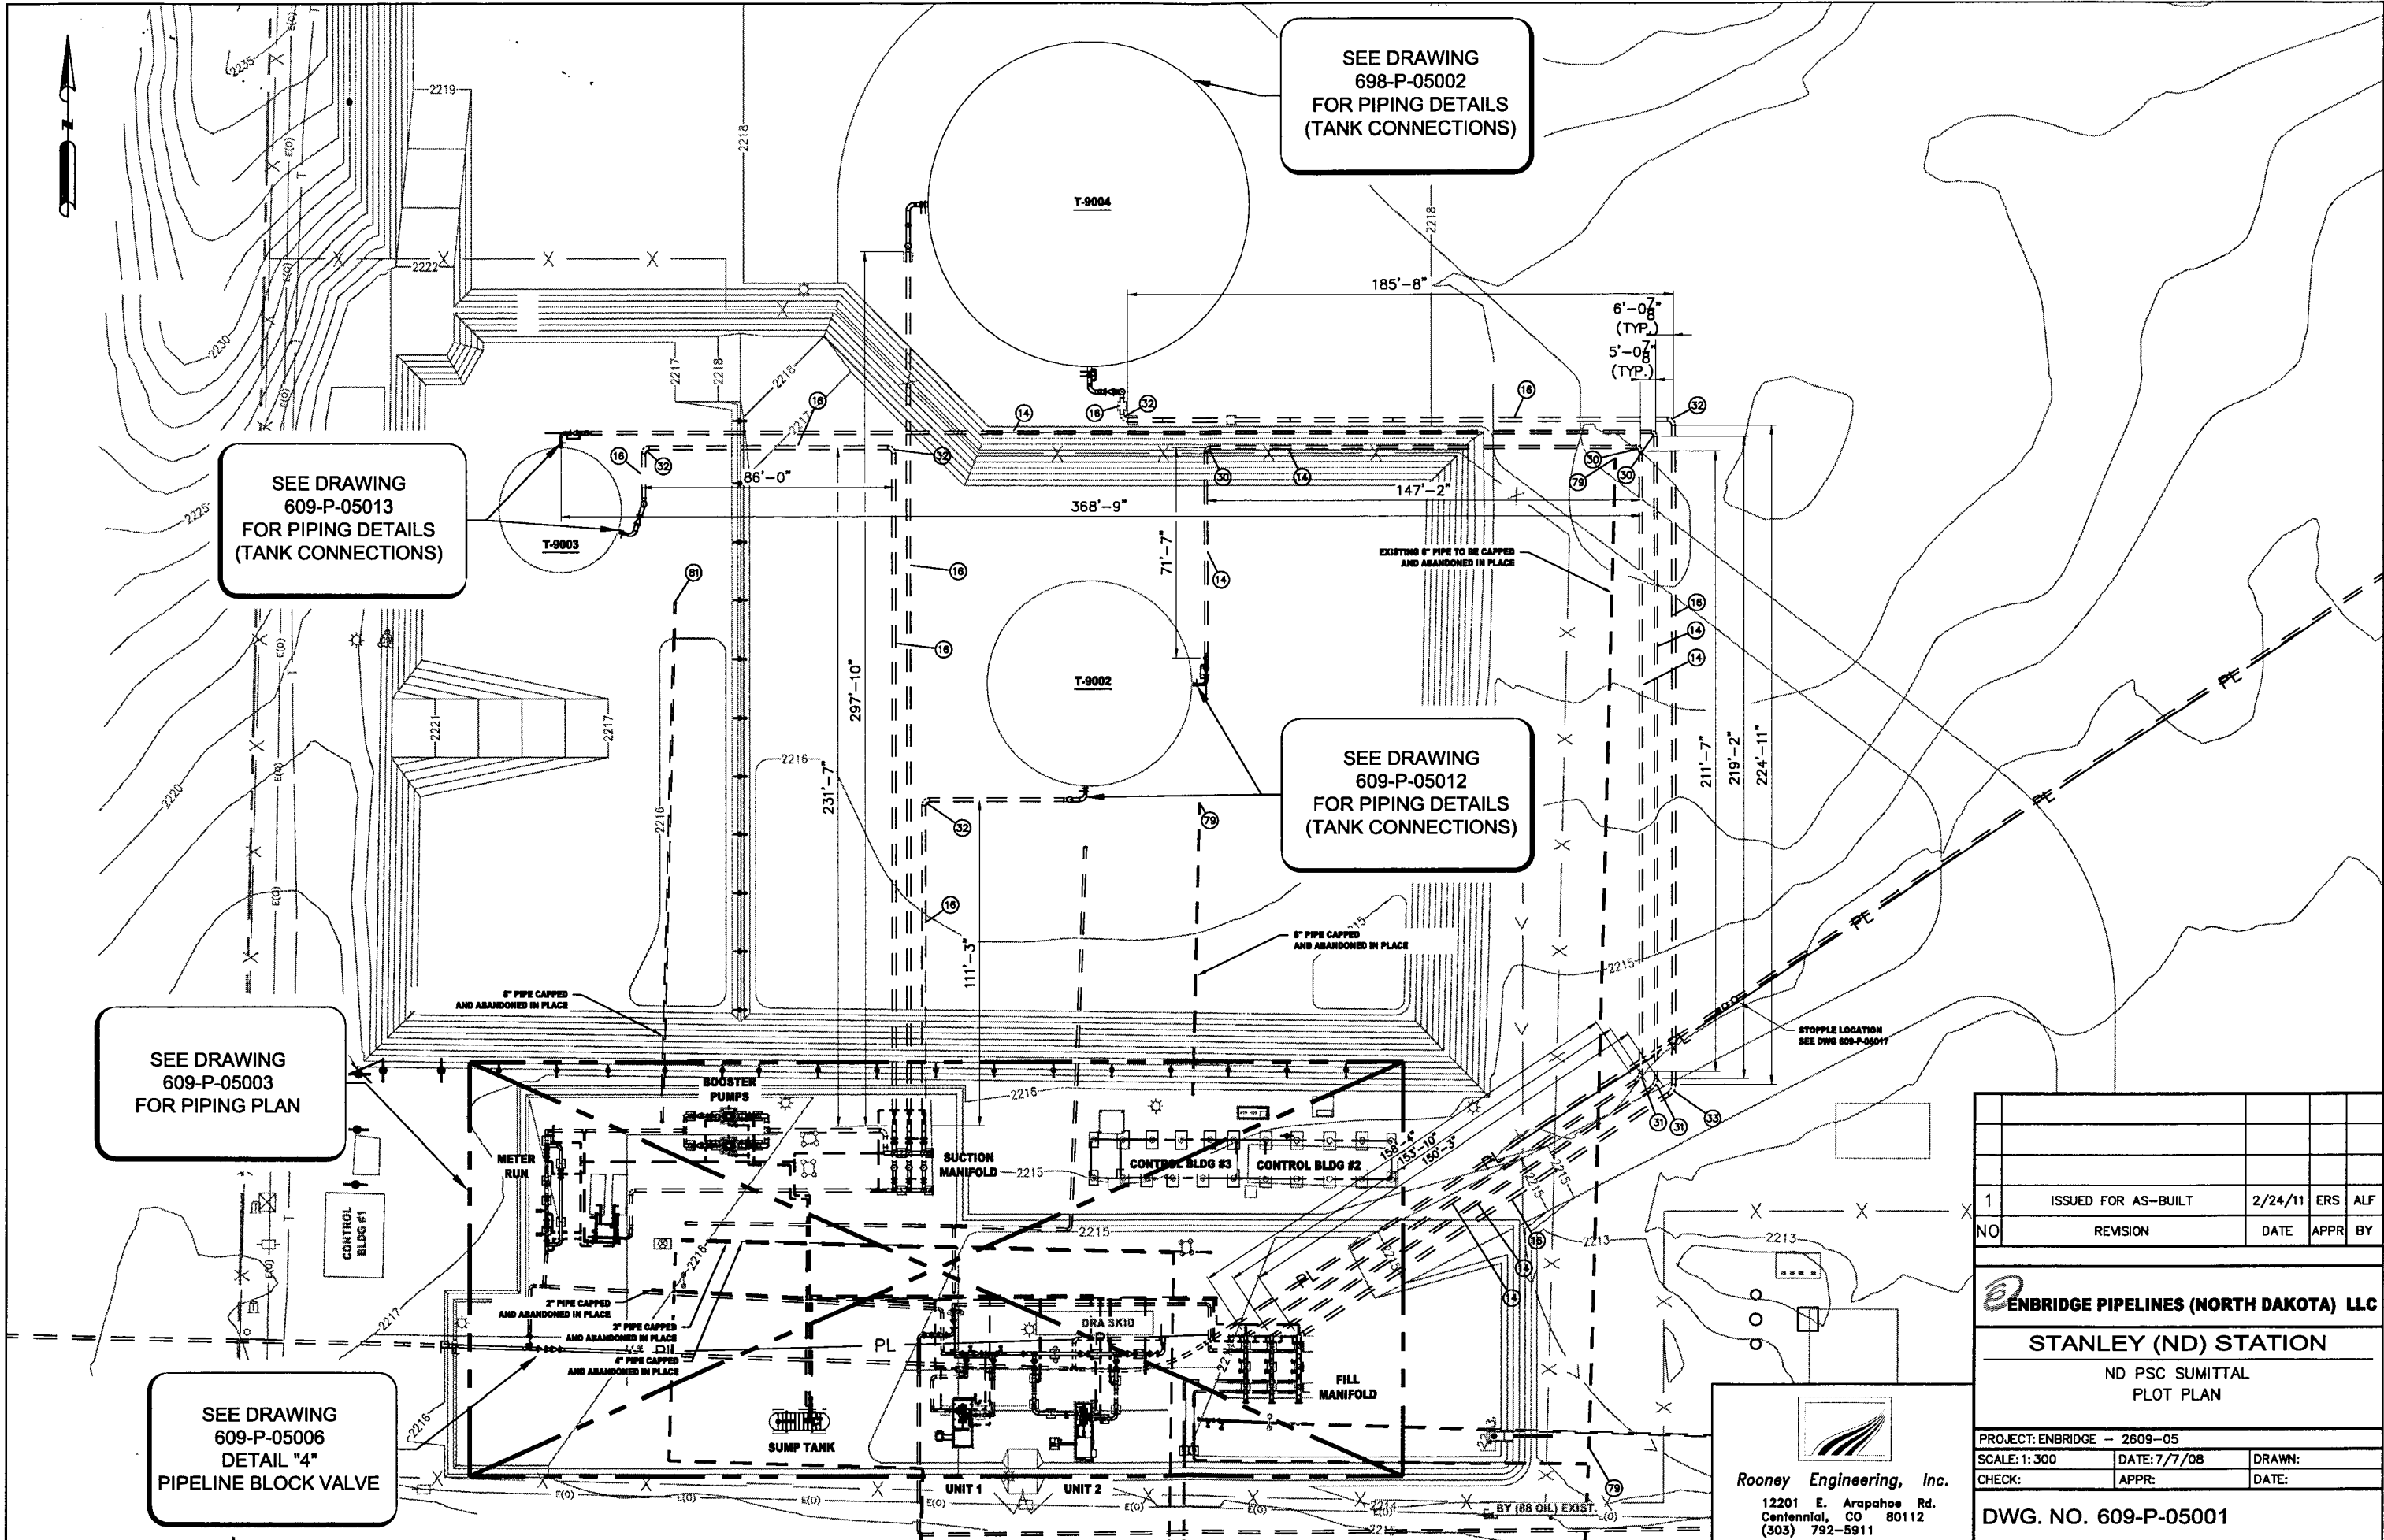DWG. NO. 534-P-01000



1	ISSUED FOR AS-BUILT	2/24/11	ERS	ALF
NO	REVISION	DATE	APPR	BY

ENBRIDGE PIPELINES (NORTH DAKOTA) LLC
STANLEY (ND) STATION
 ND PSC SUMMITAL
 PLOT PLAN

PROJECT: ENBRIDGE - 2609-05	SCALE: 1:300	DATE: 7/7/08	DRAWN:
CHECK:	APPR:	DATE:	

DWG. NO. 609-P-05001

Rooney Engineering, Inc.
 12201 E. Arapahoe Rd.
 Centennial, CO 80112
 (303) 792-5911