



Westwood

Westwood Professional Services, Inc.
7699 Anagram Drive
Eden Prairie, MN 55344

PHONE 952-937-5150
FAX 952-937-5822
TOLL FREE 1-888-937-5150
www.westwoodps.com

Crew: _____ JAG

Checked: _____ CWM

Drawn: _____ SRB

Record Drawing by/date: _____

Revisions:

Prepared for:

Ashtabula Wind II, LLC


Ashtabula II Wind Farm Project

ASBUILT ALTA/ACSM Land Title Survey Steele and Griggs County, North Dakota

GENERAL DRAWINGS

<u>DWG. NO.</u>	<u>TITLE</u>
SHEET 2	PROJECT SITE LAYOUT, INDEX SHEET AND GENERAL NOTES
SHEETS 3 – 20	SECTIONAL DETAIL SHEETS, RELEVANT TITLE COMMITMENTS AND SCHEDULE B II EXCEPTIONS

Vicinity Map

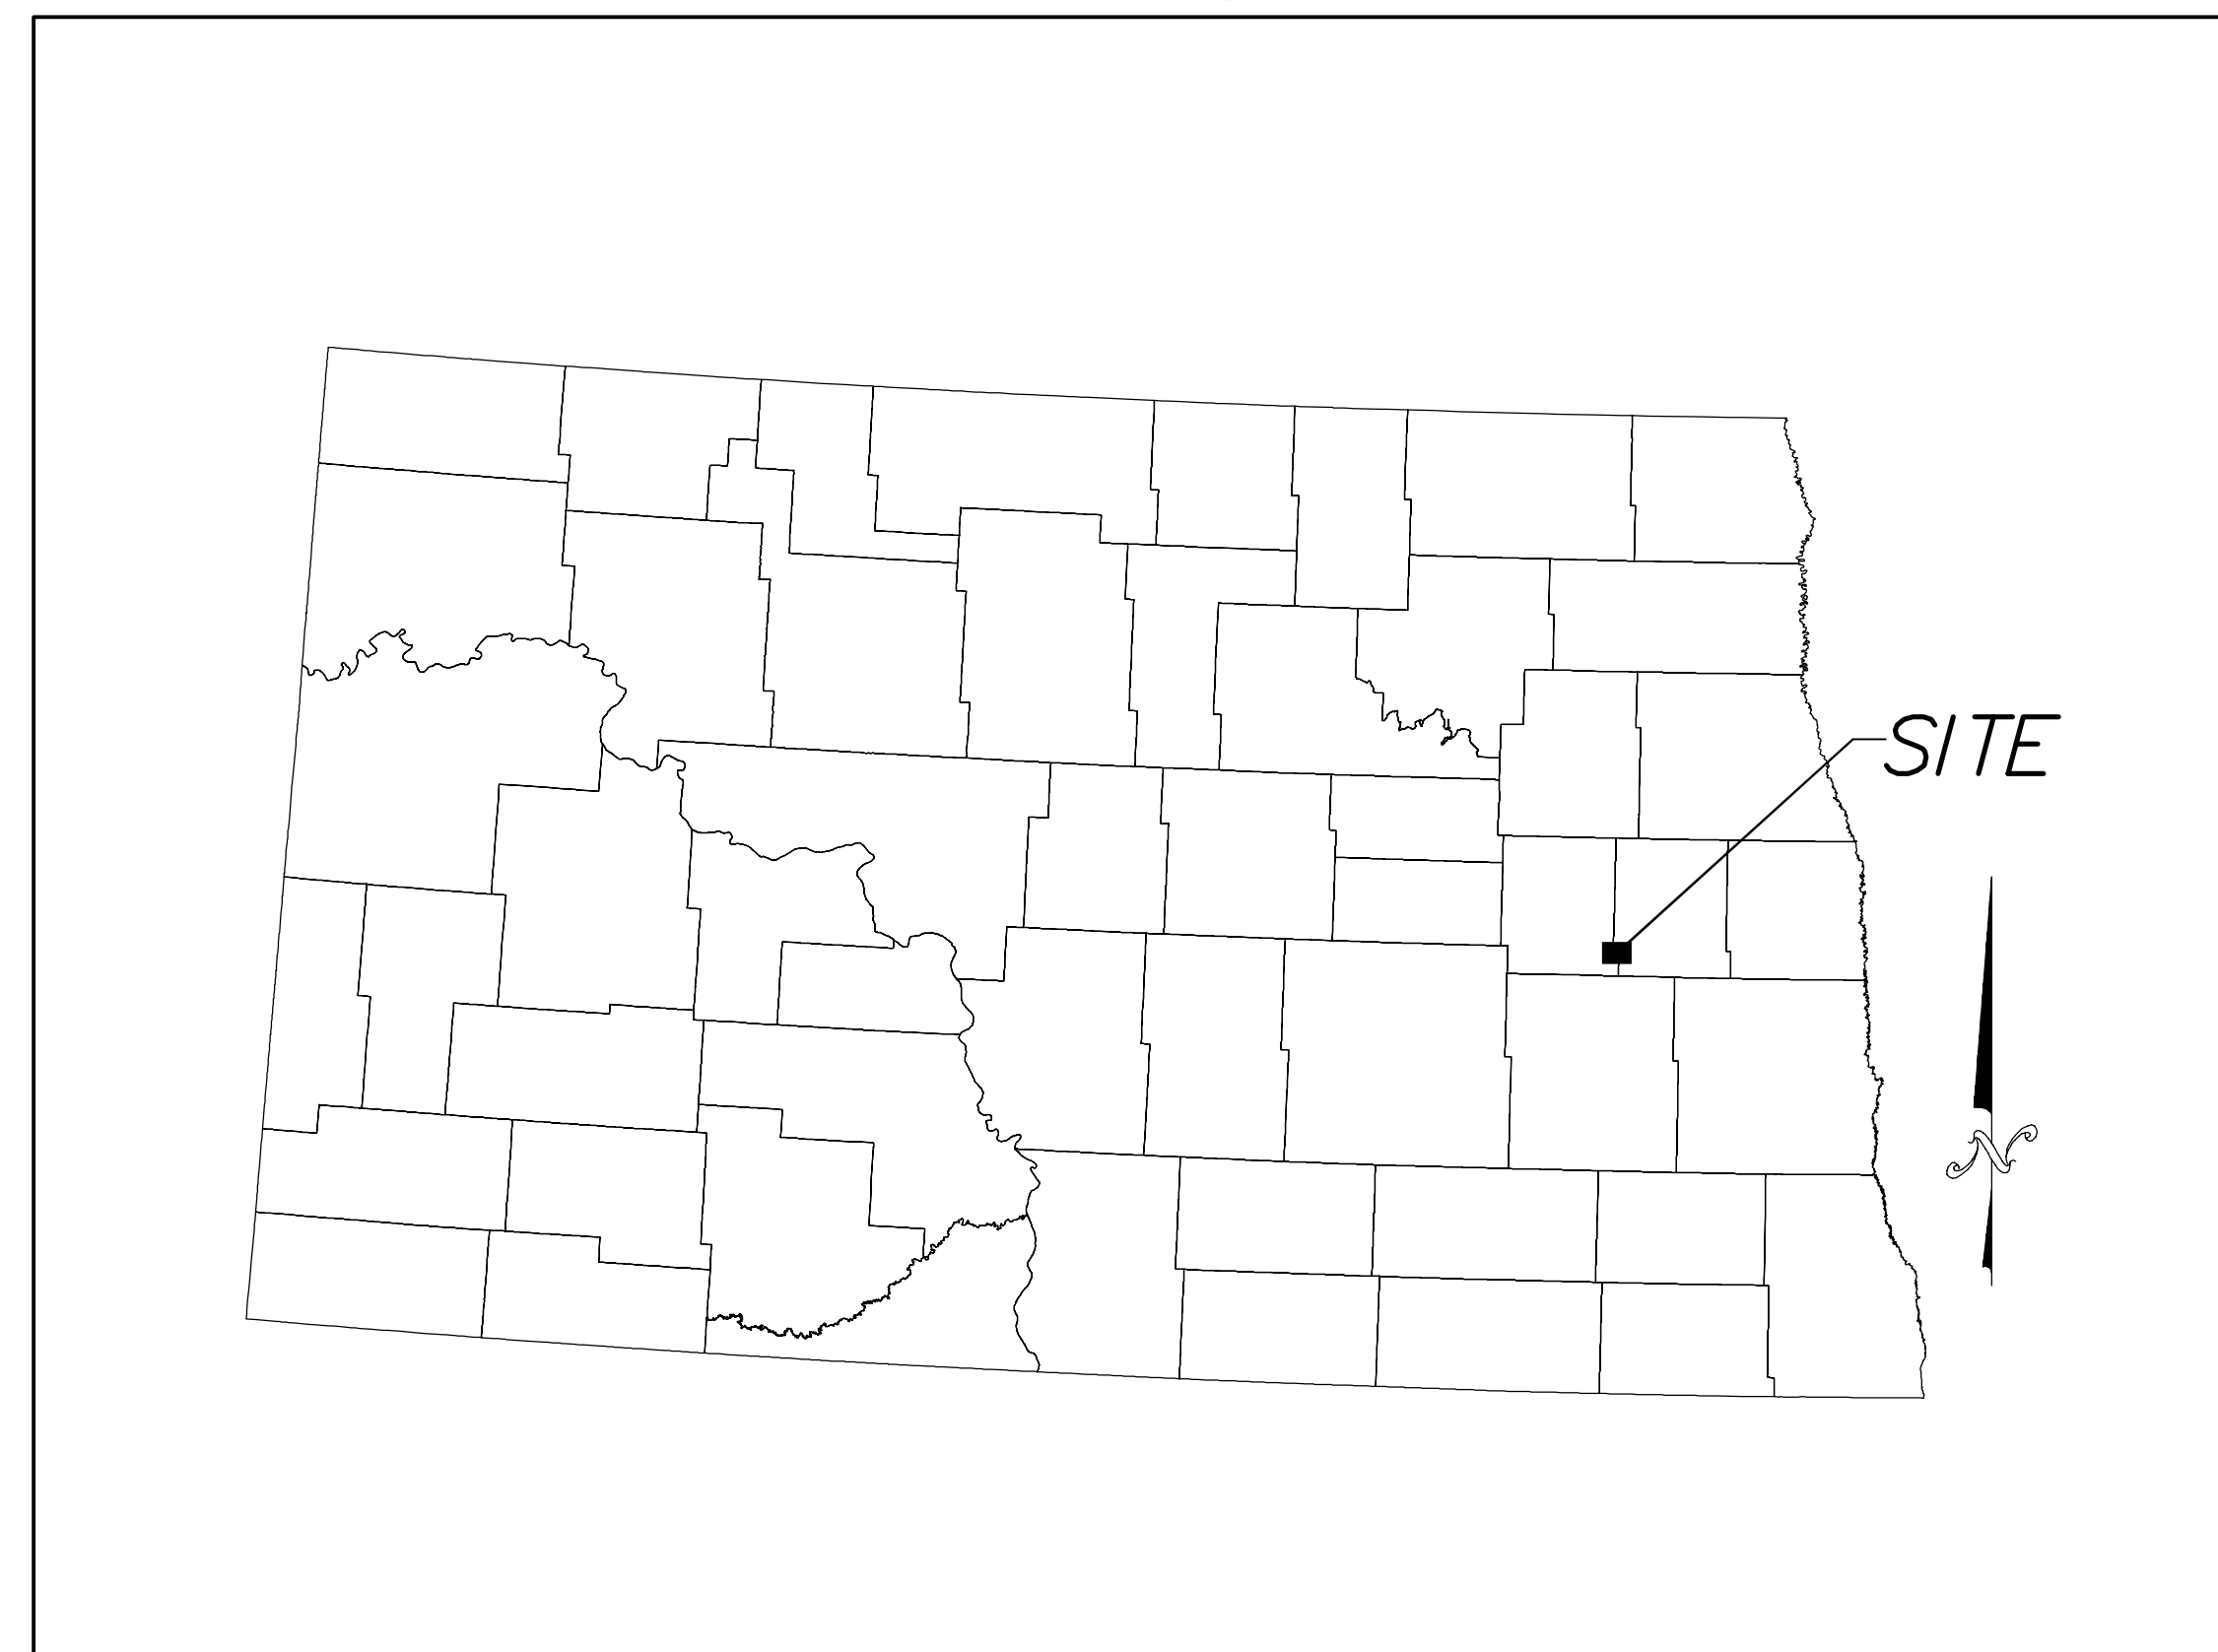

(Not to Scale)

**Ashtabula II
Wind Farm**

Luverne, North Dakota

**AS-BUILT
ALTA/ACSM Land
Title Survey**

Date: February 18, 2010

Sheet: 1 of 20