

Hamre, John G.

From: Lein, Jerry R.
Sent: Wednesday, July 30, 2008 1:07 PM
To: TLangston@otpc.com
Cc: -Grp-PSC Commissioners; -Grp-PSC Public Utilities; -Grp-PSC Legal
Subject: Pole Moves - Case No. PU-08-48
Attachments: 07-25-08 4-141-51.pdf

Todd:

During administrative discussions this morning the Commission authorized staff approval of the attached structure location changes. Please consider this e-mail to be that approval.

Jerry Lein
701 328-1035

From: Lein, Jerry R.
Sent: Wednesday, July 30, 2008 9:23 AM
To: -Grp-PSC Commissioners; -Grp-PSC Public Utilities; -Grp-PSC Legal
Subject: FW: Pole Moves

Esther – Please add to admin under discussion:
Case No. PU-08-48, Minnkota 230 kV Structure Location Changes – J. Lein

Minnkota is requesting two small structure location changes to accommodate landowner requests in the SE ¼ of Section 4, T 141 N, R 51 W, Rush River Township. The landowner requested Structure 369 be moved 40 feet south along the existing alignment, which would also require structure 368 to shift 11 feet south along the alignment as shown in the attached drawings. I recommend the Commission authorize Staff to approve the changes. Thanks.

From: TLangston@otpc.com [mailto:TLangston@otpc.com]
Sent: Monday, July 28, 2008 7:15 AM
To: Lein, Jerry R.
Cc: akoeckeritz@otpc.com
Subject: RE: Pole Moves

Jerry,

Attached is the drawing reflecting the proposed pole move you had requested.

I will contact you later once you have had a chance to review.

Todd

-----Original Message-----

From: Lein, Jerry

94 **PU-08-48** Filed: 7/30/2008 Pages: 3
Structure Relocation Changes and Commission Approval of Structure Location Changes

Public Service Commission

Sent: Friday, July 25, 2008 1:38 PM

To: Langston, Todd

Subject: RE: Pole Moves

Todd - Can you provide a map showing the proposed changes and let me know when you need to know by?

From: TLangston@otpc.com [mailto:TLangston@otpc.com]

Sent: Fri 7/25/2008 1:25 PM

To: Lein, Jerry R.

Cc: akoeckeritz@otpc.com

Subject: Pole Moves

Jerry,

Bill and Ken Heil owners of Section 4 Rush River Township requested that pole # 368 be moved 10' South and pole # 369 be moved 40' South to help in their farming practices. The engineering or construction would not be a problem.


Bill or Ken would participate in a conference call on Monday with us to confirm their wishes.

Thanks,

Todd

SCALE: Section 1" = 500'

SHEET NO. _____ OF _____

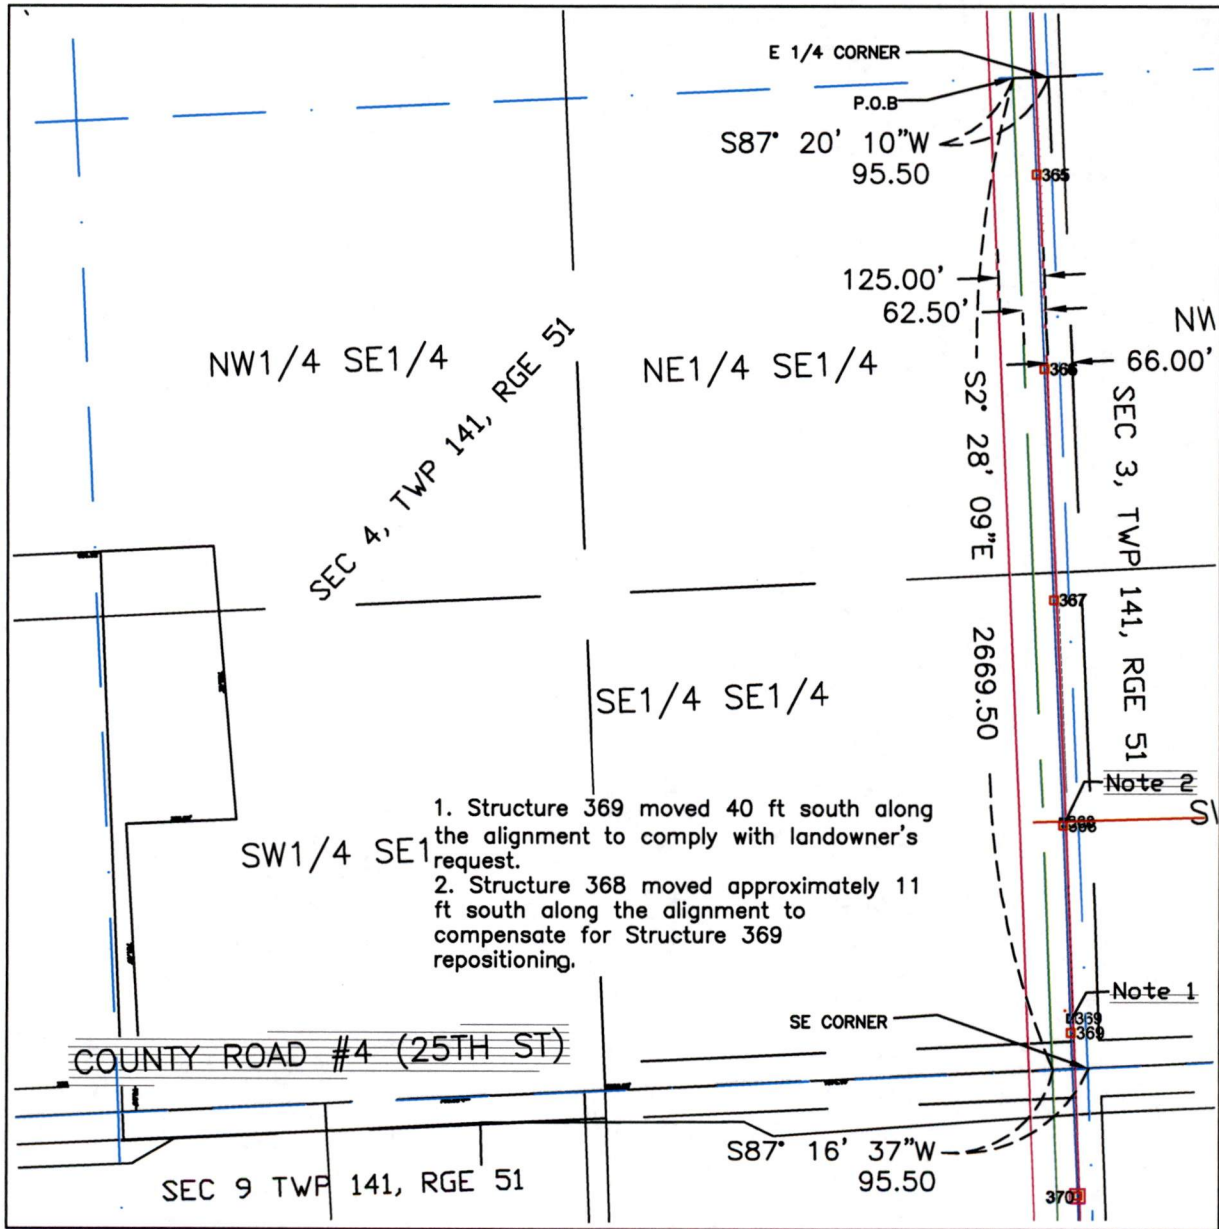

1. Structure 369 moved 40 ft south along the alignment to comply with landowner's request.
2. Structure 368 moved approximately 11 ft south along the alignment to compensate for Structure 369 repositioning.

DESCRIPTION SE 1/4 SEC. 4 TWP. 141N R. 51W
 COUNTY CASS STATE NORTH DAKOTA
 OWNER WILLIAM A & KEN HEJL ADDRESS 15560 28TH ST SE AMENIA
 TRANSMISSION FACILITY: PILLSBURY-FARGO 230 KV GENERATION OUTLET
 W. O. NO. _____ DATE _____ SIGNED _____

DWG. NO. _____
 PROJECT: PILLSBURY-FARGO GENERATION OUTLET