


# Turbines, Access Road & Collection Lines

EXHIBIT  
tabbies  
15

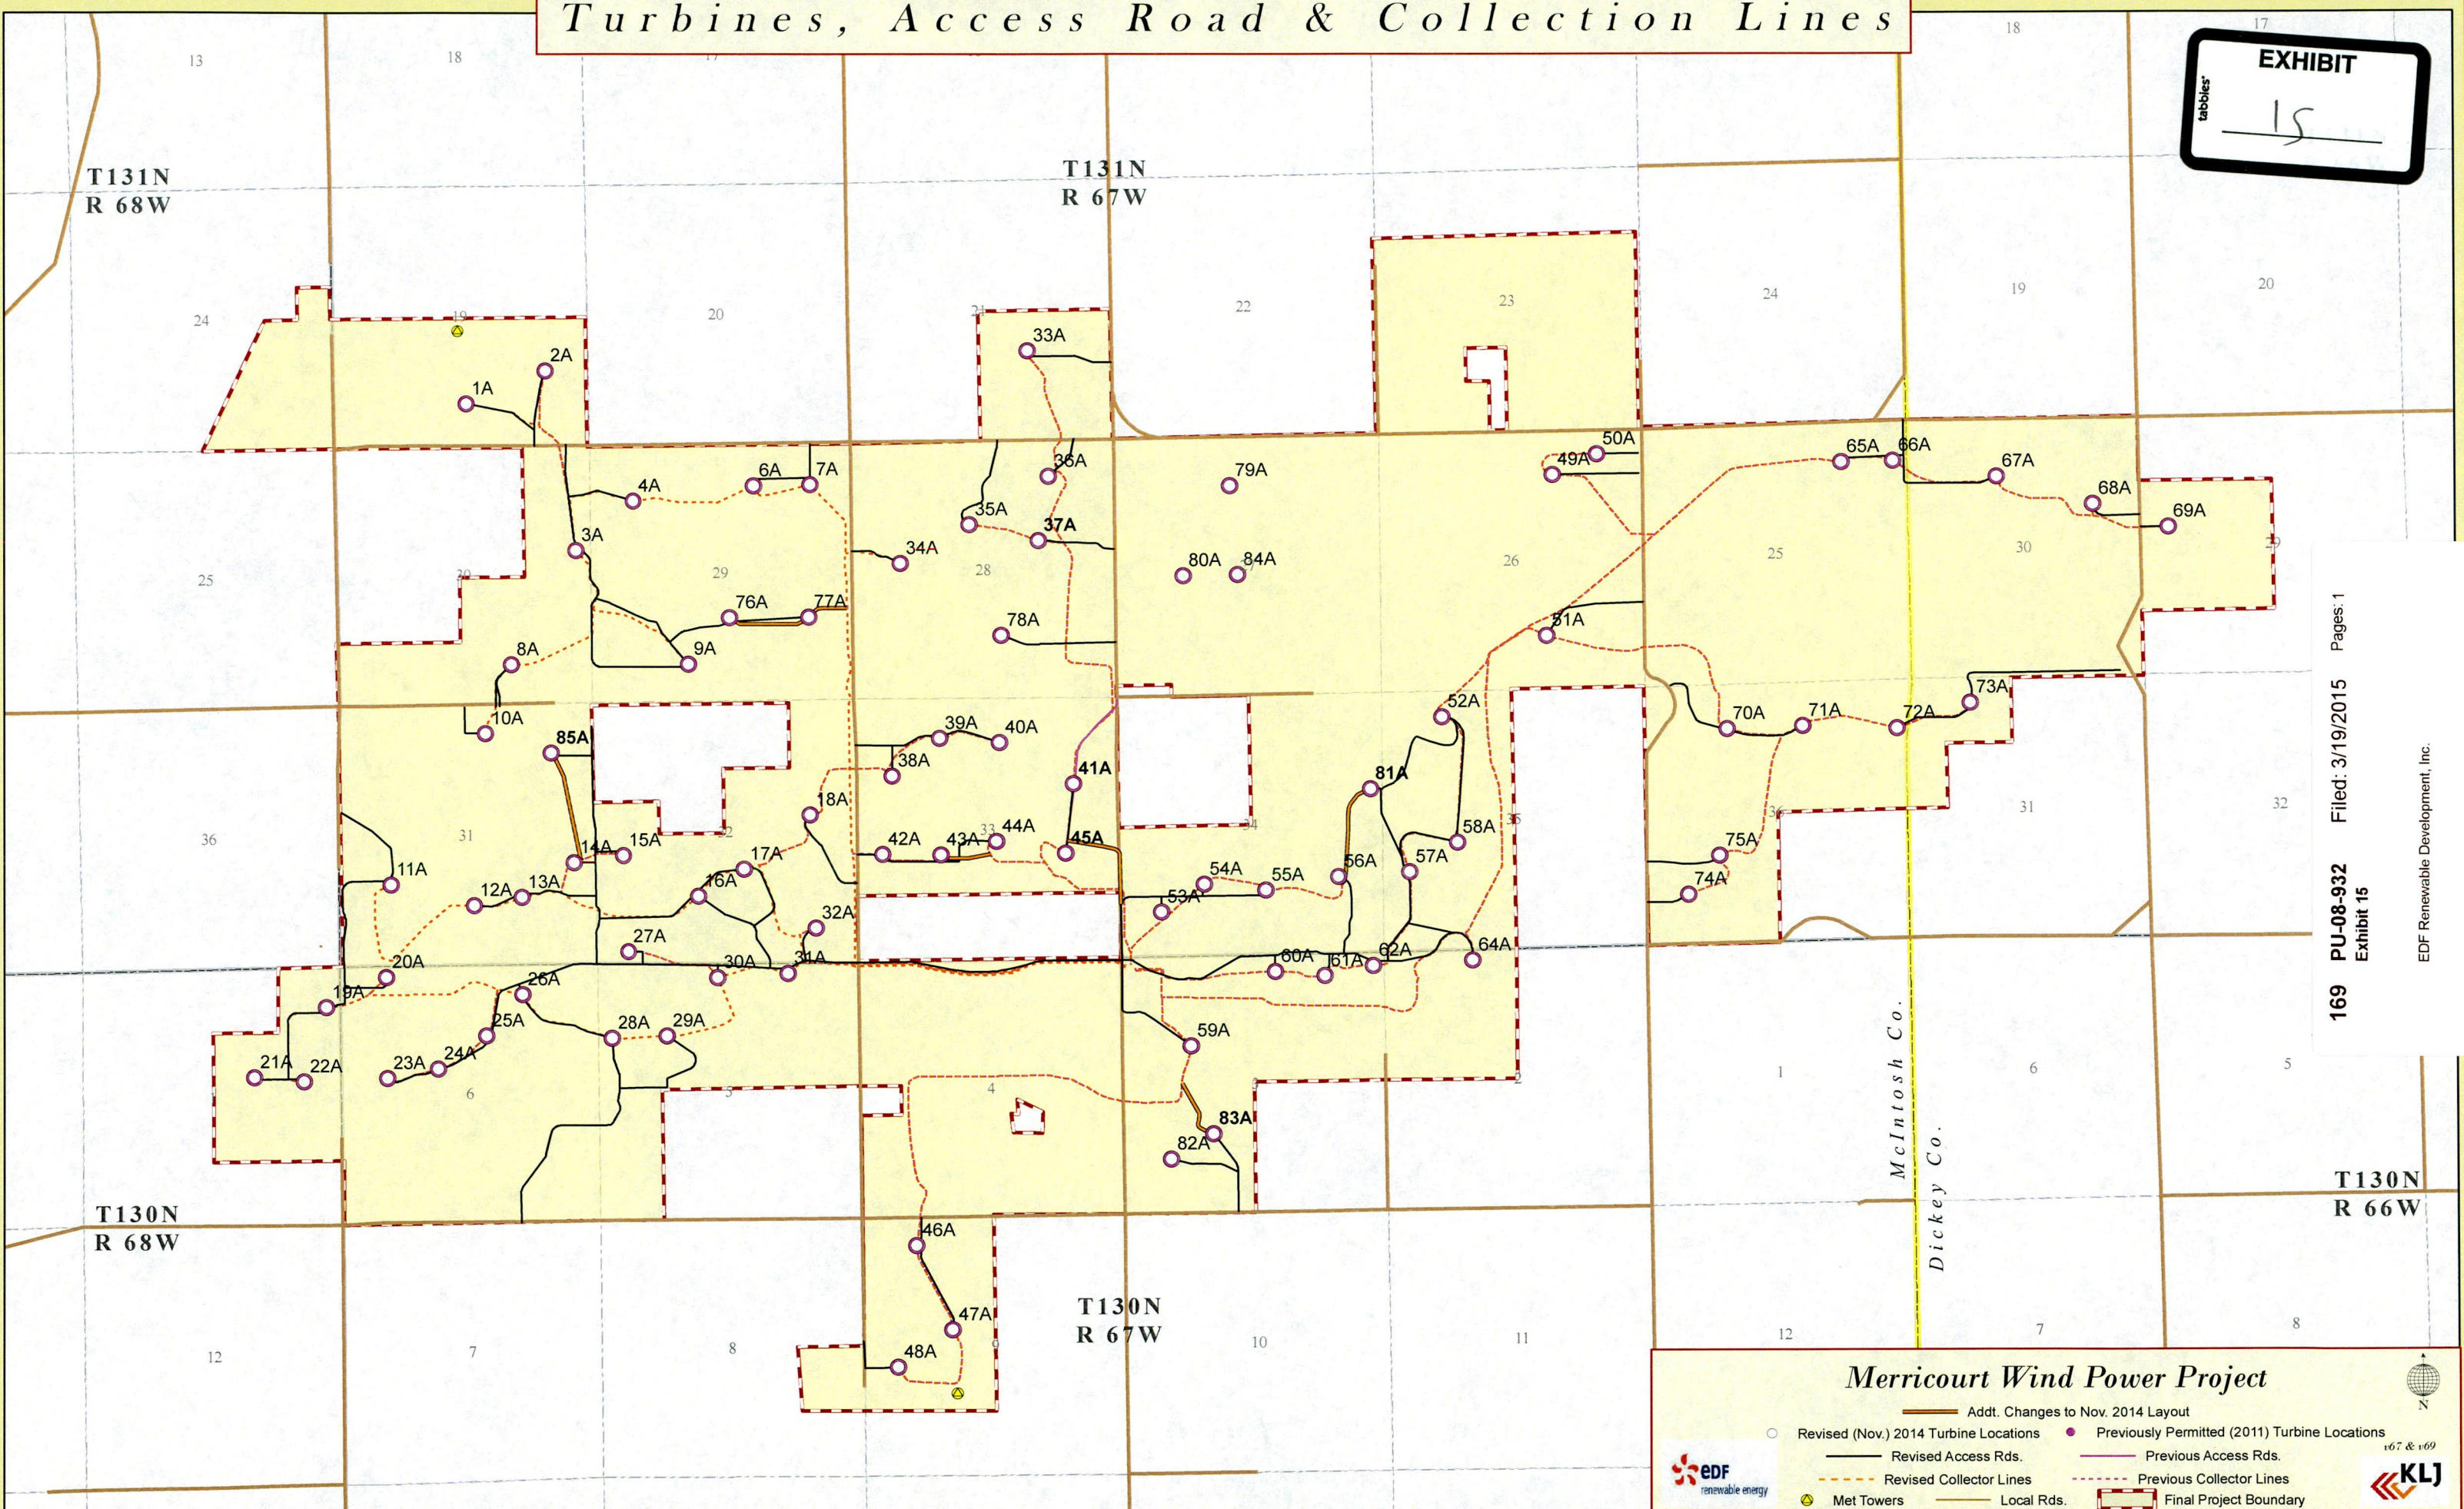

169 PU-08-932 Filed: 3/19/2015 Pages: 1  
Exhibit 15

EDF Renewable Development, Inc.

**Merricourt Wind Power Project**

— Addt. Changes to Nov. 2014 Layout

- Revised (Nov.) 2014 Turbine Locations
- Previously Permitted (2011) Turbine Locations
- Revised Access Rds.
- Previous Access Rds.
- - - Revised Collector Lines
- - - Previous Collector Lines
- ⊙ Met Towers
- Local Rds.
- - - Final Project Boundary

edf renewable energy

KLJ

v67 & v69