




Path: P:\SWCA\BakkenNorth\Post Const. Filing\MXDs\FSC\_PostConst\_Filing\_Alignment.mxd

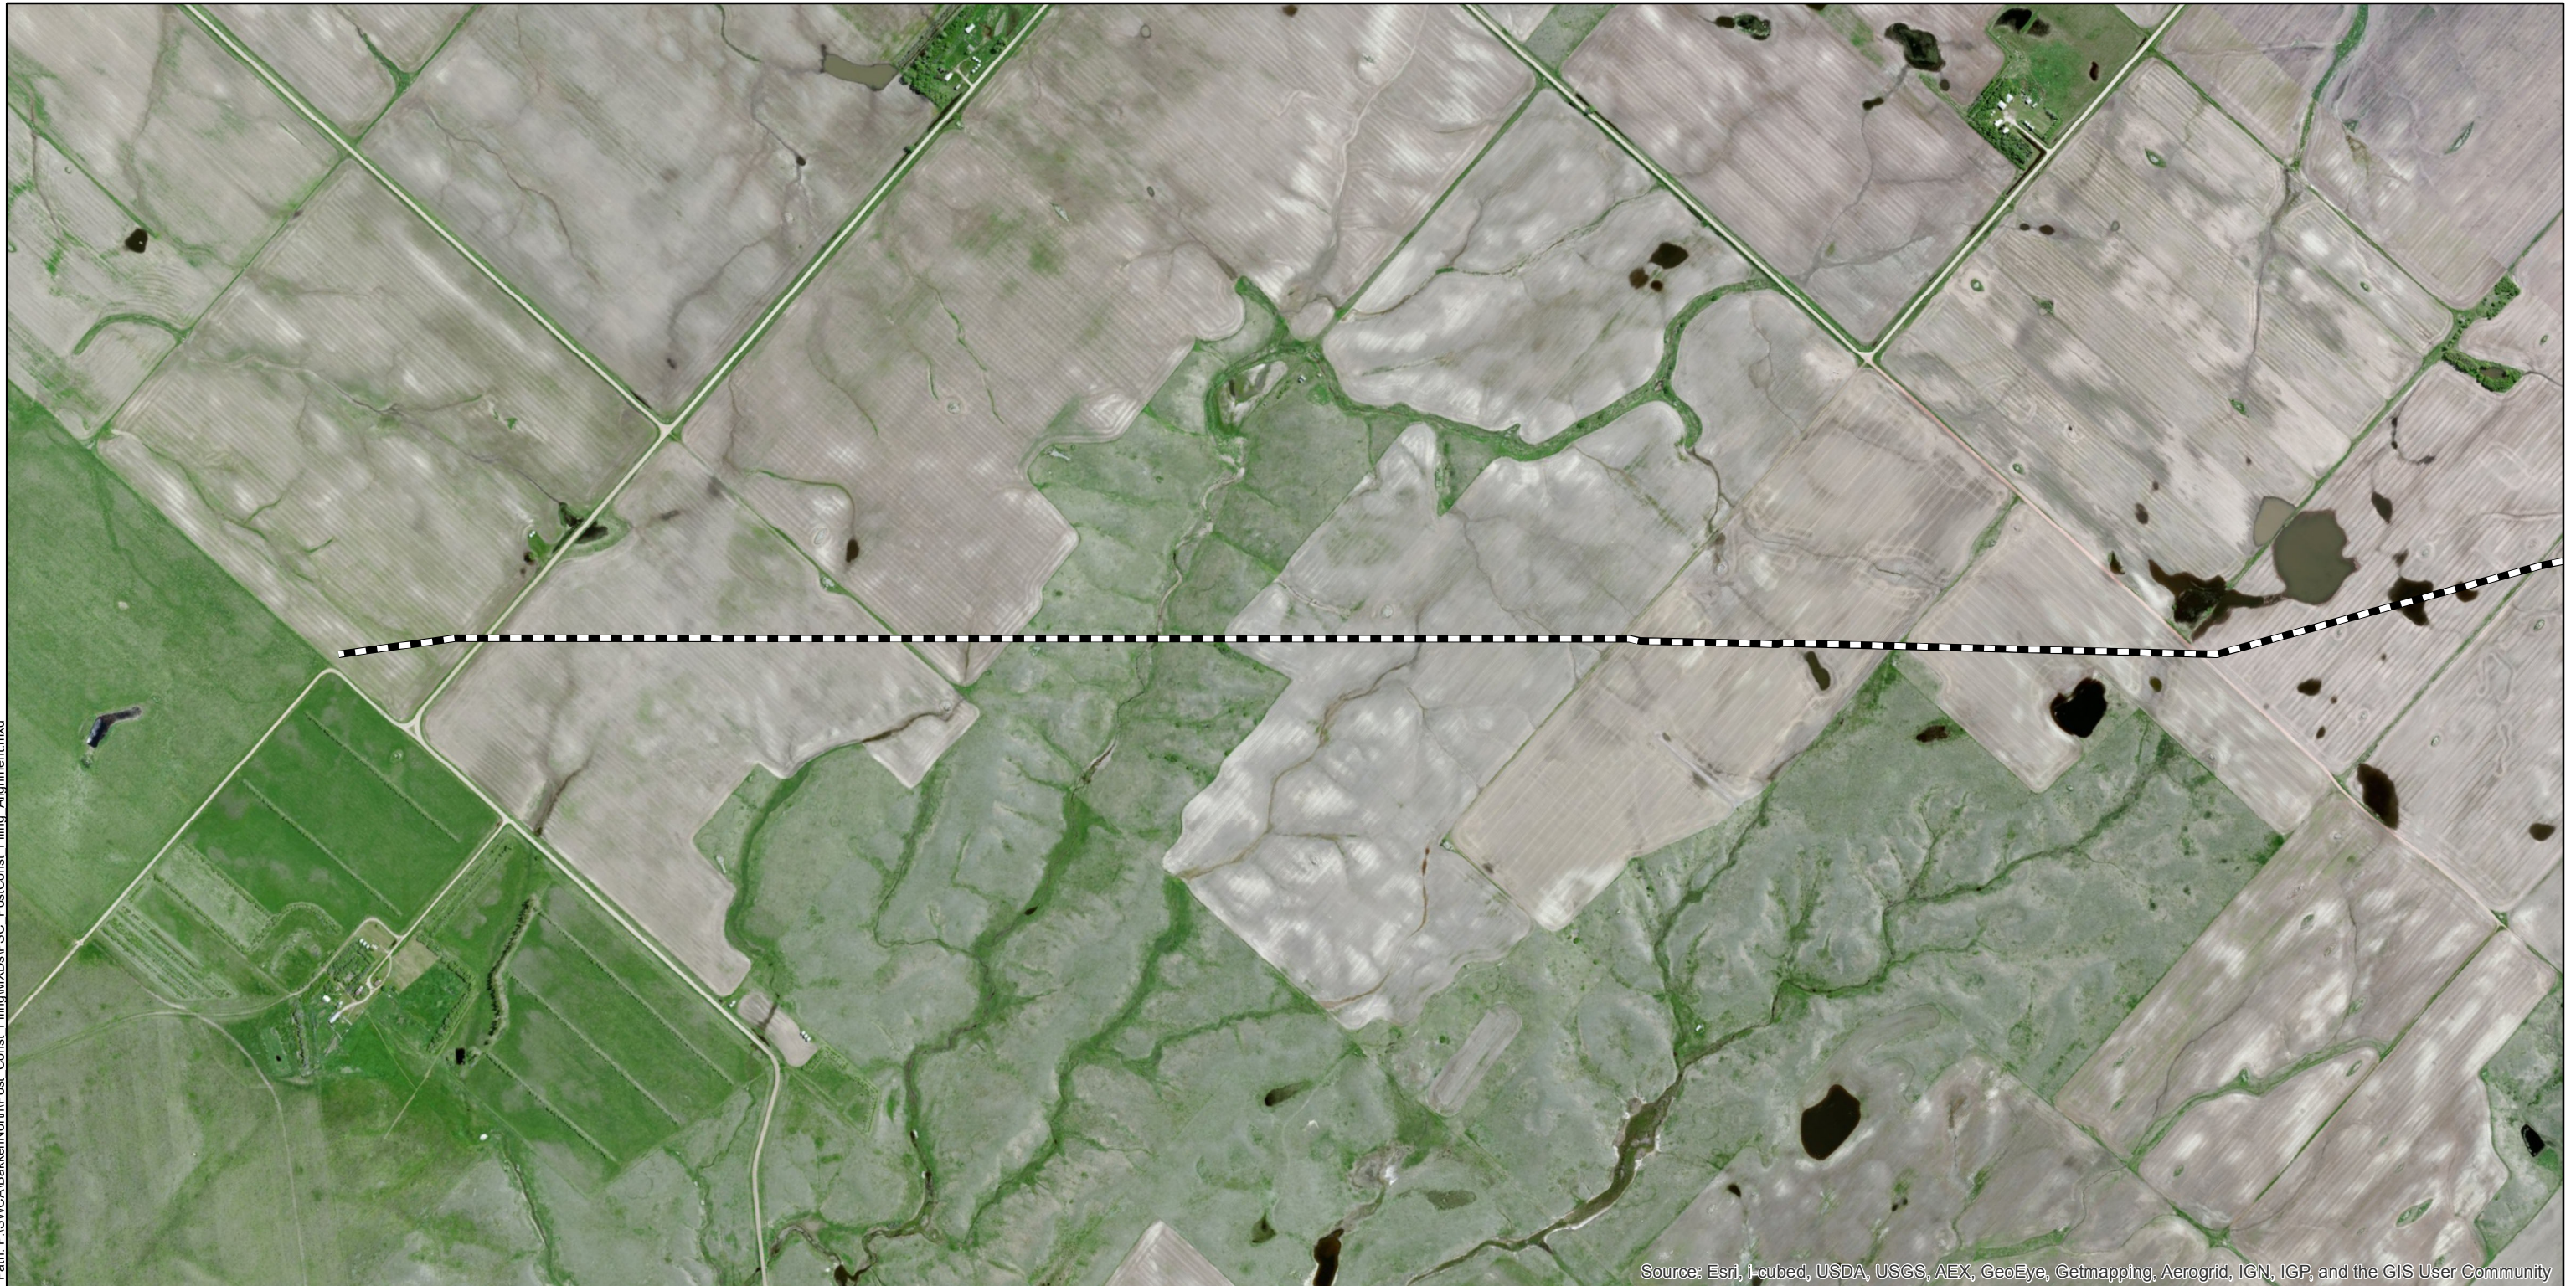


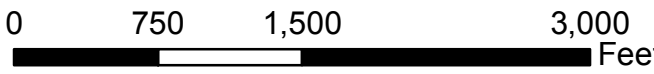
Source: Esri, i-cubed, USDA, USGS, AEX, GeoEye, Getmapping, Aerogrid, IGN, IGP, and the GIS User Community


Author: TTD  
Date: 4/5/2013

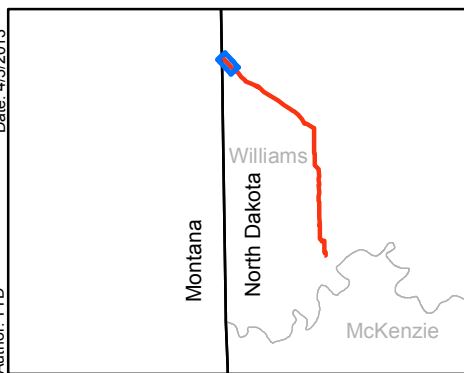


 Bakken North As-Built Alignment



  
1:12,000





**Bakken North**  
PCS Post Construction Filing  
As-Built Alignment

Docket No. PU-10-630  
Route Permit No. 136


Map 1 of 14  
Williams County, ND





Path: P:\SWCA\BakkenNorth\Post\_Const\_Filing\MXDs\FSC\_PostConst\_Filing\_Alignment.mxd


Source: Esri, i-cubed, USDA, USGS, AEX, GeoEye, Getmapping, Aerogrid, IGN, IGP, and the GIS User Community

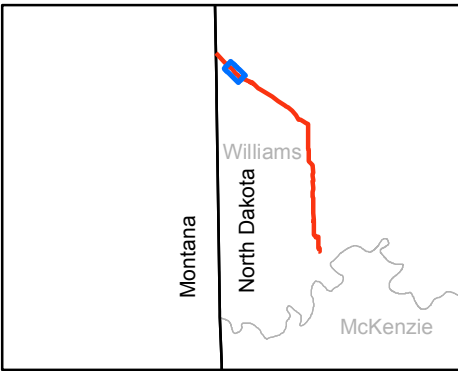
Author: TTD  
Date: 4/5/2013




 Bakken North As-Built Alignment








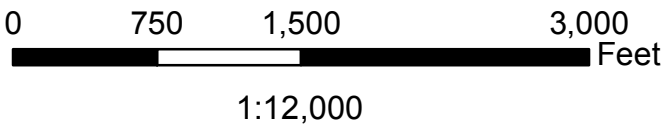

**Bakken North**  
 PCS Post Construction Filing  
 As-Built Alignment

Docket No. PU-10-630  
 Route Permit No. 136


Map 2 of 14  
 Williams County, ND

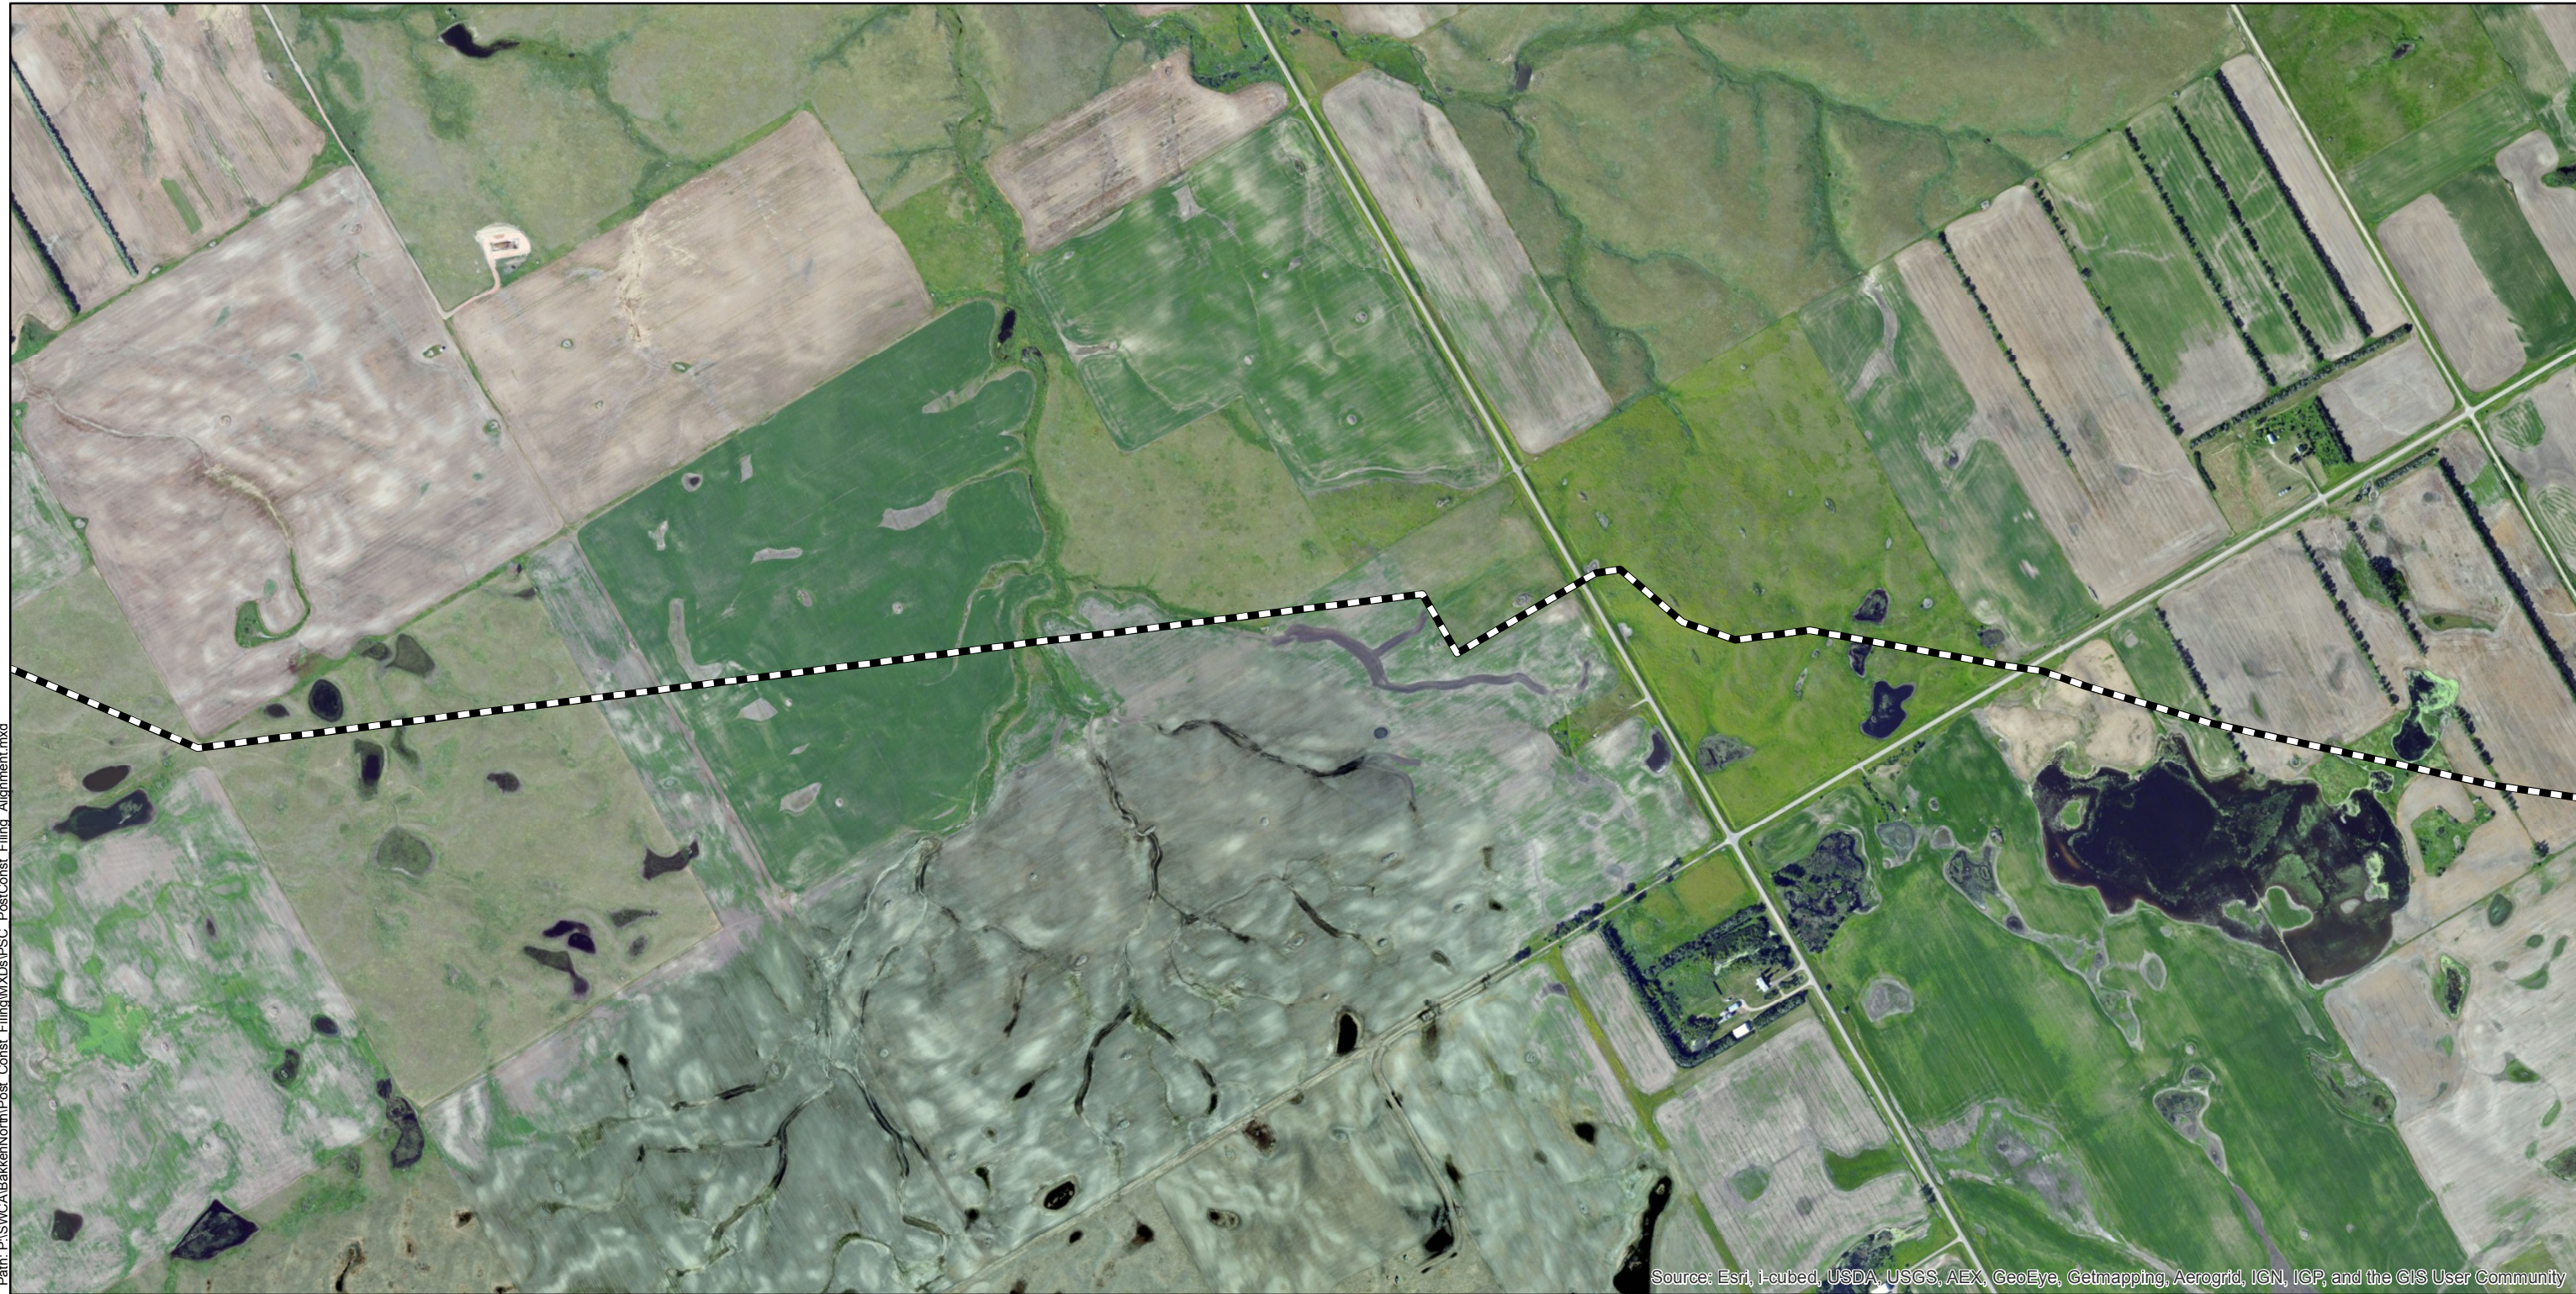



Path: P:\SWCA\BakkenNorth\Post\_Const\_Filing\MXDs\FSC\_PostConst\_Filing\_Alignment.mxd


Source: Esri, I-cubed, USDA, USGS, AEX, GeoEye, Getmapping, Aerogrid, IGN, IGP, and the GIS User Community

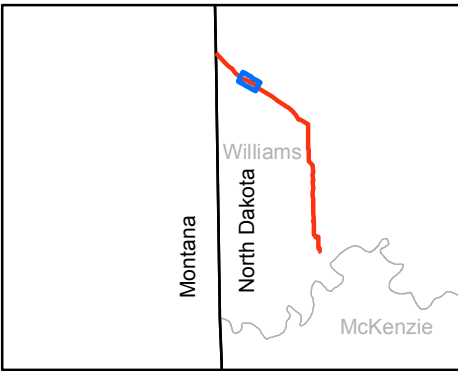
Author: TTD Date: 4/5/2013




 Bakken North As-Built Alignment







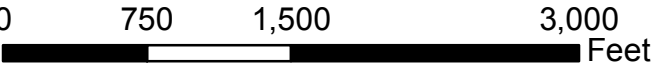

1:12,000

**Bakken North**  
 PCS Post Construction Filing  
 As-Built Alignment

Docket No. PU-10-630  
 Route Permit No. 136

Map 3 of 14  
 Williams County, ND





Path: P:\SWCA\BakkenNorth\Post\_Const\_Filing\MXDs\FSC\_PostConst\_Filing\_Alignment.mxd


Source: Esri, i-cubed, USDA, USGS, AEX, GeoEye, Getmapping, Aerogrid, IGN, IGP, and the GIS User Community


Date: 4/5/2013  
Author: TTD




 Bakken North As-Built Alignment




**Enhancing Execution  
with Experience**


**PLAINS**  
ALL AMERICAN  
PIPELINE, L.P.

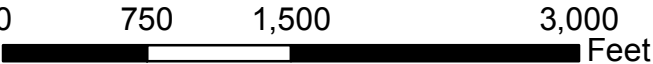
 0 750 1,500 3,000 Feet

1:12,000

**Bakken North**  
 PCS Post Construction Filing  
 As-Built Alignment


Docket No. PU-10-630  
 Route Permit No. 136


Map 4 of 14  
 Williams County, ND





Path: P:\SWCA\BakkenNorth\Post Const. Filing\MXDs\FSC\_PostConst\_Filing\_Alignment.mxd

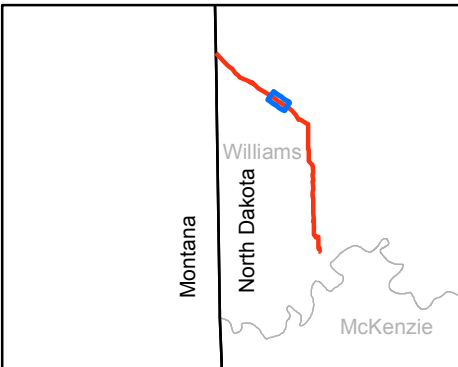
Author: TTD Date: 4/5/2013




 Bakken North As-Built Alignment







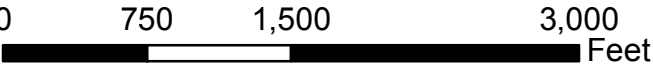

1:12,000

**Bakken North**  
 PCS Post Construction Filing  
 As-Built Alignment

Docket No. PU-10-630  
 Route Permit No. 136


Map 5 of 14  
 Williams County, ND


Path: P:\SWCA\BakkenNorth\Post Const. Filing\MXDs\FSC\_PostConst\_Filing\_Alignment.mxd




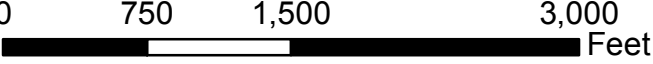
Source: Esri, i-cubed, USDA, USGS, AEX, GeoEye, Getmapping, Aerogrid, IGN, IGP, and the GIS User Community

Author: TTD Date: 4/5/2013

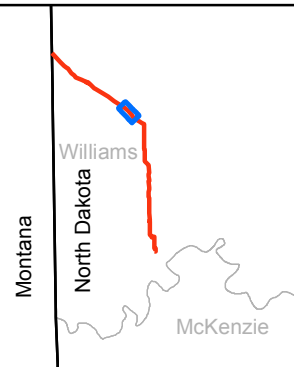



 Bakken North As-Built Alignment



 0 750 1,500 3,000 Feet

1:12,000

 Enhancing Execution with Experience



**Bakken North**  
 PCS Post Construction Filing  
 As-Built Alignment

Docket No. PU-10-630  
 Route Permit No. 136


Map 6 of 14  
 Williamsl County, ND


Path: P:\SWCA\BakkenNorth\Post Const. Filing\MXDs\FSC\_PostConst\_Filing\_Alignment.mxd





Source: Esri, i-cubed, USDA, USGS, AEX, GeoEye, Getmapping, Aerogrid, IGN, IGP, and the GIS User Community


Author: TTD Date: 4/5/2013

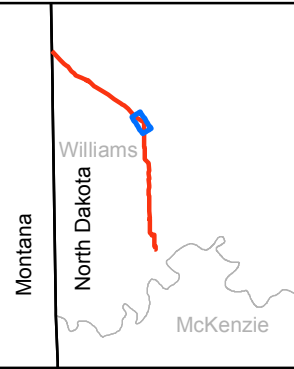

 Bakken North As-Built Alignment

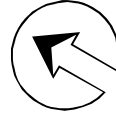





0 750 1,500 3,000 Feet  
 1:12,000

**Bakken North**  
 PCS Post Construction Filing  
 As-Built Alignment

Docket No. PU-10-630  
 Route Permit No. 136


Map 7 of 14  
 Williamsl County, ND


Path: P:\SWCA\BakkenNorth\Post Const. Filing\MXDs\FSC\_PostConst\_Filing\_Alignment.mxd





Source: Esri, i-cubed, USDA, USGS, AEX, GeoEye, Getmapping, Aerogrid, IGN, IGP, and the GIS User Community

Author: TTD Date: 4/5/2013

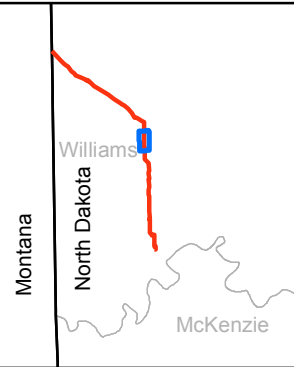

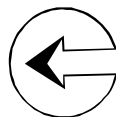

 Bakken North As-Built Alignment

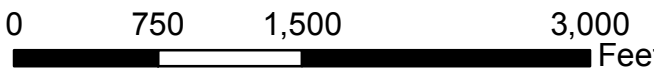

  
0 750 1,500 3,000 Feet

1:12,000

 Enhancing Execution with Experience

 **PLAINS**  
ALL AMERICAN  
PIPELINE, L.P.

**Bakken North**  
PCS Post Construction Filing  
As-Built Alignment

Docket No. PU-10-630  
Route Permit No. 136


Map 8 of 14  
Williams County, ND


Path: P:\SWCA\BakkenNorth\Post Const. Filing\MXDs\FSC\_PostConst\_Filing\_Alignment.mxd




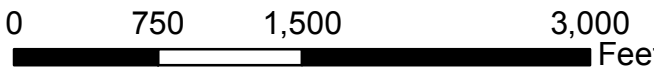
Source: Esri, i-cubed, USDA, USGS, AEX, GeoEye, Getmapping, Aerogrid, IGN, IGP, and the GIS User Community

Author: TTD  
Date: 4/5/2013

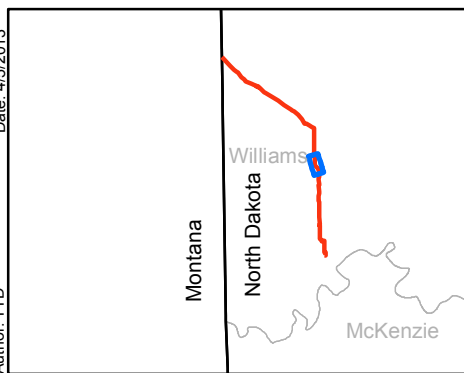



 Bakken North As-Built Alignment





1:12,000





**Bakken North**  
 PCS Post Construction Filing  
 As-Built Alignment

Docket No. PU-10-630  
 Route Permit No. 136


Map 9 of 14  
 Williams County, ND


Path: P:\SWCA\BakkenNorth\Post Const. Filing\MXDs\FSC\_PostConst\_Filing\_Alignment.mxd





Source: Esri, i-cubed, USDA, USGS, AEX, GeoEye, Getmapping, Aerogrid, IGN, IGP, and the GIS User Community


Author: TTD  
Date: 4/5/2013

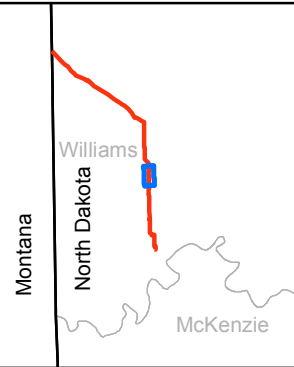

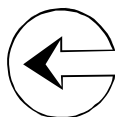

**Bakken North As-Built Alignment**

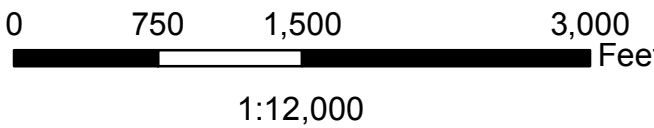




**Enhancing Execution  
with Experience**


**PLAINS  
ALL AMERICAN  
PIPELINE, L.P.**

**Bakken North**  
 PCS Post Construction Filing  
 As-Built Alignment

Docket No. PU-10-630  
 Route Permit No. 136

Map 10 of 14  
 Williamsl County, ND




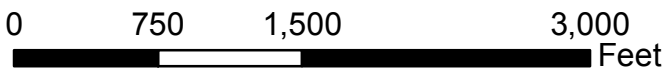
Path: P:\SWCA\BakkenNorth\Post Const. Filing\MXDs\FSC PostConst. Filing Alignment.mxd


Source: Esri, i-cubed, USDA, USGS, AEX, GeoEye, Getmapping, Aerogrid, IGN, IGP, and the GIS User Community





Author: TTD  
Date: 4/5/2013


**Bakken North As-Built Alignment**

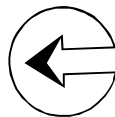
  
 0 750 1,500 3,000 Feet  
 1:12,000




  
 Enhancing Execution  
 with Experience


  
**PLAINS**  
 ALL AMERICAN  
 PIPELINE, L.P.

**Bakken North**  
 PCS Post Construction Filing  
 As-Built Alignment

Docket No. PU-10-630  
 Route Permit No. 136


Map 11 of 14  
 Williamsl County, ND




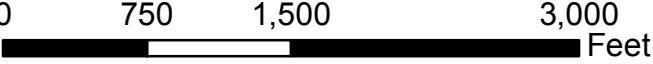
Path: P:\SWCA\BakkenNorth\Post\_Const\_Filing\MXDs\FSC\_PostConst\_Filing\_Alignment.mxd


Source: Esri, i-cubed, USDA, USGS, AEX, GeoEye, Getmapping, Aerogrid, IGN, IGP, and the GIS User Community


Author: TTD  
Date: 4/5/2013

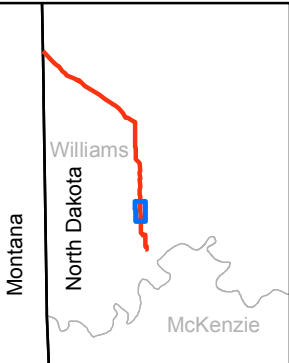


 Bakken North As-Built Alignment


  
 0 750 1,500 3,000 Feet







**Bakken North**  
 PCS Post Construction Filing  
 As-Built Alignment

Docket No. PU-10-630  
 Route Permit No. 136


Map 12 of 14  
 Williams County, ND



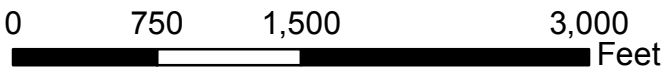
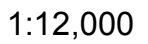


Path: P:\SWCA\BakkenNorth\Post\_Const\_Filing\MXDs\FSC\_PostConst\_Filing\_Alignment.mxd



Source: Esri, i-cubed, USDA, USGS, AEX, GeoEye, Getmapping, Aerogrid, IGN, IGP, and the GIS User Community

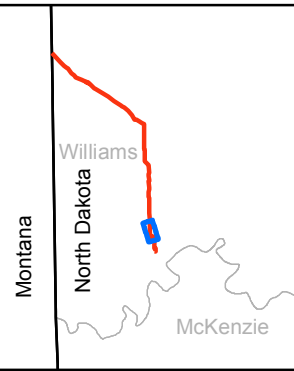Author: TTD  
Date: 4/5/2013

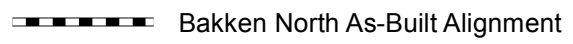


**Bakken North**  
 PCS Post Construction Filing  
 As-Built Alignment  
  
 Docket No. PU-10-630  
 Route Permit No. 136  
  
 Map 13 of 14  
 Williams County, ND


Path: P:\SWCA\BakkenNorth\Post\_Const\_Filing\MXDs\FSC\_PostConst\_Filing\_Alignment.mxd





Source: Esri, i-cubed, USDA, USGS, AEX, GeoEye, Getmapping, Aerogrid, IGN, IGP, and the GIS User Community

Author: TTD Date: 4/5/2013

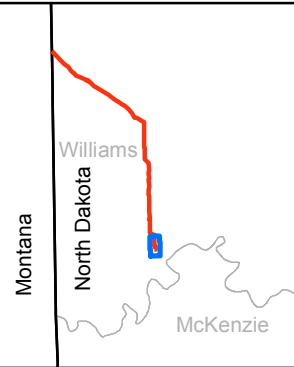

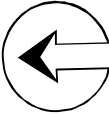

 Bakken North As-Built Alignment

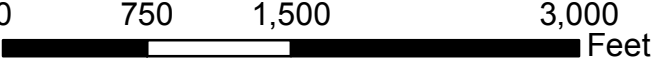

  
0 750 1,500 3,000 Feet

1:12,000

 Enhancing Execution with Experience

 **PLAINS**  
ALL AMERICAN  
PIPELINE, L.P.

**Bakken North**  
PCS Post Construction Filing  
As-Built Alignment

Docket No. PU-10-630  
Route Permit No. 136

Map 14 of 14  
Williams County, ND