


- EXTERNAL REFERENCE:**
- 34331007-BASE-C3D-DESIGN-ROADS-AS-BUILT.DWG
 - Bison3NE_FSA2010.JPG
 - Bison3NW_FSA2010.JPG
 - Bison3SE_FSA2010.JPG
 - Bison3SW_FSA2010.JPG

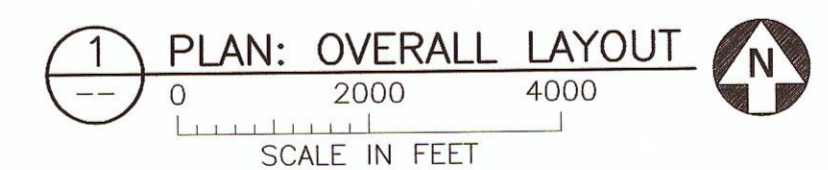

NO.	BY	CHK	APP.	DATE	REVISION DESCRIPTION
A	DMD	CAD	JXB	05/27/11	60 PERCENT SUBMITAL
B	CAD	CAD	JXB	07/01/11	90 PERCENT SUBMITAL
O	DMD	CAD	JXB	08/12/11	ISSUED FOR CONSTRUCTION
1	NUJ			2/13/13	CONSTRUCTION REVISIONS

MATTHEW FREUDENREICH
 LICENSE NO. 1252
 STATE OF NORTH DAKOTA

CLIENT	BID	CONSTRUCTION	PERMITTING	RECORD
16/27/11 07/01/11			06/12/11	

BARR
 Project Office:
 BARR ENGINEERING CO.
 4700 WEST 77TH STREET
 MINNEAPOLIS, MN.
 55435-4803
 Ph: 1-800-632-2277
 Fax: (952) 832-2601
 www.barr.com

Scale	Date	Drawn	Checked	Designed	Approved
AS SHOWN	05/20/11	DMD	JXB	CAD	JXB

BISON
 A WIND ENERGY INITIATIVE OF MINNESOTA POWER IN NORTH DAKOTA

BISON 2 WIND PROJECT
 MORTON & OLIVER COUNTIES, NORTH DAKOTA
OVERALL SITE PLAN AND SHEET LAYOUT

BARR PROJECT No. 34/33-1007	
CLIENT PROJECT No.	
DWG. No. C-02	REV. No. 1