




1 PLAN: ALIGNMENT A1

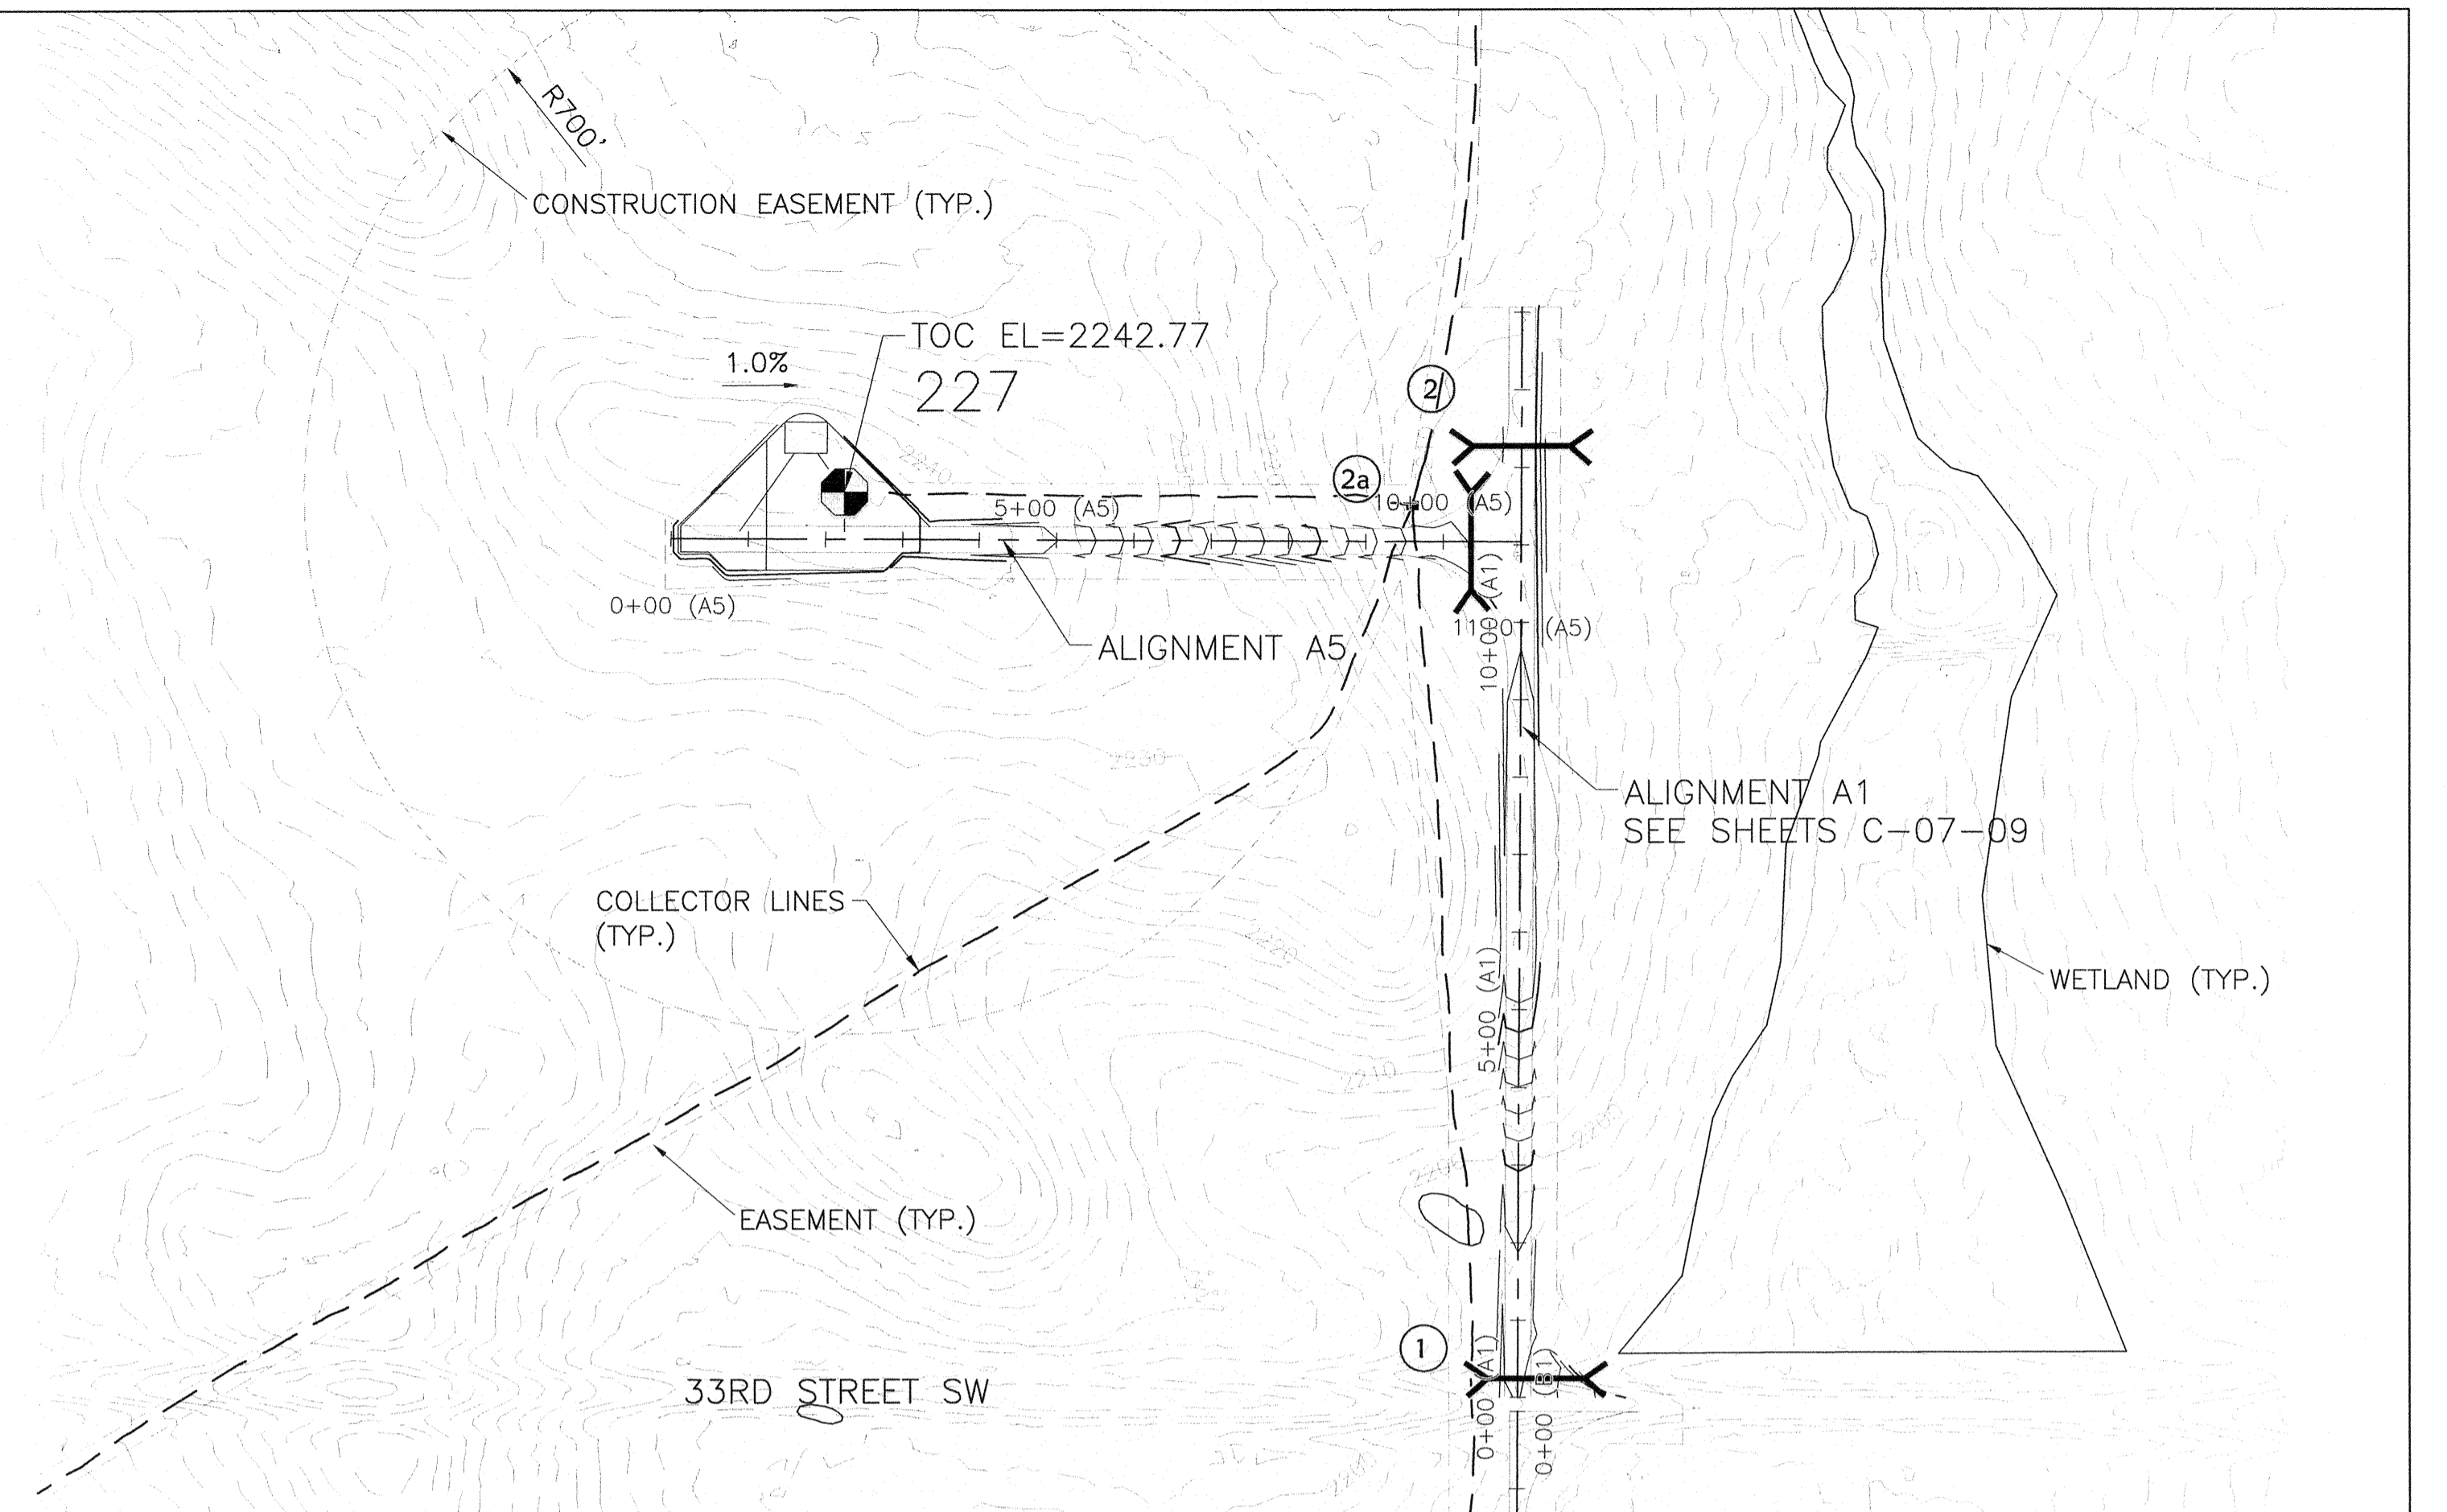

3 PLAN: ALIGNMENT A5

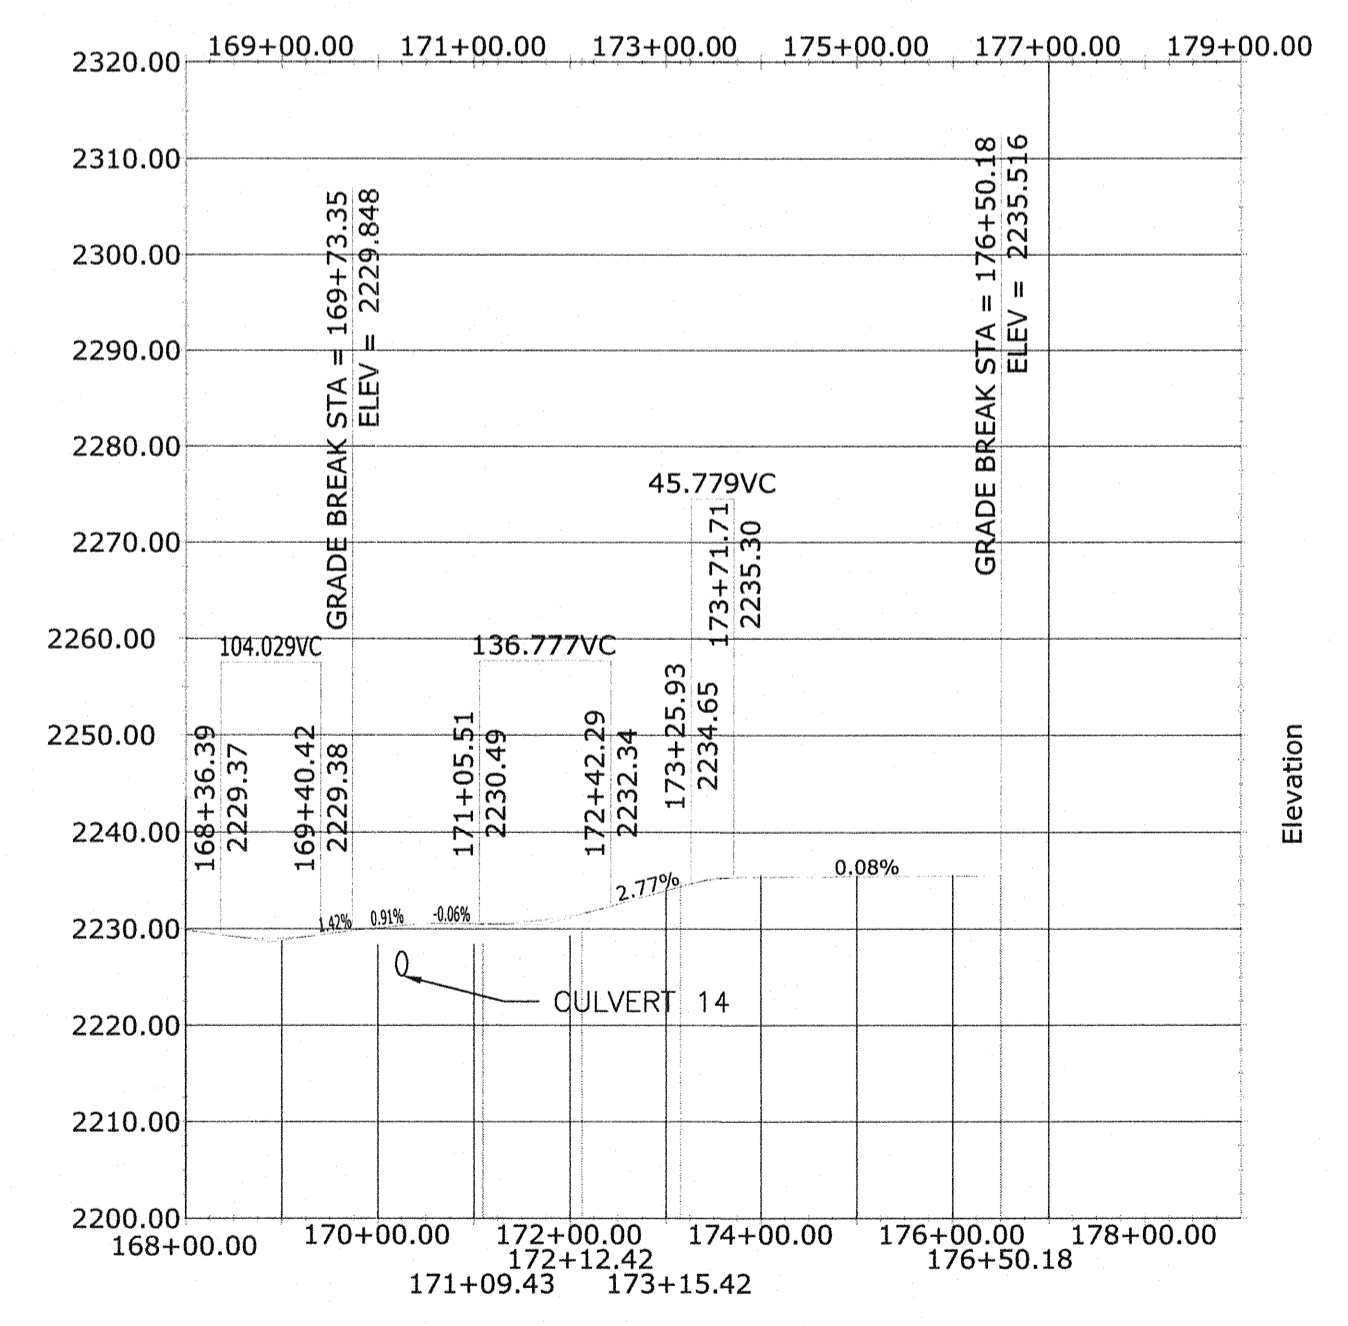


2 PROFILE: ALIGNMENT A1

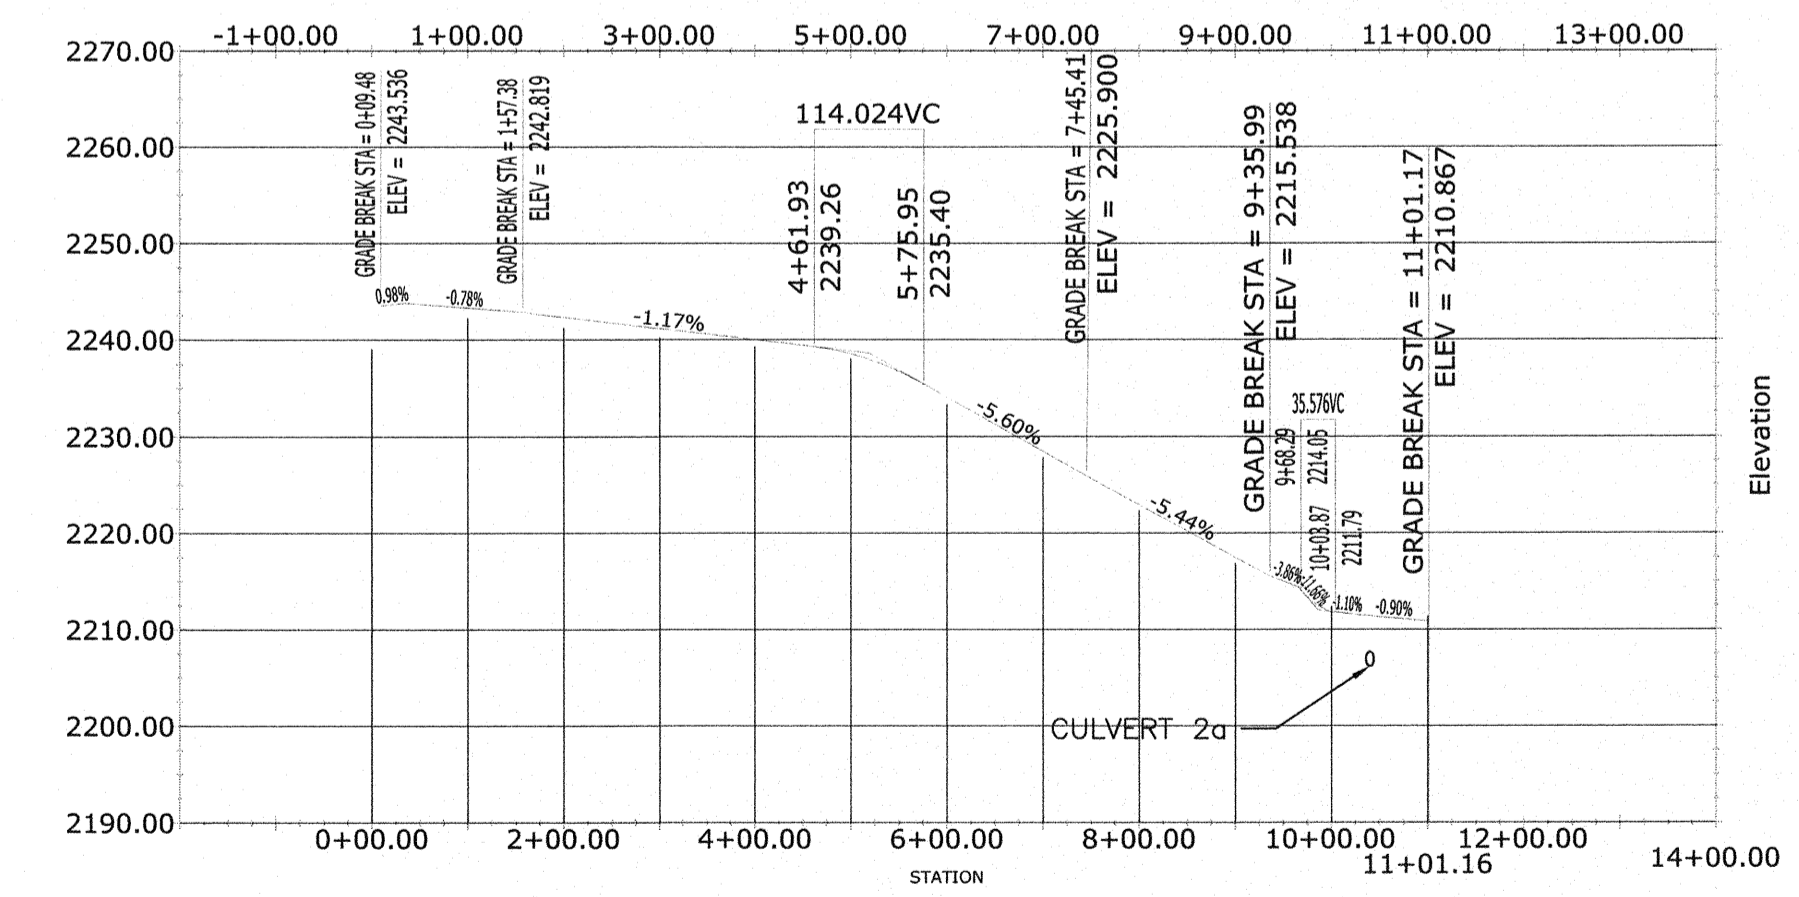

2 PROFILE: ALIGNMENT A5

EXTERNAL REFERENCE:
34331007-BASE-C3D-DESIGN-ROADS-AS-BUILT.DWG


A	DMD	CAD	JXB	05/27/11	60 PERCENT SUBMITTAL
B	CAD	CAD	JXB	07/01/11	90 PERCENT SUBMITTAL
0	DMD	CAD	JXB	08/12/11	ISSUED FOR CONSTRUCTION
1	NJG			2/27/13	CONSTRUCTION REVISIONS
NO.	BY	CHK.	APP.	DATE	REVISION DESCRIPTION

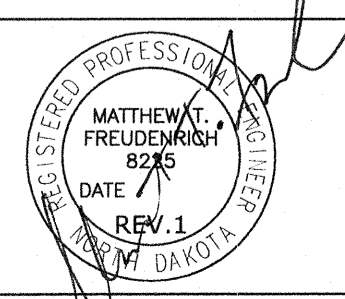

CLIENT	05/27/11	07/01/11				
BID						
CONSTRUCTION			08/12/11			
PERMITTING						
RECORD						
RELEASED TO/FOR	A	B	C	0	1	2
DATE RELEASED						

Project Office:
BARR ENGINEERING CO.
4700 WEST 77TH STREET
MINNEAPOLIS, MN.
55435-4803
Ph: 1-800-632-2277
Fax: (952) 832-2601
www.barr.com

Scale	AS SHOWN
Date	05/20/11
Drawn	DMD
Checked	JXB
Designed	CAD
Approved	JXB

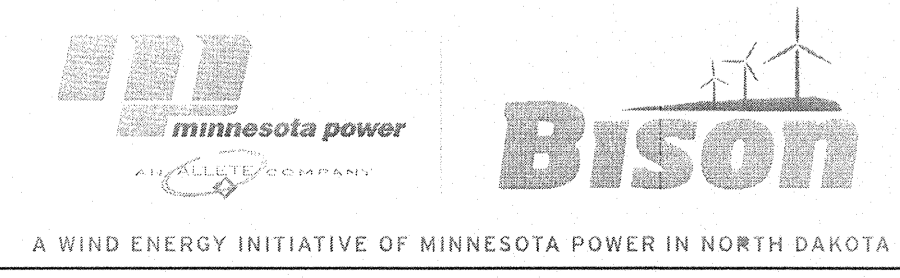

BISON 2 WIND PROJECT
MORTON & OLIVER COUNTIES, NORTH DAKOTA
PLAN AND PROFILE - ALIGNMENTS A1- STA.
168+00 TO 176+50 - A5 STA.0+00 TO 11+01

BARR PROJECT No.	34/33-1007
CLIENT PROJECT No.	
DWG. No.	C-10
REV. No.	1