



1 PLAN: ALIGNMENT A6
 SCALE IN FEET

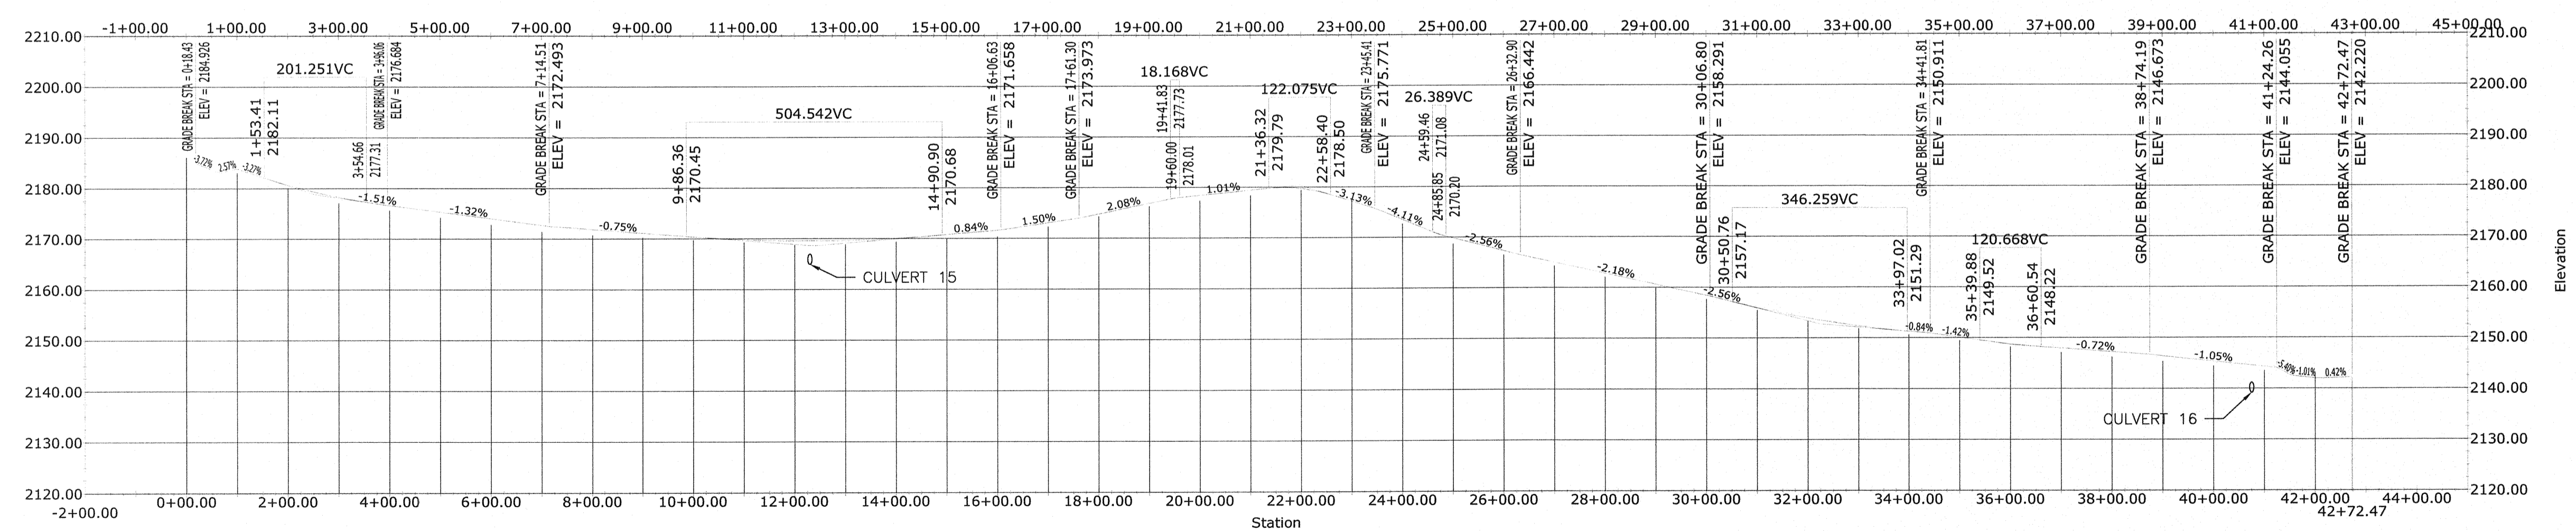

2 PROFILE: ALIGNMENT A6
 HORIZONTAL SCALE IN FEET VERTICAL SCALE IN FEET

EXTERNAL REFERENCE:
 34331007-BASE-C3D-DESIGN-ROADS-AS-BUILT.DWG


NO.	BY	CHK	APP.	DATE	REVISION DESCRIPTION
A	DMD	CAD	JXB	05/27/11	60 PERCENT SUBMITTAL
B	CAD	CAD	JXB	07/01/11	90 PERCENT SUBMITTAL
C	DMD	CAD	JXB	08/12/11	ISSUED FOR CONSTRUCTION
1	NJG			2/27/13	CONSTRUCTION REVISIONS

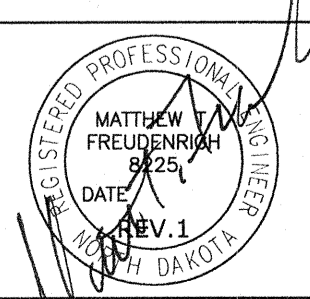

CLIENT	05/27/10/01/11
BID	
CONSTRUCTION	08/12/11
PERMITTING	
RECORD	
RELEASED TO/FOR	A B C 0 1 2 3
DATE RELEASED	

BARR
 Project Office:
 BARR ENGINEERING CO.
 4700 WEST 77TH STREET
 MINNEAPOLIS, MN.
 55435-4803
 Ph: 1-800-632-2277
 Fax: (952) 832-2601
 www.barr.com

Scale	AS SHOWN
Date	05/20/11
Drawn	DMD
Checked	JXB
Designed	CAD
Approved	JXB

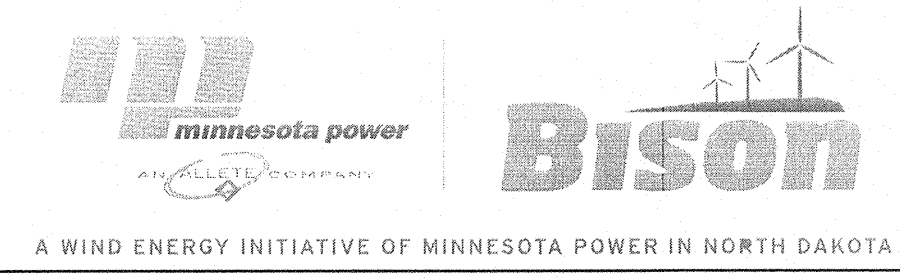

BISON 2 WIND PROJECT
 MORTON & OLIVER COUNTIES, NORTH DAKOTA
 PLAN AND PROFILE
 ALIGNMENT A6 - STA. 0+00 TO 42+72

BARR PROJECT No.	34/33-1007
CLIENT PROJECT No.	
DWG. No.	C-11
REV. No.	1