


1 PLAN: ALIGNMENT A7




2 PROFILE: ALIGNMENT A7

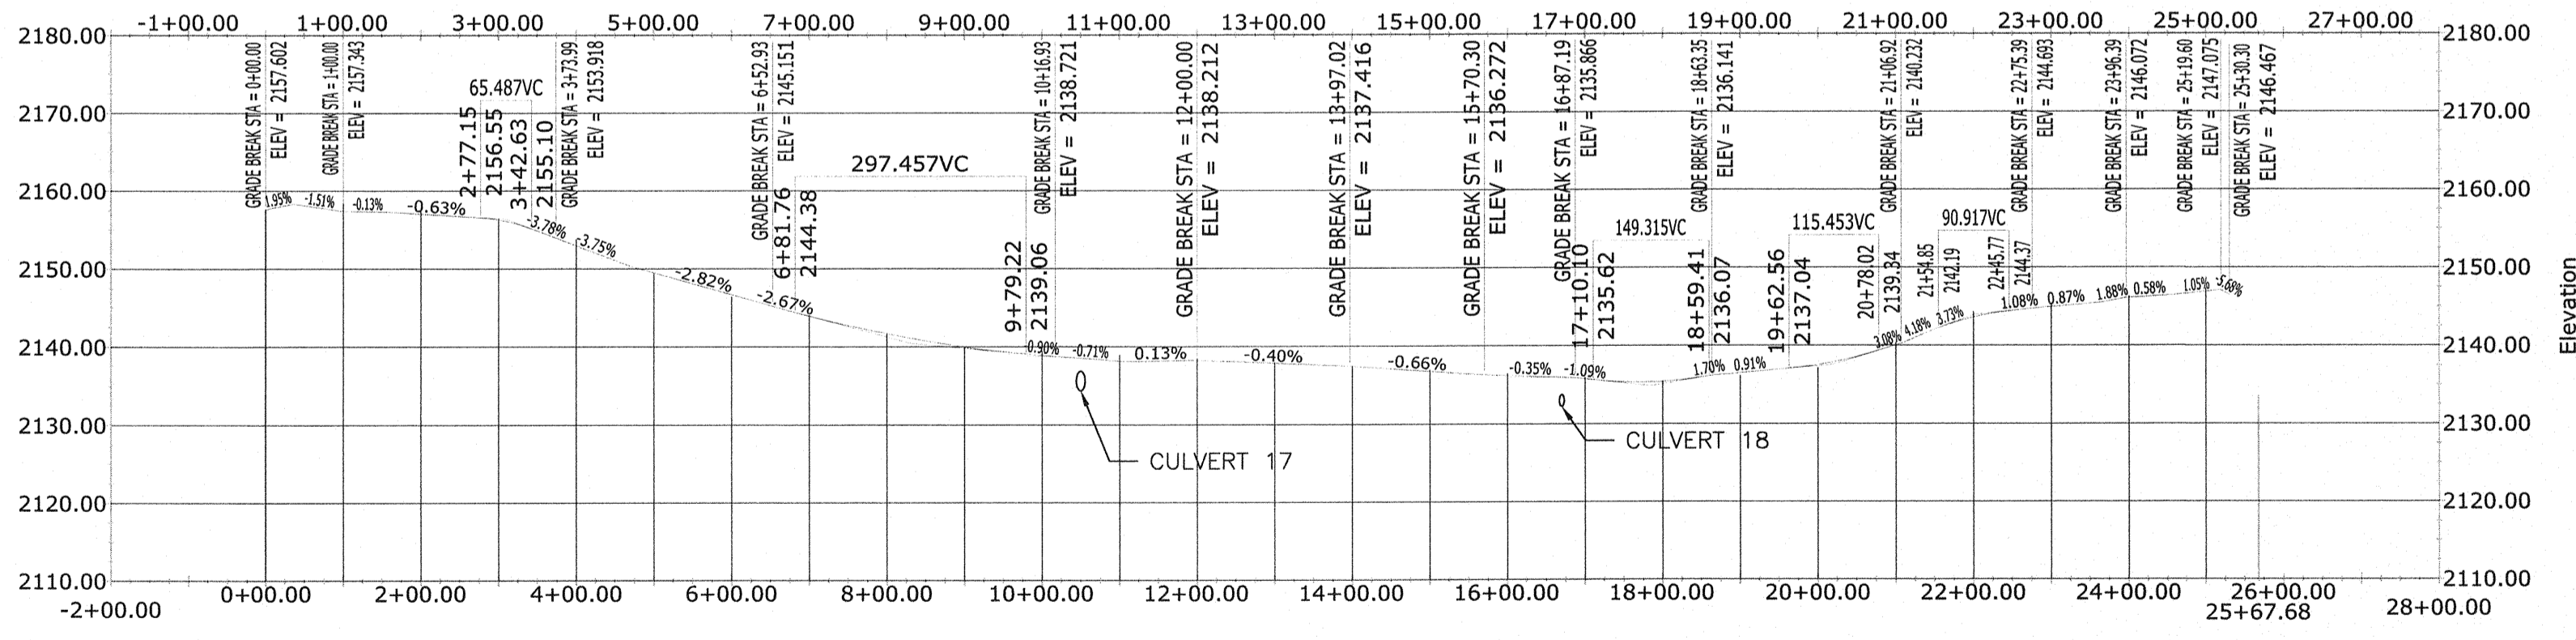

EXTERNAL REFERENCE:  
34331007-BASE-C3D-DESIGN-ROADS-AS-BUILT.DWG


NO.	BY	CHK	APP.	DATE	REVISION DESCRIPTION
A	DMD	CAD	JXB	05/27/11	60 PERCENT SUBMITTAL
B	CAD	CAD	JXB	07/01/11	90 PERCENT SUBMITTAL
0	DMD	CAD	JXB	08/12/11	ISSUED FOR CONSTRUCTION
1	NJG			7/27/12	CONSTRUCTION REVISIONS

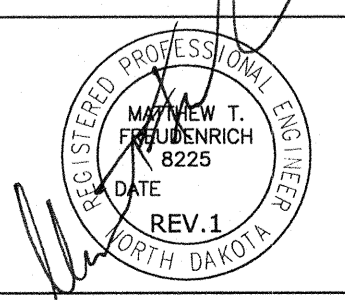

CLIENT	05/27/11 07/01/11
BID	
CONSTRUCTION	08/12/11
PERMITTING	
RECORD	
RELEASED TO/FOR	A B C 0 1 2 3
DATE RELEASED	

**BARR**  
Project Office:  
BARR ENGINEERING CO.  
4700 WEST 77TH STREET  
MINNEAPOLIS, MN.  
55435-4803  
Corporate Headquarters:  
Minneapolis, Minnesota  
Ph: 1-800-632-2277  
Fax: (952) 832-2601  
www.barr.com

Scale	AS SHOWN
Date	05/20/11
Drawn	DMD
Checked	JXB
Designed	CAD
Approved	JXB

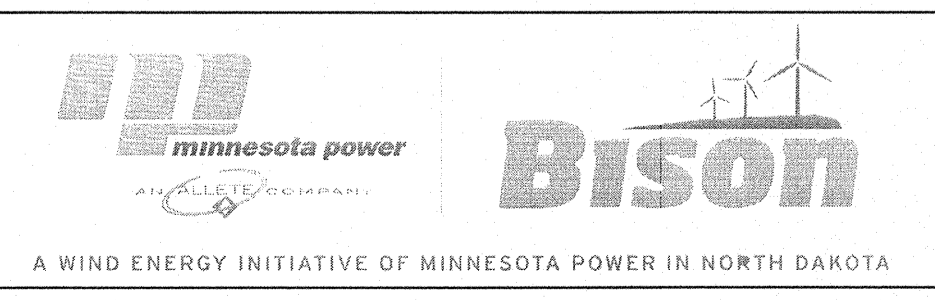

**BISON 2 WIND PROJECT**  
MORTON & OLIVER COUNTIES, NORTH DAKOTA  
PLAN AND PROFILE  
ALIGNMENT A7 STA. 0+00 TO 25+68

BARR PROJECT No.	34/33-1007
CLIENT PROJECT No.	
DWG. No.	C-12
REV. No.	1