



1 PLAN: ALIGNMENT B1

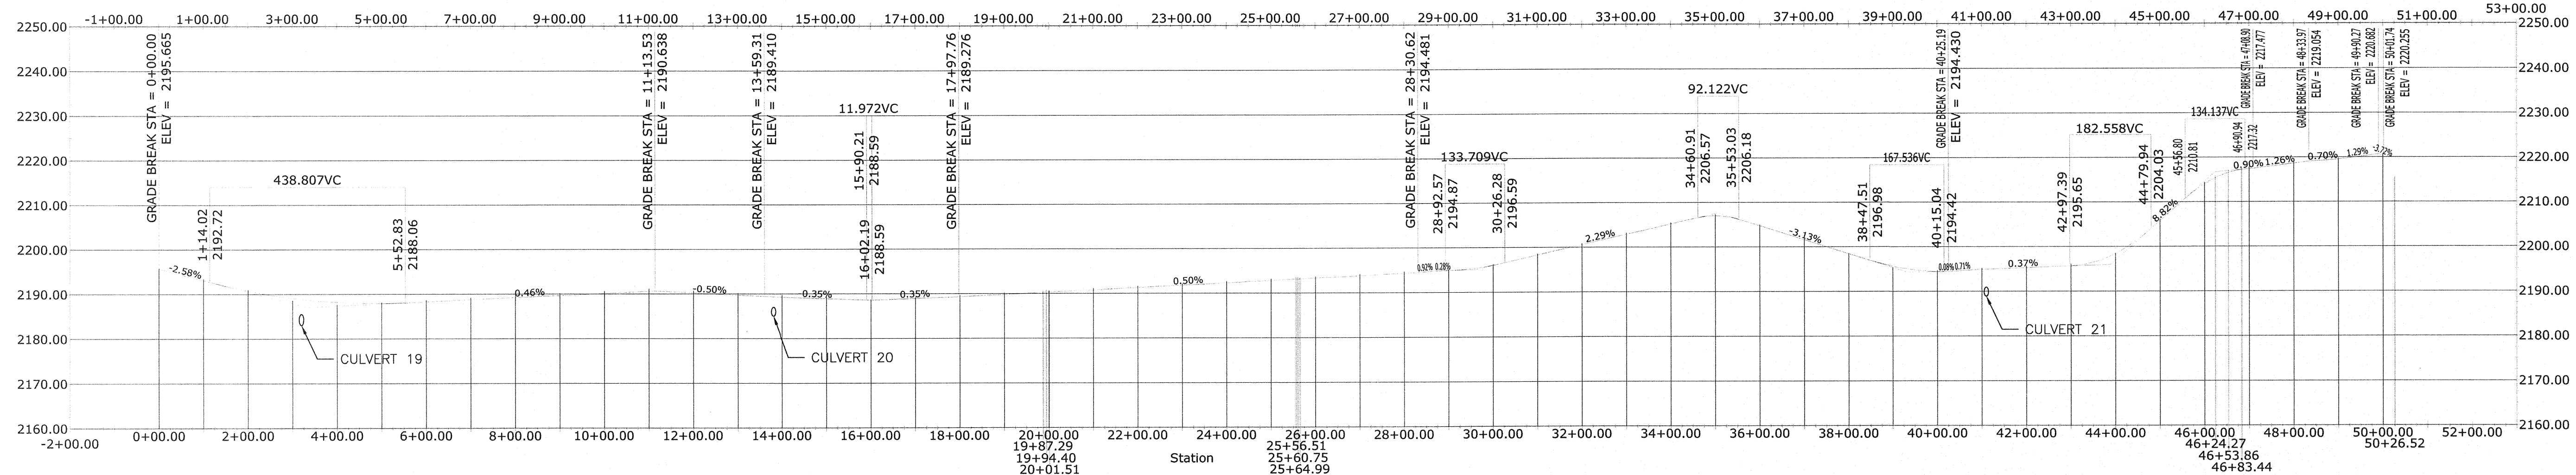

2 PROFILE: ALIGNMENT B1

EXTERNAL REFERENCE:
34331007-BASE-C3D-DESIGN-ROADS-AS-BUILT.DWG

NO.	BY	CHK	APP.	DATE	REVISION DESCRIPTION
A	DMD	CAD	JXB	05/27/11	60 PERCENT SUBMITTAL
B	CAD	CAD	JXB	07/01/11	90 PERCENT SUBMITTAL
0	DMD	CAD	JXB	08/12/11	ISSUED FOR CONSTRUCTION
1	NJG			2/27/13	CONSTRUCTION REVISIONS

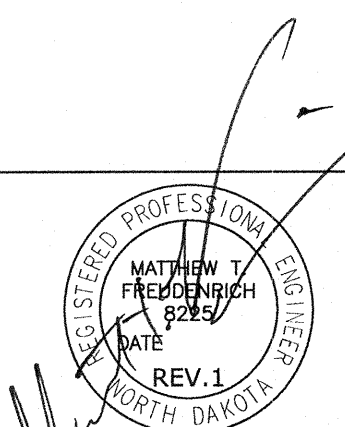


CLIENT	BID	CONSTRUCTION	PERMITTING	RECORD	RELEASED TO/FOR	DATE RELEASED
05/27/10/01/11			08/12/11		A B C 0 1 2 3	

BARR

Project Office:
BARR ENGINEERING CO.
4700 WEST 77TH STREET
MINNEAPOLIS, MN.
55435-4803

Corporate Headquarters:
Minneapolis, Minnesota
Ph: 1-800-632-2277

Scale	AS SHOWN
Date	05/20/11
Drawn	DMD
Checked	JXB
Designed	CAD
Approved	JXB

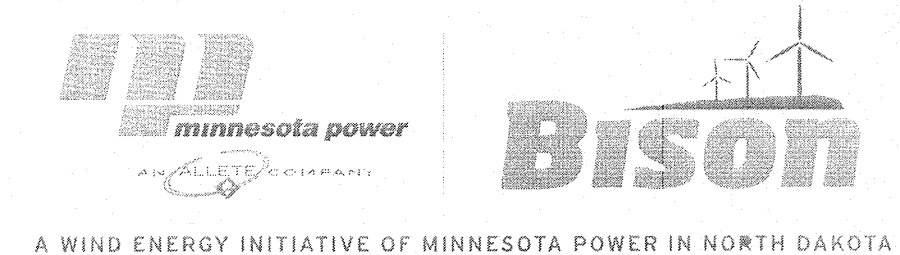

BISON 2 WIND PROJECT
MORTON & OLIVER COUNTIES, NORTH DAKOTA

PLAN AND PROFILE
ALIGNMENT B1 - STA. 0+00 TO 50+27

BARR PROJECT No.	CLIENT PROJECT No.	DWG. No.	REV. No.
34/33-1007		C-13	1